

JM2685 Bkt Beruntung.

No. Fard

Rajah di muka

No. Fard		Rajah di muka		Rajah di muka	
Datum Sanipadu		1 8/2823 2 4	65.781		65.781
pkB Az Ak. pkB Ag 625					
2 8/2823 26/2823 209 1708 1 209 1708 3 4			109.999		109.999
3 209 1708 29 1708 pkB					
1- 9 899531	1 899531 9 4	91.395	Agk	91.395	
3- 5 1762359	3 1762359 5 4	89.557	Agk	89.557	
3- 6 1729630	3 1729630 6 4	91.190	Agk	91.190	
2 8/2823 26/2823 70 0806 1 70 0806 7 4			69.795		69.795
7 70 0806 250 0806 pkB					
2 Spriti Di Atas 233259 1 23 3259 8 4			29.628		29.628
8 233259 203 3259 pkB					
1 203 3259 23 3259 3585916 8 3585916 9 4			99.079		99.079
9 3585916 1785916 pkB					
8 1785916 3585916 899000 9 899000 10 4			53.299		53.299
9 899000 2899000 pkB					

No. Fail

Rapat di muka

Stasiun	Panjang Kit.	Panjang kawat	Titik	Panjang Mutiara	Re	Lat. Puncak	Jarak	Lat. Akhir	Jarak Mutiara
9	269 90 00	29 40 00	180 19 13	10 180 19 13	7	4	99.950		99.950
10	7	180 19 13	0 19 13						

10	0 19 13	180 19 13	250 08 06	7	250 08 06	/	Sik Liket m/s 35 Rf




10-11	91 28 52	10	91 28 52	11	4	1.328	PL	1.328
9-12	329 16 29	9	329 16 29	12	4	1.205	pk.B	1.205
1-13	72 02 06	1	72 02 06	13	4	65980	pk.B	65980
1-14	21 28 07	1	21 28 07	14	4	21.533	pk.B	21.533

No. Fail

Rajah di muka


Stesen

Pemandangan Km


BAPING 0.000

Pemandangan Km

Rajah

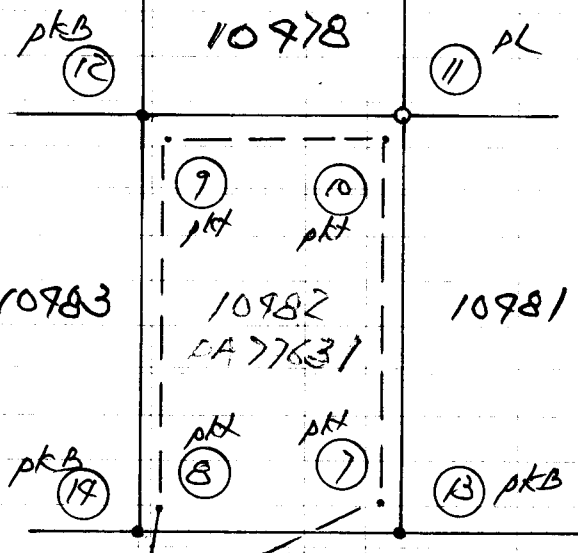

DAERAH HULU SELANGOR
BAUDAR SEREMBAY
SEKSYEN 20
TANDA SKALA

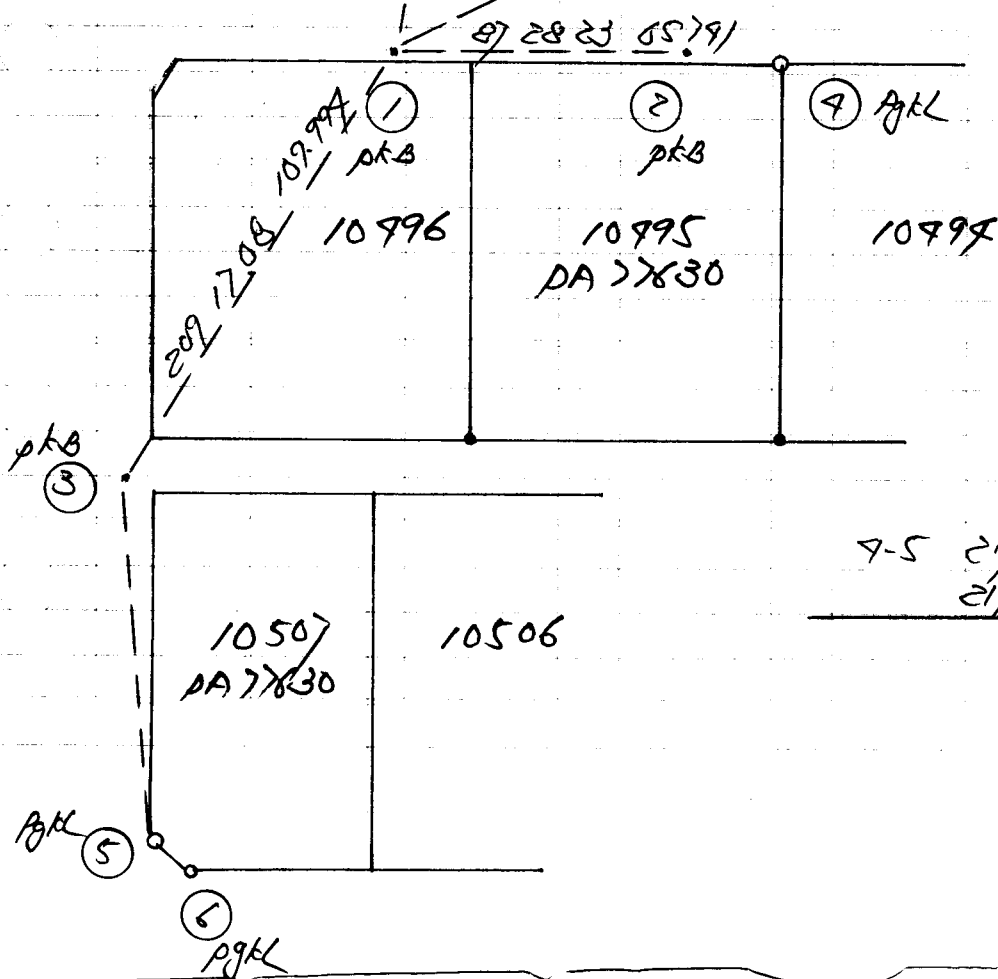

7-5	217	99	36	228.528 N
	217	99	17	228.515 00
			719'	70.43

Location JM 2685

27

Purpose Bkt Bunting.

Horiz. Dist.	Ht. Diff. + or -	RL of Inst.	RL Centre Reading	m	RL Object	Remarks
0.9397					42.8922 - PC	
1.127					42.5039 - TBM JM1	
	1.1856				42.7866 - TBM JM2 (RM)	

All the heights is based on
BM BS119

BM BS119
GPS Level : 28.979
BM Level : 28.891
-0.138

PI/TBM JM2
GPS Level : 42.607
constant : -0.138
42.7866