

No. Fail JM3263 Ternavest.

Rajah di muka

Stesen	BEARING / SUDUT			Dari Stn.	GARISAN		Ke Stn.	Sudut Pugak (±)	Jarak	Suhu	Jarak Antara Tupang	Jarak Mukamat
	Penyilang Kiri	Penyilang Kanan	Purata		Bearing Mukamat							
○	Datum	Daripada		2	156 1690	1	H	59.509				59.509
					A3 Ak.							
					Agn MH							
1	156 1690	336 1690	83 9508	2	83 9508	3	H	173.728				173.728
2												
3	83 95 08	263 9508										
	pkB											
2	263 9508	83 9508	172 5007	3	172 5007	4	H	142.999				142.999
3												
4	172 5007	352 5007										
	pkB											
3	352 5007	172 5007	186 9214	4	186 9214	5	H	116.235				116.235
4												
5	186 9214	6 9214										
	pkB											
4	6 9214	186 9214	272 2095	5	272 2095	6	H	201.450				201.450
5												
6	272 2095	92 2095										
	pkB (stn lama)											
5	92 2095	272 2095	270 1801	6	270 1801	7	H	90.622				90.622
6												
7	270 1801	90 1801										
	pk.L (stn lama)											
7-8	29 4122			7	29 4122	8	H	7.709			pk.L	7.709
7-9	75 5651			7	75 5651	9	H	8.612			pk.L	8.612
67-10	68 3351			67	68 3351	10	H	7.623			pk.L	7.623
67-11	62 4949			67	62 4949	11	H	6.491			78M H2	6.491
4-12	269 4445			4	269 4445	12	H	14.666			pk.L	14.666

JM 3263 Ternavost Kapan

1.8371

3.977 ✓

F2

1.0732

7.2379 ✓

TBM JM1

JMA

1.9088

3.8993 ✓

TBM JM2

TBM H2

GPS Level: 4.371

BM Level: 7.371

Base River Mouth.

TBM H2

(SEC/3229/H2)

RL: 9.371

(BM B600/3)


F2

GPS Level: 3.977

constant: 3.151

BM Level: 3.977

JM3263 Terravest Kapar

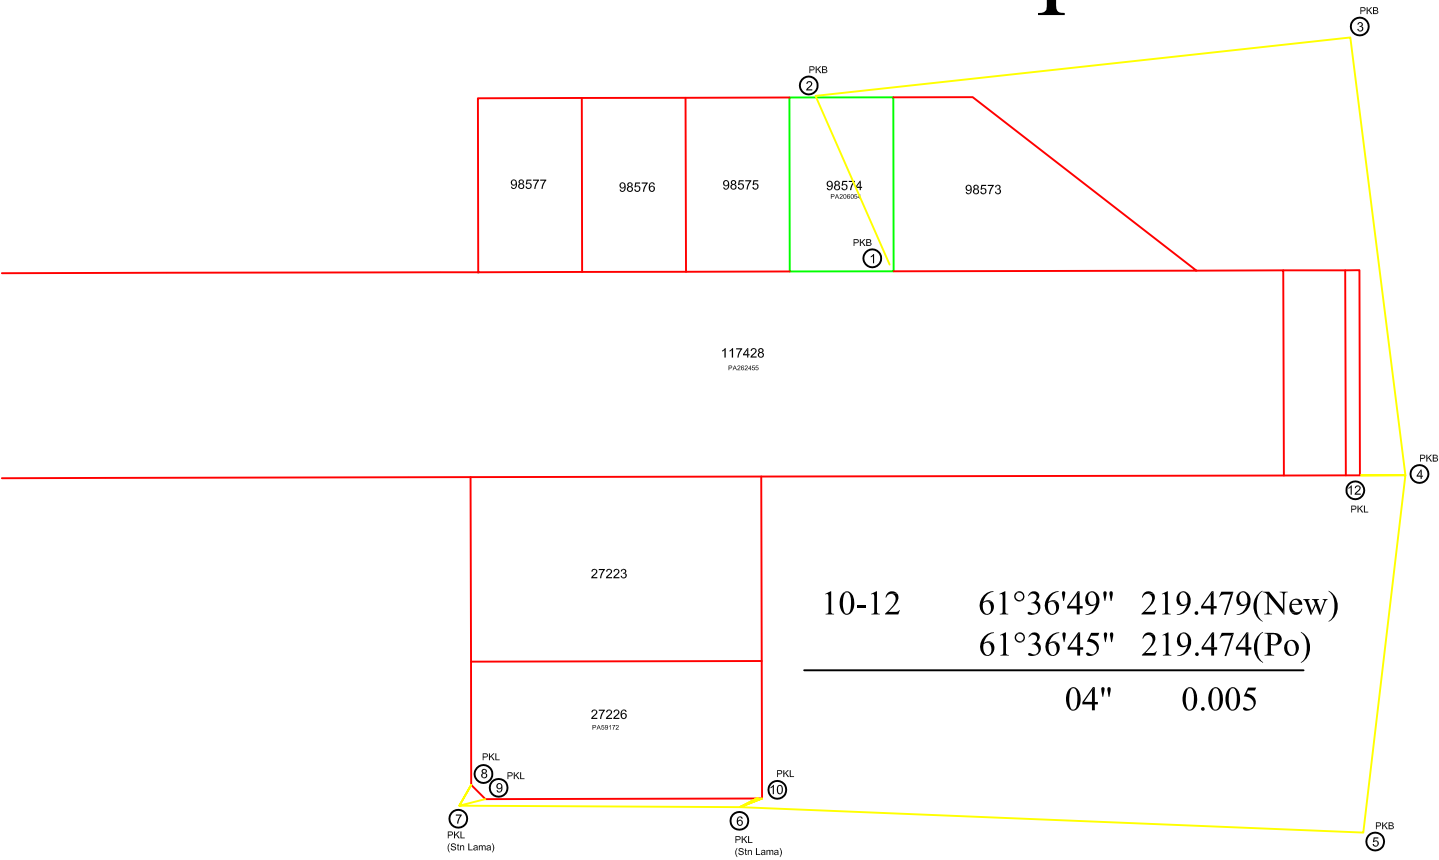

Penilik: JM3263 Terravest Kapar Tarikh: 17/03/2025

Stn. 2 Koordinat: S5992 B31251 Selangor

T.R. 1 B.K. Ms.

Tiodolit Satu bah. aras ufuk:

Waktu	Sasaran	Ufuk	Gelembong	Puguk
	T.R.	170 00 00		
9 51	M.H.	108 09 36	52 03 24	Waktu purata 9 51 30
9 51	M.H.	107 29 16	51 57 49	Beza dari U.T. - 8 00 00
9 52	M.H.	287 29 53	308 09 47	U.T. 1 51 30
9 52	M.H.	288 11 39	308 15 40	Deklinasi - 1 18 15
	T.R.	349 59 50		

	T.R.	170 00 00		
9 53	M.H.	108 13 41	51 28 42	Waktu purata 9 53 30
9 53	M.H.	107 33 00	51 23 02	Beza dari U.T. - 8 00 00
9 54	M.H.	287 33 37	308 44 19	U.T. 1 53 30
9 54	M.H.	288 15 40	308 49 06	Deklinasi - 1 18 13
	T.R.	349 59 50		

	Set 1	Set 2
Sudut pugak	38 06 04	38 40 25
Pembetulan	- 0 01 00	- 0 00 59
Altitud	38 05 04	38 39 26
Jarak kutub	91 18 15	91 18 13
Latitud	3 07 12	3 07 12
Azimut M.H. yang dikira	94 06 37	94 10 25
Purata ke M.H.	107 50 06	107 54 00
Selisih:	- 13 43 29	- 13 43 35
Purata ke T.R.	169 59 55	169 59 55
Azimuth T.R. sebenar	156 16 26	156 16 20
Pembetulan aras	+ 0 00 00	+ 0 00 00
Tirusan	+ 0 00 17	+ 0 00 17
Bering grid T.R.	156 16 43	156 16 37

Purata bering grid T.R. 156 16 40