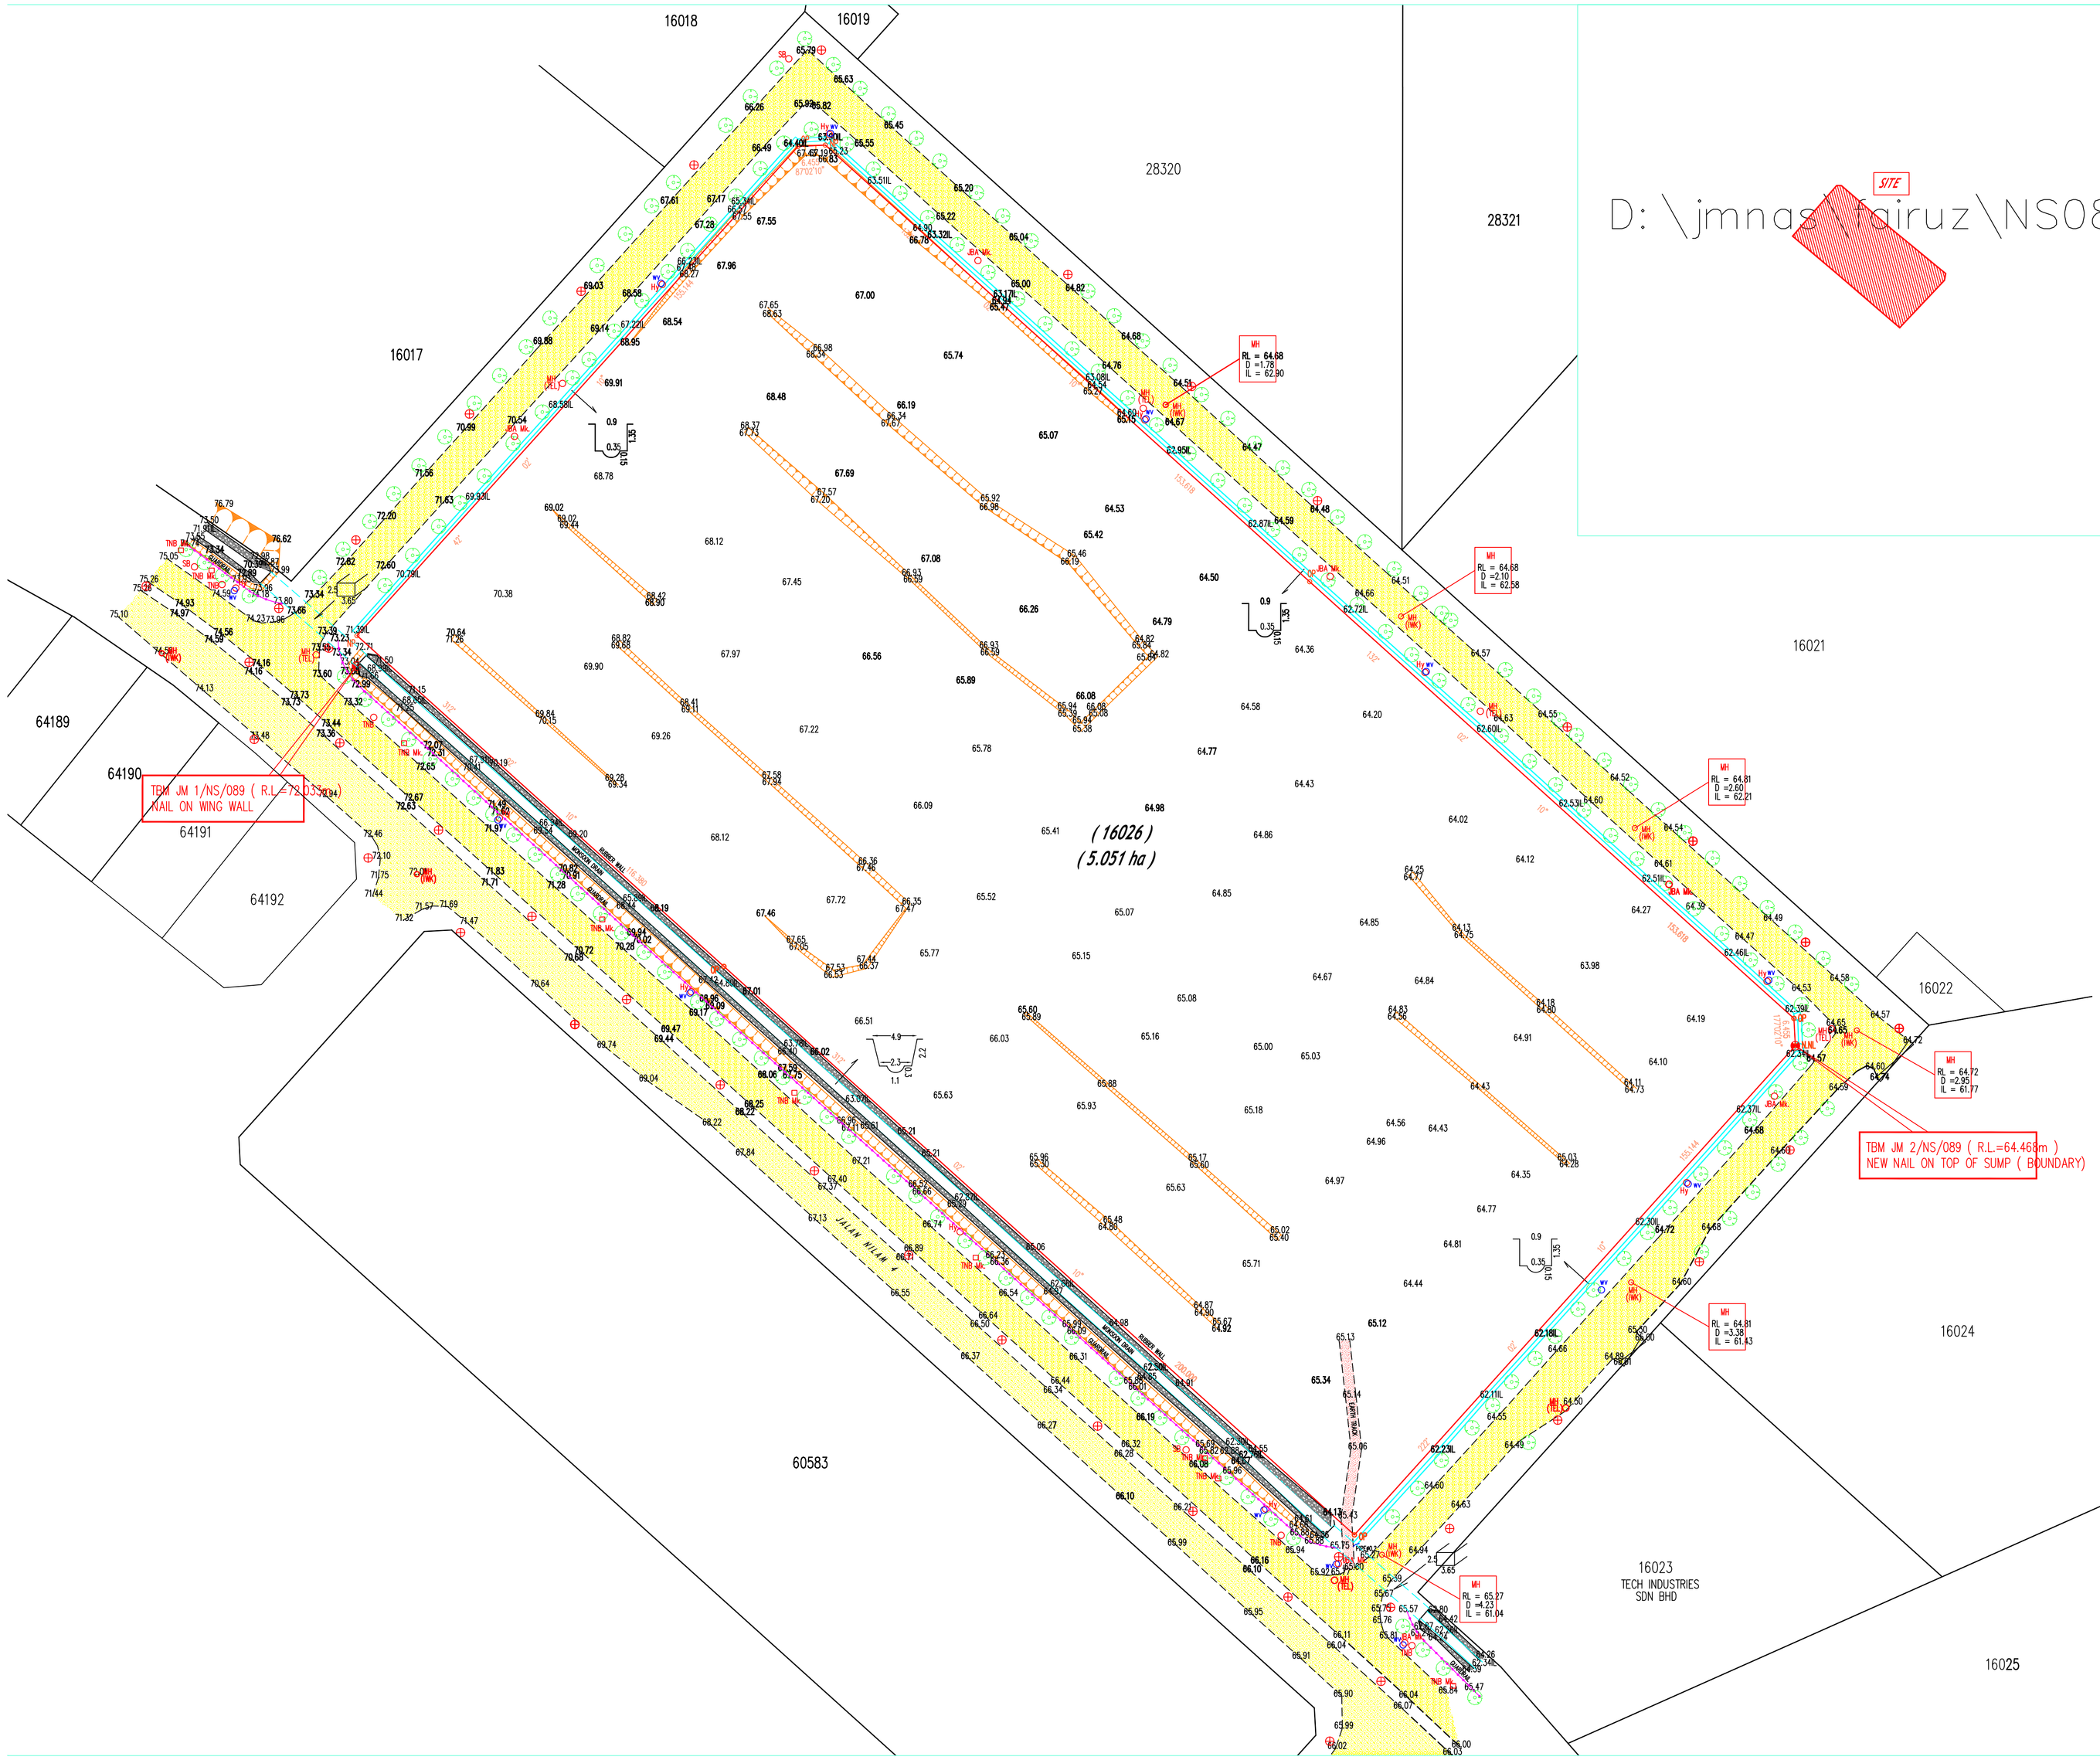


PELAN LOKASI
TANPA SKALA

SCALE 1 : 750
STANDARD SHEET : 34-B

TITLE

DEMARCATION, DETAIL & SPOT LEVEL SURVEY ON LOT 16026 , TOWN OF NILAI UTAMA , DISTRICT OF SEREMBAN , NEGERI SEMBILAN DARUL KHUSUS .

NOTE :

ALL LEVELS ARE BASED ON TBM 10 (R.L.=76.234m) WHICH (REFER PLAN NO.: FN/KCL/DG/C1/EW/01)

LEGEND :

- OP – OLD PIPE
- NP – NEW PIPE
- N.NL – NEW NAIL
- ⊕ – LAMP POST
- Hy – HYDRANT
- SB – SIGNBOARD
- WV – WATER PIPE VALVE
- TNB – TNB CABLE SIGNBOARD
- TNB Mk. – TNB MARKER
- JBA Mk. – JBA MARKER
- MH (IWK) – SEWERAGE MANHOLE
- MH (TEL) – TELECOM MANHOLE
- – WATER PIPELINE
- – TREE

LEVEL BOOK NO L0958
TACHY BOOK NO T0442

SURVEYED BY : WILLIAM

COMPUTED BY : LIN

DRAWN BY : LIN 16/08/2017

CHECKED BY : H'NG.K.P

H'NG KIM POR B.Sur. (Hons.) (Land) MIS (M)
Land Surveyor Licensed Under Act 458 (Revised 1991)

JURUKUR MURNI
LICENSED LAND SURVEYOR

No. 35A,Jalan 16/155C,Bandar Bukit Jalil
57000 Kuala Lumpur, Malaysia
Tel : 03-89940029/89940069
Fax : 03-89940039
Email :jmurni@gmail.com

PLAN NO. : JM/E/17/NS/089/A

DIGITAL FILE : JMNS089A