

[illegible]

WILAYAH DERSEKUTUAN 36
 MYKIM BATU.
 TANAA SKACA

Kajah di muka

No. Lait

Peraturan

No. Lait

WARISAN

ke


Sudut Papak

arak

Sudu

Jarak
Antara
Tumpang

Jarak Muktamat

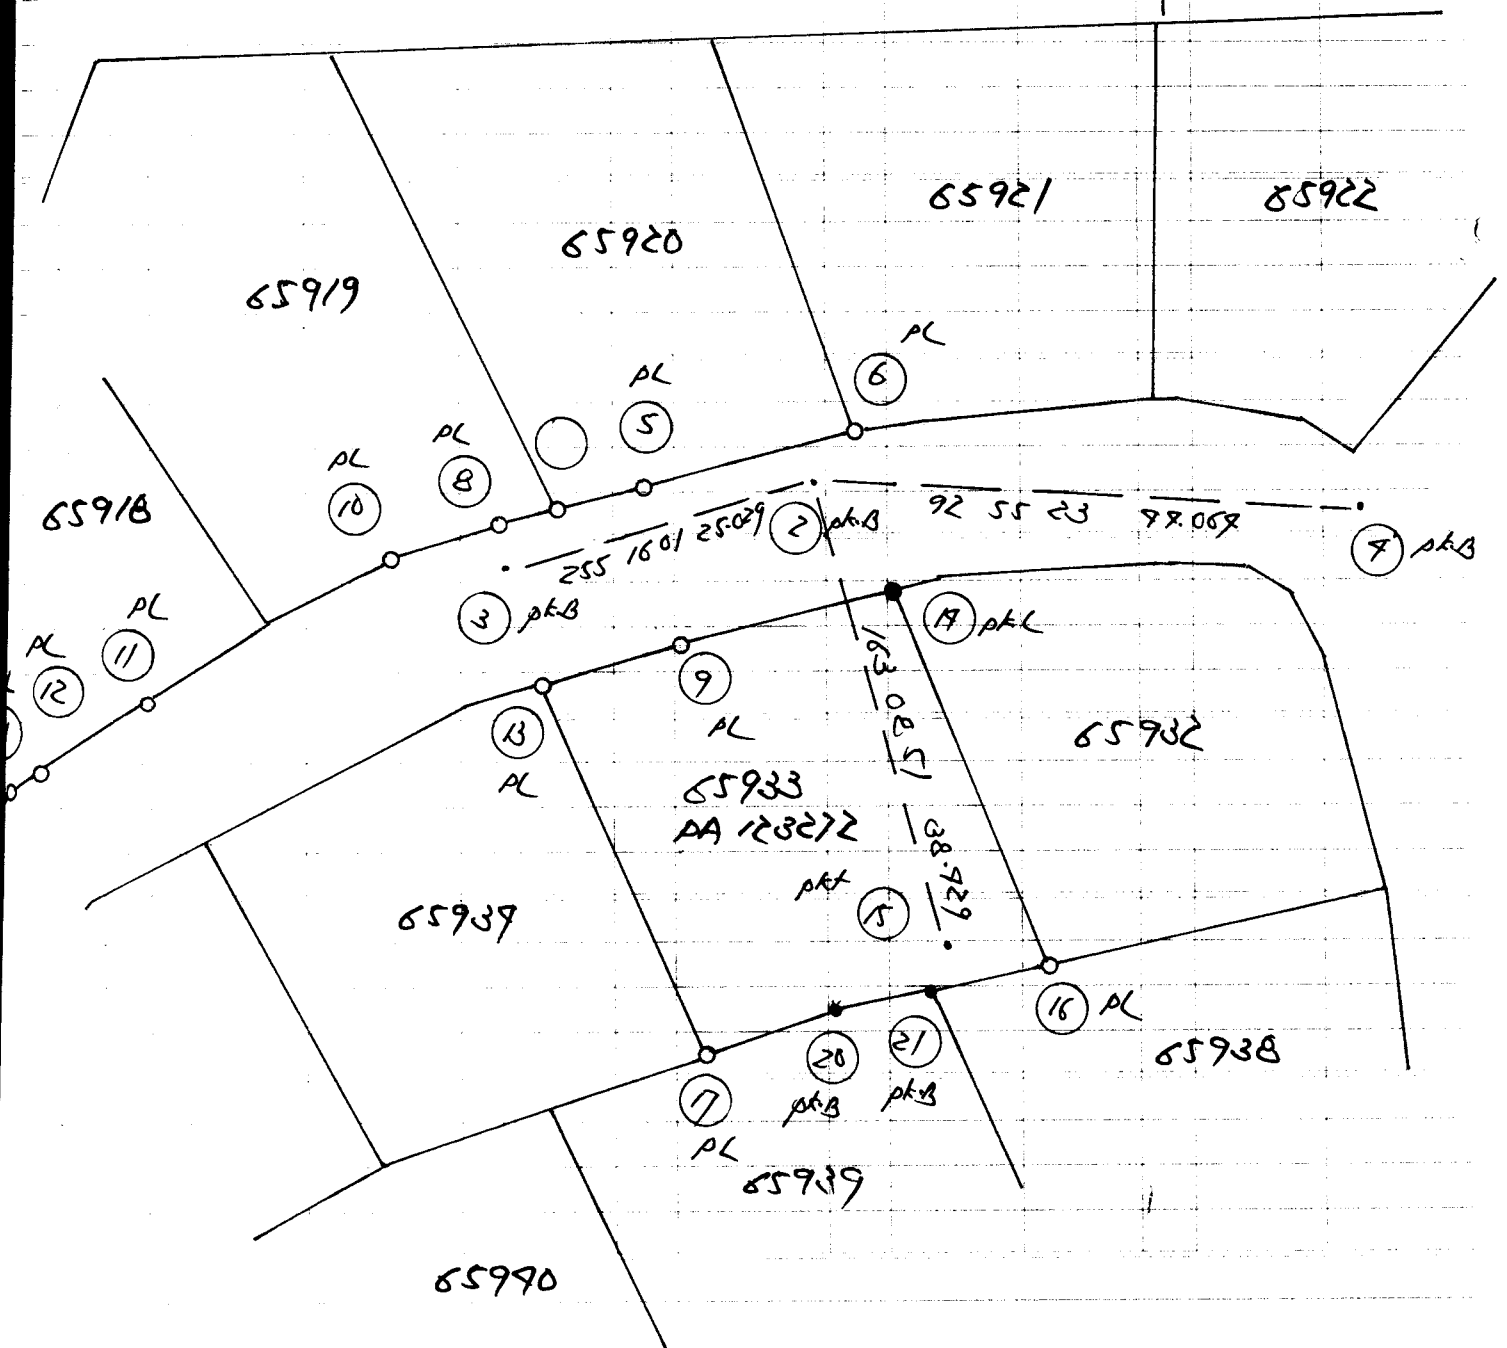

Tarikh Aras

Dibuat untuk

16

Daripada ASM/28 40.

Ke

Pandangan Belakang	Pandangan Antara	Pandangan Hadapan	Naik	Turun	Aras Yang Dilaras	Jarak	Catitan
2983	(9.78)				188.375	78m /	RC: 198.375
3.758	(11.37)	0.837	(12.25)		196.521	12.13 (78m x 1927)	
	1.151	(3.78)			198.828	FL (152)	
		0.568	(1.86)		199.911	78m x 1928 on GA.	