

JZ 0735 Kuang

Rajah di muka

Jarak		Rajah	GABESAN	Ke Stn	Sudut Pukak (°)	Jarak	Subur	Jarak Antara Tungga	Jarak Muktamat
Rajah									
Satuan Daripada.		2	67 80 03	1	4	16.009	26/9/2012		16.009
				BKL					
2-3	96 58 50	2	96 58 50	3	4	92.950		BKL	92.950
2-4	92 38 55	2	92 38 55	4	4	52.975		BKL	52.975
2-5	67 80 03 (Double Check)	2	67 80 03	5	4	16.009		BKL	16.009
2-6	301 88 21	2	301 88 21	6	4	28.285		BKL	28.285
2-7	277 55 28	2	277 55 28	7	4	33.776		BKL	33.776
2-8	109 05 11	2	109 05 11	8	4	26.168		BKL	26.168
1	67 80 03 277 80 03 286 09 39	2	286 09 39	10	4	78.306			78.306
2	10 286 09 39 106 09 39								
	pkx								
1	Seperti Di Atas 193 06 53	2	193 06 53	11	4	67.183			67.183
2	11 193 06 53 13 06 53								
	pkx								
1	Seperti Di Atas 101 27 12	2	101 27 12	12	4	131.000			131.000
2	12 101 27 12 281 27 12								
	pkx								
1	Seperti Di Atas 18 80 23	2	18 80 23	13	4	95.759			95.759
2	13 18 80 23 198 80 23								
	pkx								

No. Fail

Rajah di muka

Stesen	BEARING SUDUT			Dari Stn	GARISAN		Ke Stn	Sudut Pusing (°)	Jarak	Sudut	Jarak Antara Tegang	Jarak Muktamad
	Pemayang Kiri	Pemayang Kanan	Purata		Bearing Muktamad							
2	13 0653	183 0653	285 0129	11	265 0129	22	4		35.270			35.270
11												
22	265 0129	85 0129										
	pk											
11-23	109 3556			11	109 3556	23	4		27.920		PL	27.920
11-												
22-29	16 0985			22	16 0985	29	4		1.818		BKL	1.818
22-25	283 5313			22	283 5313	25	4		19.019		BKL	19.019
11	85 0129	265 0129	289 0709	22	289 0709	26	4		79.273			79.273
22												
26	289 0709	109 0709										
	pk											
22	109 0709	289 0709	358 5839	26	358 5839	27	4		69.823			69.823
26												
27	358 5839	178 5839										
	pk											
26-28	255 0833			26	255 0833	28	4		11.992		PL	11.992
26	178 5839	358 5839	99 2630	27	99 2630	10	4		51.307			51.307
27												
10	99 2630	279 2630										
27	279 2630	99 2630	106 0939	10	106 0939	2		Sila	Lihat m/s 5 R 7			
10												
2	106 0939	286 0939										

Bering 10-2 Dibaca 106 09 39
 Sepatutnya Dibaca 106 09 39

Tilakan
 Pembetulan

Ni/
 Ni/


No. Fail

Rajah di muka

Stesen	BEARING / SUDUT			Dari Stn	GARISAN Bearing Mukamat	Ke Stn	Sudut Pukak (°)	Jarak	Sudut	Jarak Antara Tiang	Jarak Mukamat
	Penyangk Kiri	Penyangk Kanan	Purata								

Demonstrate & Online mark:

2-50	239 2237	50.829	4WP
2-51	273 2825	7.691	4WP
2-52	155 3938	73.805	4WP
2-53	390 7977	78.959	4WP
2-54	31 0302	73.736	4WP
2-55	67 2792	67.679	4WP
13-56	257 3123	39.578	4WP
13-57	178 7702	19.105	4WP
13-58	125 1927	97.920	4WP
17-59	230 7128	20.738	4WP
17-60	133 7797	31.278	4WP
12-61	19 0503	39.726	4WP
12-62	328 2978	57.761	4WP
11-63	223 2727	7.077	4WP
26-64	118 5896	25.352	4WP
26-65	395 1502	31.902	4WP
27-66	218 7115	5.307	PB
27-67	111 3232	31.077	4WP
10-68	137 2258	17.637	4WP

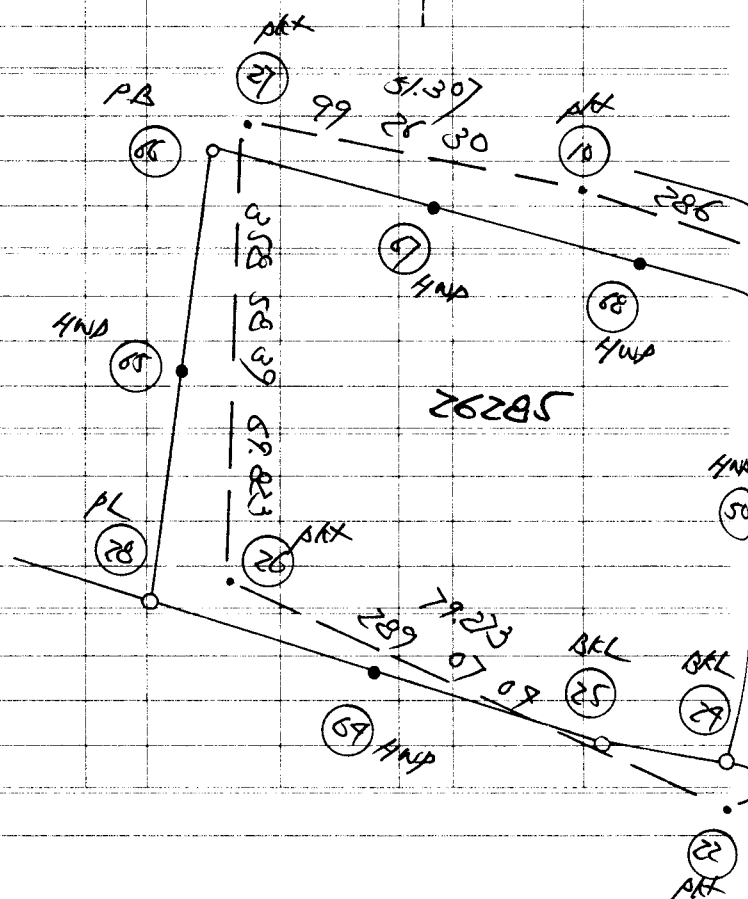

15-1	172 4615	108.811	N
	172 4617	108.876	PO
	-2"	-0.035	

1-10	102 7210	78.822	N PO
	102 72 29	78.832	N

+19" +0.010

