

[illegible]


No. Fail

Rajah di muka

[illegible]

No. Fail

Rajah di muka

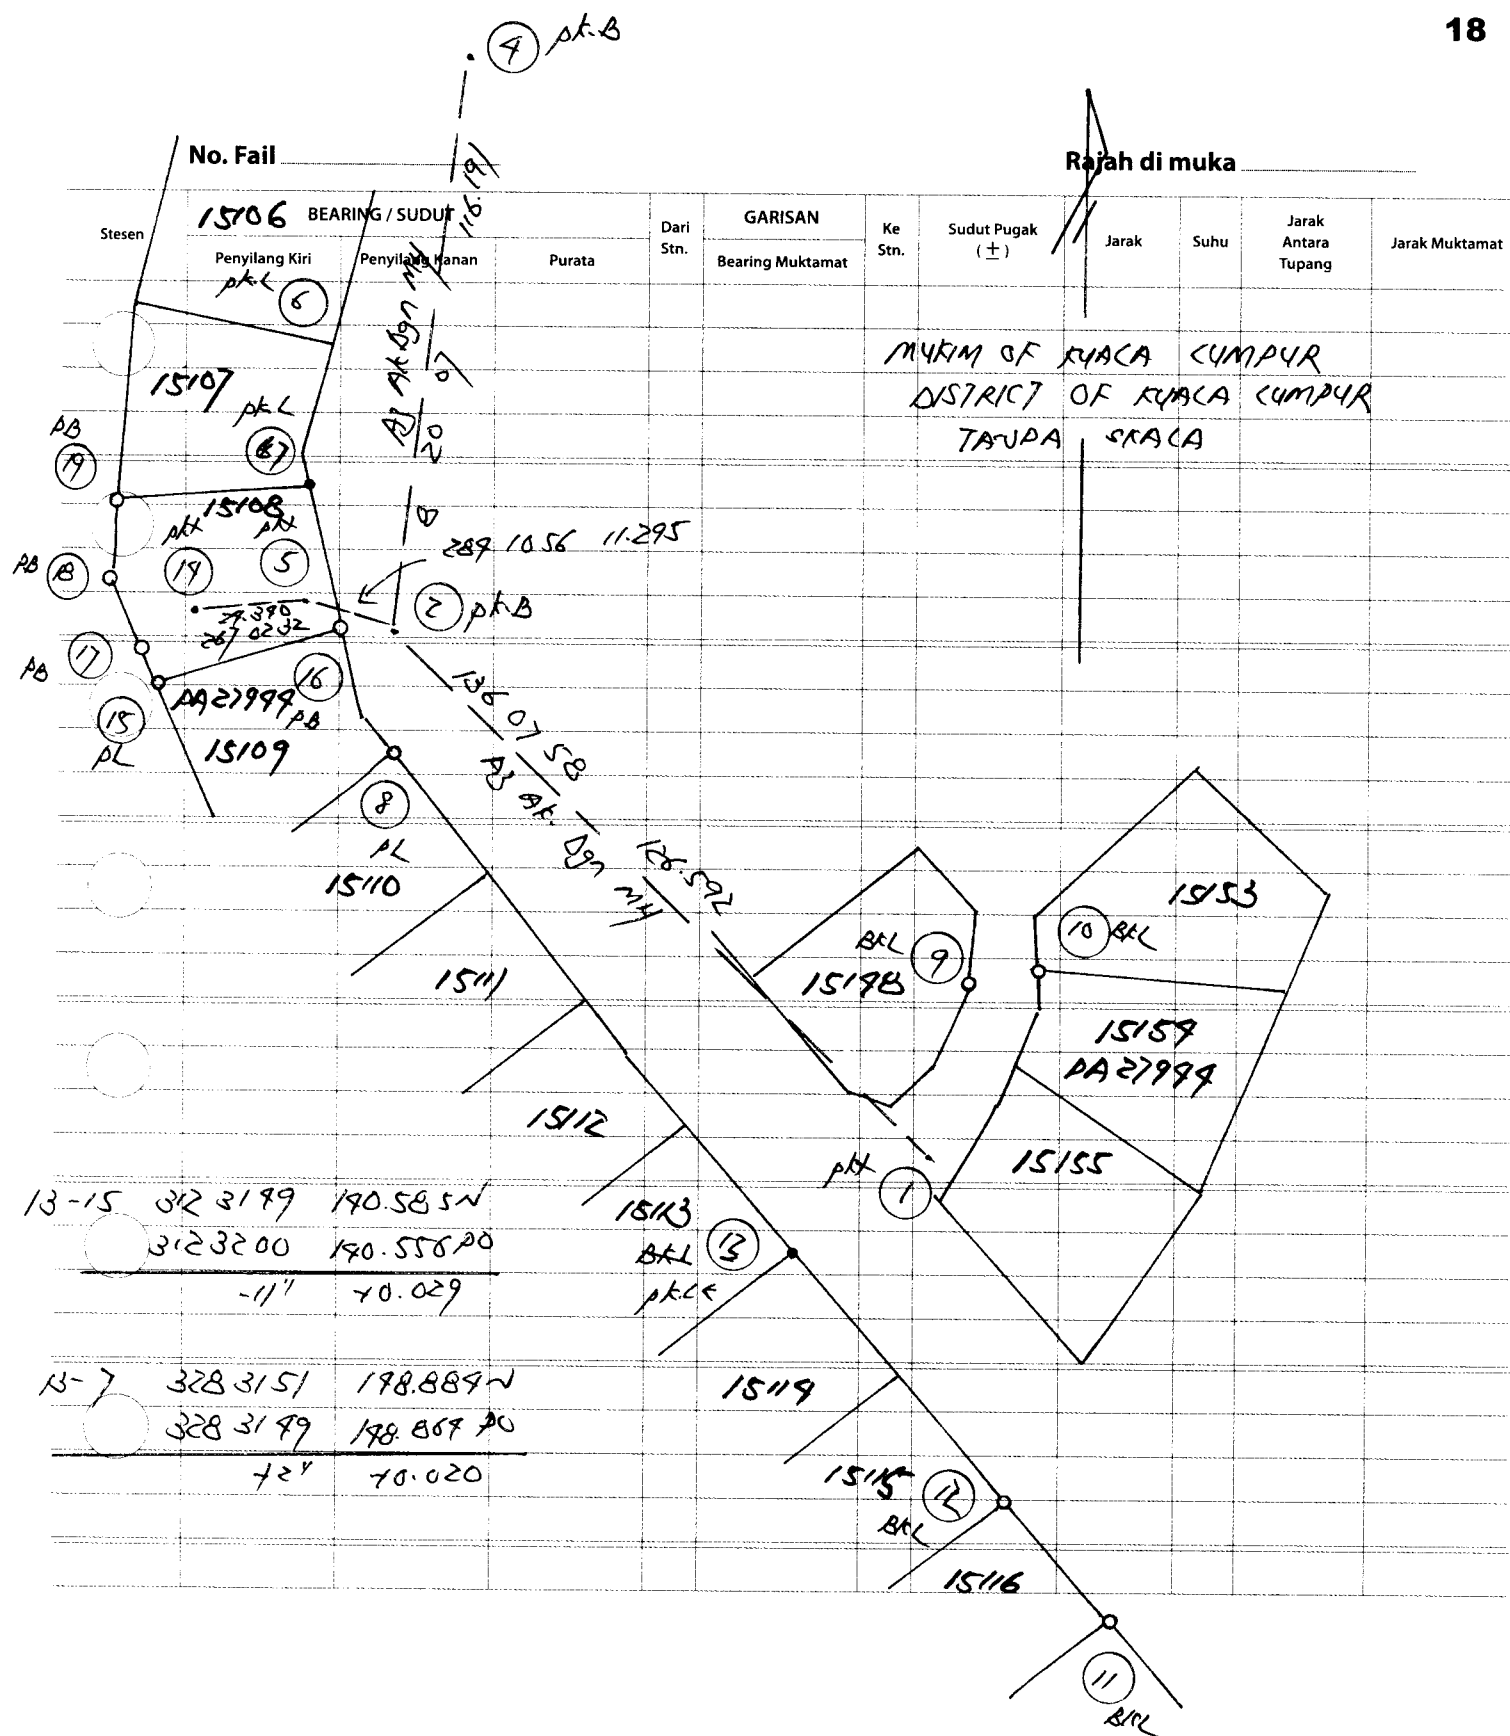

Client Buttz Parlay

Date 78 248

Location
Purpose

20

[illegible]