

No. Fail J2 299 SDB SS2 Leave.

Rajah di muka

Stesen	BEARING / SUDUT			Dari Stn.	GARISAN		Ke Stn.	Sudut Pukak ($\pm$)	Jarak	Suhu	Jarak Antara Tupang	Jarak Muktamat
	Penyilang Kiri	Penyilang Kanan	Purata		Bearing Muktamat							
	Datum Daripada			2	105 085	1	4	79.679	5/5/15		79.679	
				GR1		GR2						
				pkL		pkL						
1	105 085	285 085	289 992	2	289 992	3	4	183.322			183.322	
2					pk							
3	289 992	109 992										
	pk.B											
2-4	25 37 90			2	25 37 90	4	4	12.829		pk.L	12.829	
3-5	12 01 10			3	12 01 10	5	4	189.512		pk.L	189.512	
3-6	12 12 28			3	12 12 28	6	4	128.882		pk.L	128.882	
3-7	12 42 21			3	12 42 21	7	4	68.390		pk.L	68.390	
3-8	12 51 51			3	12 51 51	8	4	58.301		pk.L	58.301	
2	285 085	105 085	193 010	1	193 010	9	4	78.506			78.506	
1												
9	193 010	13 01 07										
	GR3 pkL											
2	Sipat Di Atas	29 59 29		1	29 59 29	10	4	92.236			92.236	
1												
10	29 59 29	209 59 29										
	pk.B pk.L GR4											
10-11	9 01 21			10	9 01 21	11	4	89.787		pk.L GR-5	89.787	
10-12	15 41 06			10	15 41 06	12	4	88.315		pk.L 78M/9	88.315	
10-13	358 20 27			10	358 20 27	13	4	99.586		pk.L	99.586	

No. Fail _____


Rajah di muka _____


Stesen	BEARING / SUDUT			Dari Stn.	GARISAN		Ke Stn.	Sudut Pugak ($\pm$)	Jarak	Suhu	Jarak Antara Tupang	Jarak Mukamat
	Penyilang Kiri	Penyilang Kanan	Purata		Bearing Mukamat							
2 3	109 4927	289 4927	7 0210	3	7 0210	19	4	4	172.695			172.695
19	7 0210	187 0210										
	pk.B											
19-15	220 3852			19	220 3852	15	4	4	9.993		pk.C ←	9.993
19-16	325 5813			19	325 5813	16	4	4	6.758		pk.C ←	6.758
19-17	8 2296			19	8 2296	17	4	4	85.330		pk.C ←	85.330
3 19	187 0210	7 0210	15 0958	19	15 0958	18	4	4	118.930			118.930
18	15 0958	195 0958										
	pk.B											
19 18	195 0958	15 0958	109 2632	18	109 2632	19	4	4	106.505			106.505
19	109 2632	289 2632										
	pk.C ←											
2 3	109 4927	289 4927	191 5191	3	191 5191	30	4	4	160.832			160.832
20	191 5191	11 5191										
	pk.B											
3 20	11 5191	191 5191	190 5949	20	190 5949	21	4	4	138.955			138.955
21	190 5949	10 5949										
	pk.B											
21-22	191 0732	11 0732		21	191 0732	22	4	4	16.696 16.696		Sp.L	16.696
21-23	170 2223			21	170 2223	23	4	4	13.012		p Sp.L	13.012

No. Fail _____

Rajah di muka _____

Stesen	BEARING / SUDUT			Dari Stn.	GARISAN Bearing Mukamat	Ke Stn.	Sudut Pukak ($\pm$)	Jarak	Suhu	Jarak Antara Tupang	Jarak Mukamat
	Penyilang Kiri	Penyilang Kanan	Purata								
							13-19	319 30 59		192.912N	
								319 29 07		192.95700	
								+1' 97"		-0.045	
							13-22	219 50 27		549.305N	
								219 51 32		549.10606	
								-1 5"		+0.199	

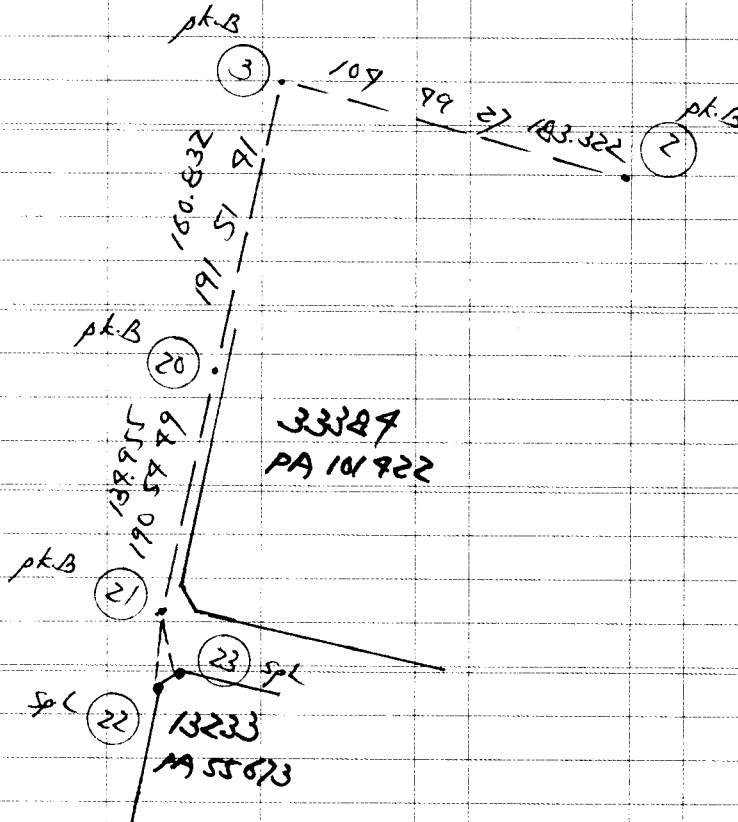

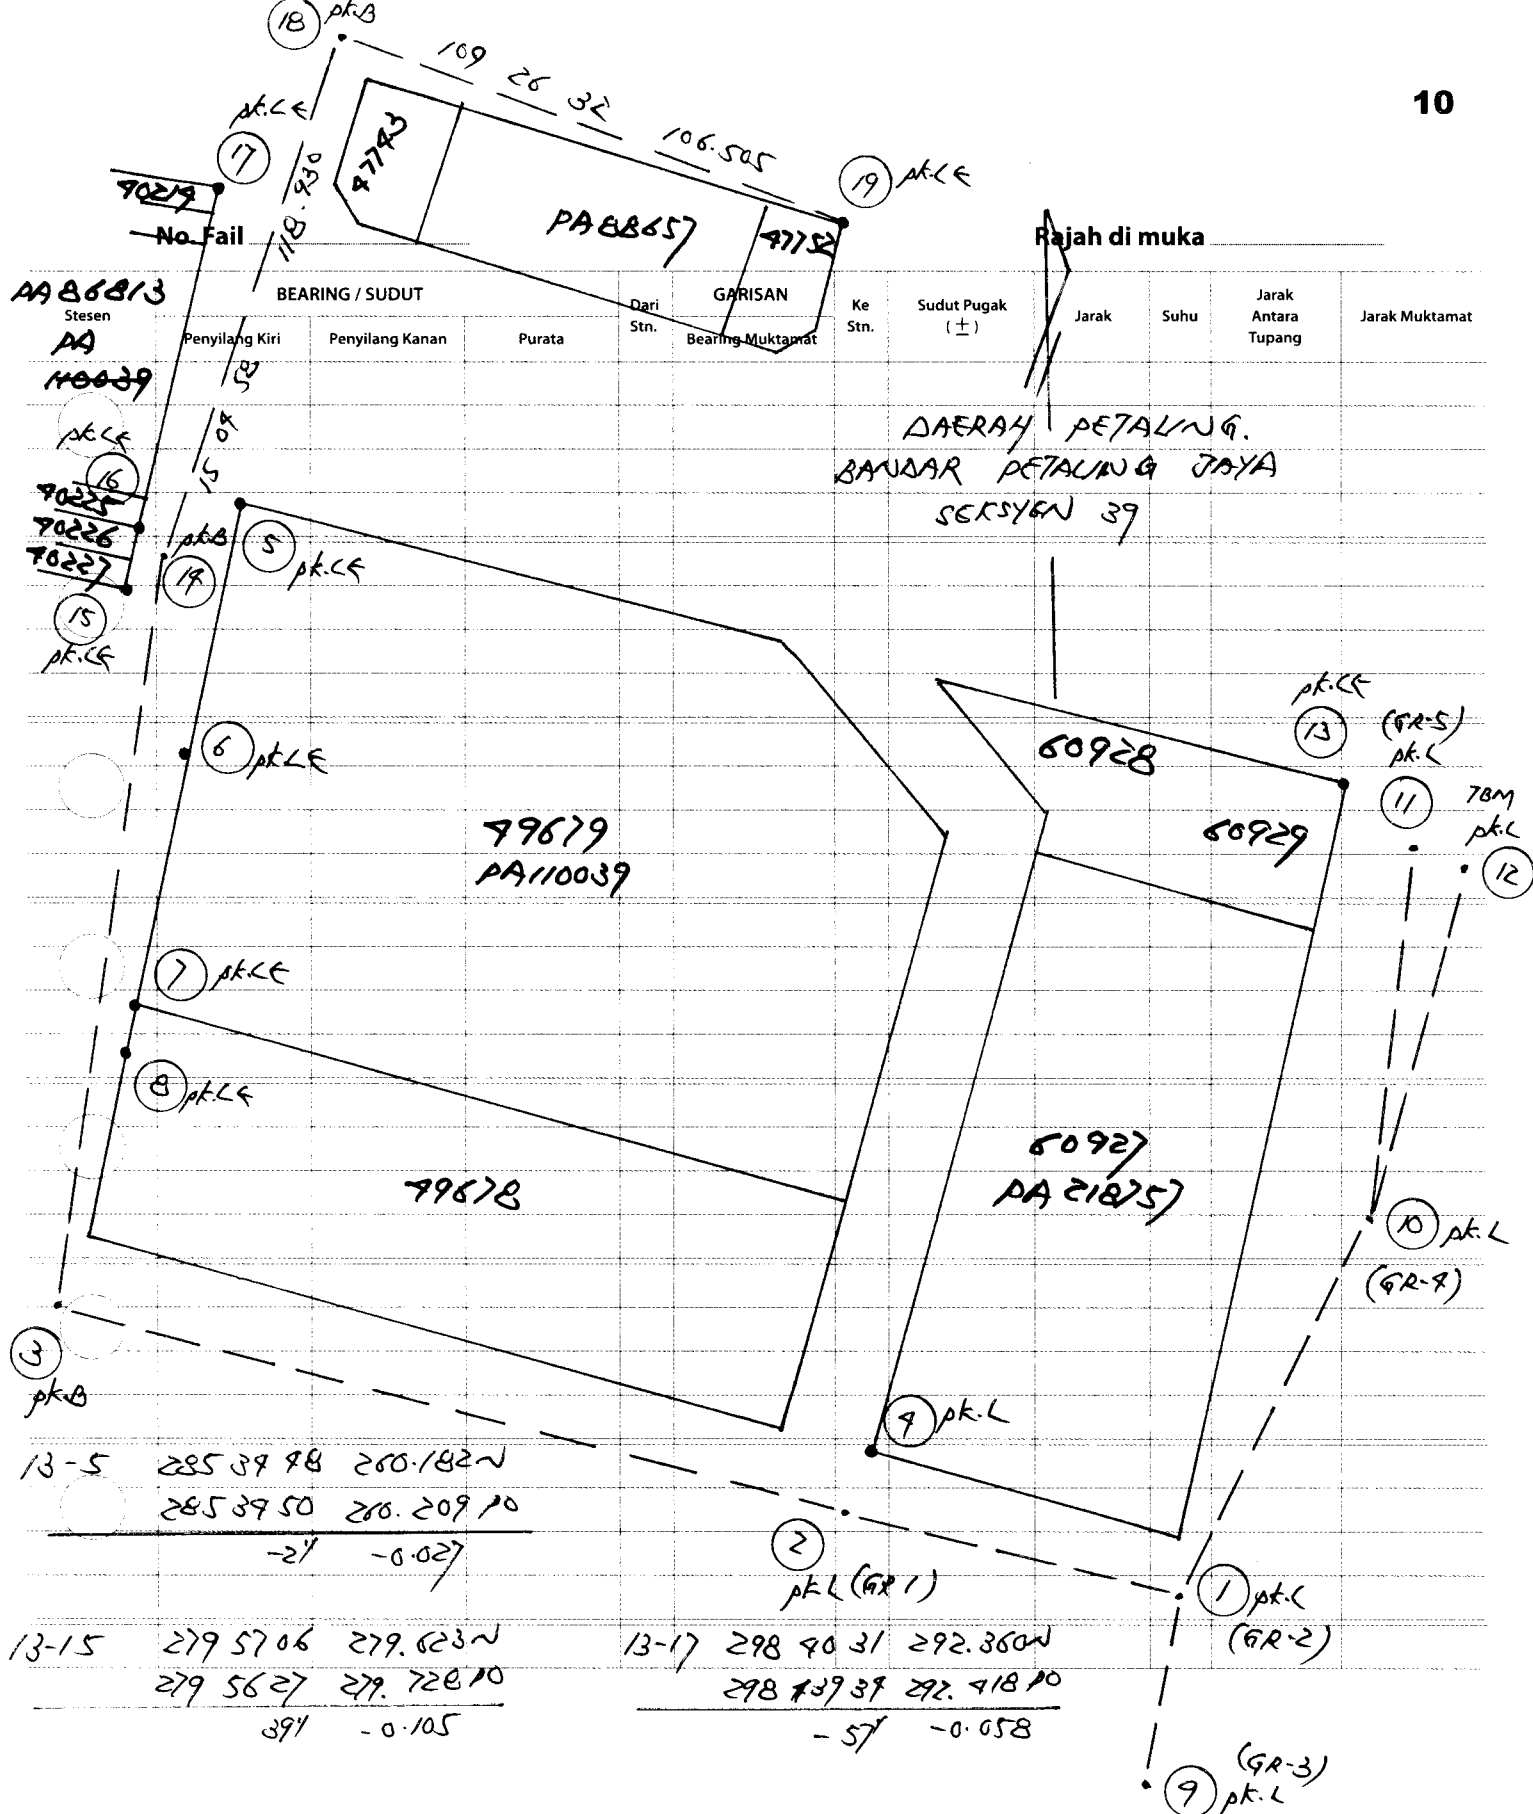

[illegible]

No. Fail


Rajah di muka

Stesen	BEARING / SUDUT			Dari Stn.	GARISAN		Ke Stn.	Sudut Pukak ($\pm$)	Jarak	Suhu	Jarak Antara Tupang	Jarak Mukamat
	Penyilang Kiri	Penyilang Kanan	Purata		Bearing Mukamat							
m/s B R 6	20	10 59 99	190 59 99	103 36 90	21	103 36 90	37	H	80.170			80.170
	21	37	103 36 90	283 36 90								
		pk.B										
	21	283 36 90	103 36 90	102 91 10	37	102 91 10	38	H	123.358			123.358
	37	38	102 91 10	282 91 10								
		pk.B										
	37	282 91 10	102 91 10	282 00 50	38	282 00 50	39	H	38.975			38.975
	38	39	282 00 50	82 00 50								
		pk.L										
	37	Seperti Di Atas	5 08 30	38	5 08 30	70	H	128.829				128.829
	38	70	5 08 30	185 08 30								
		pk.B										
	38	185 08 30	5 08 30	16 15 10	70	16 15 10	1	H	162.927			162.927
	70	1	16 15 10	196 15 10								
	70	196 15 10	16 15 10	105 08 57	1	105 08 57	2	Sik	4.402	m/s	75 R 1	
	1	2	105 08 57	285 08 57								

No. Fail

Rajah di muka

Stesen	BEARING / SUDUT			Dari Stn.	GARISAN	Ke Stn.	Sudut Pugak ($\pm$)	Jarak	Suhu	Jarak Antara Tupang	Jarak Mukamat
	Penyilang Kiri	Penyilang Kanan	Purata		Bearing Mukamat						
m/s 7 R 6	1	209 59 29	29 58 29	10 36 50	10	10 36 50	91	4		156.495	156.495
	10	91	10 36 50	190 36 50							
			pk.B								
	10	190 36 50	10 36 50	285 07 00	91	285 07 00	92	4		196.676	196.676
	91	92	285 07 00	105 07 00							
			pk.B								
	91	105 07 00	285 07 00	39 42 53	92	39 42 53	93	4		36.192	36.192
	92	93	39 42 53	219 42 53							
			Sp.L								
	91	Seperti Di Atas	290 51 31	92	290 51 31	99	4		99.245	99.245	
	92	99	290 51 31	110 51 31							
			pk.B								
	92	110 51 31	290 51 31	191 59 20	99	191 59 20	19	4		86.867	86.867
	99	19	191 59 20	11 59 20							
	99	11 59 20	191 59 20	187 02 10	19	187 02 10	3	4		Sila Lihat m/s 6 R1	
	19	3	187 02 10	7 02 10							
			Bering 19-3 Di baran	187 02 10							
			Sepatutnya Di baran	187 02 10							
			Tikuan	Nil							
			Pembetulan	Nil							

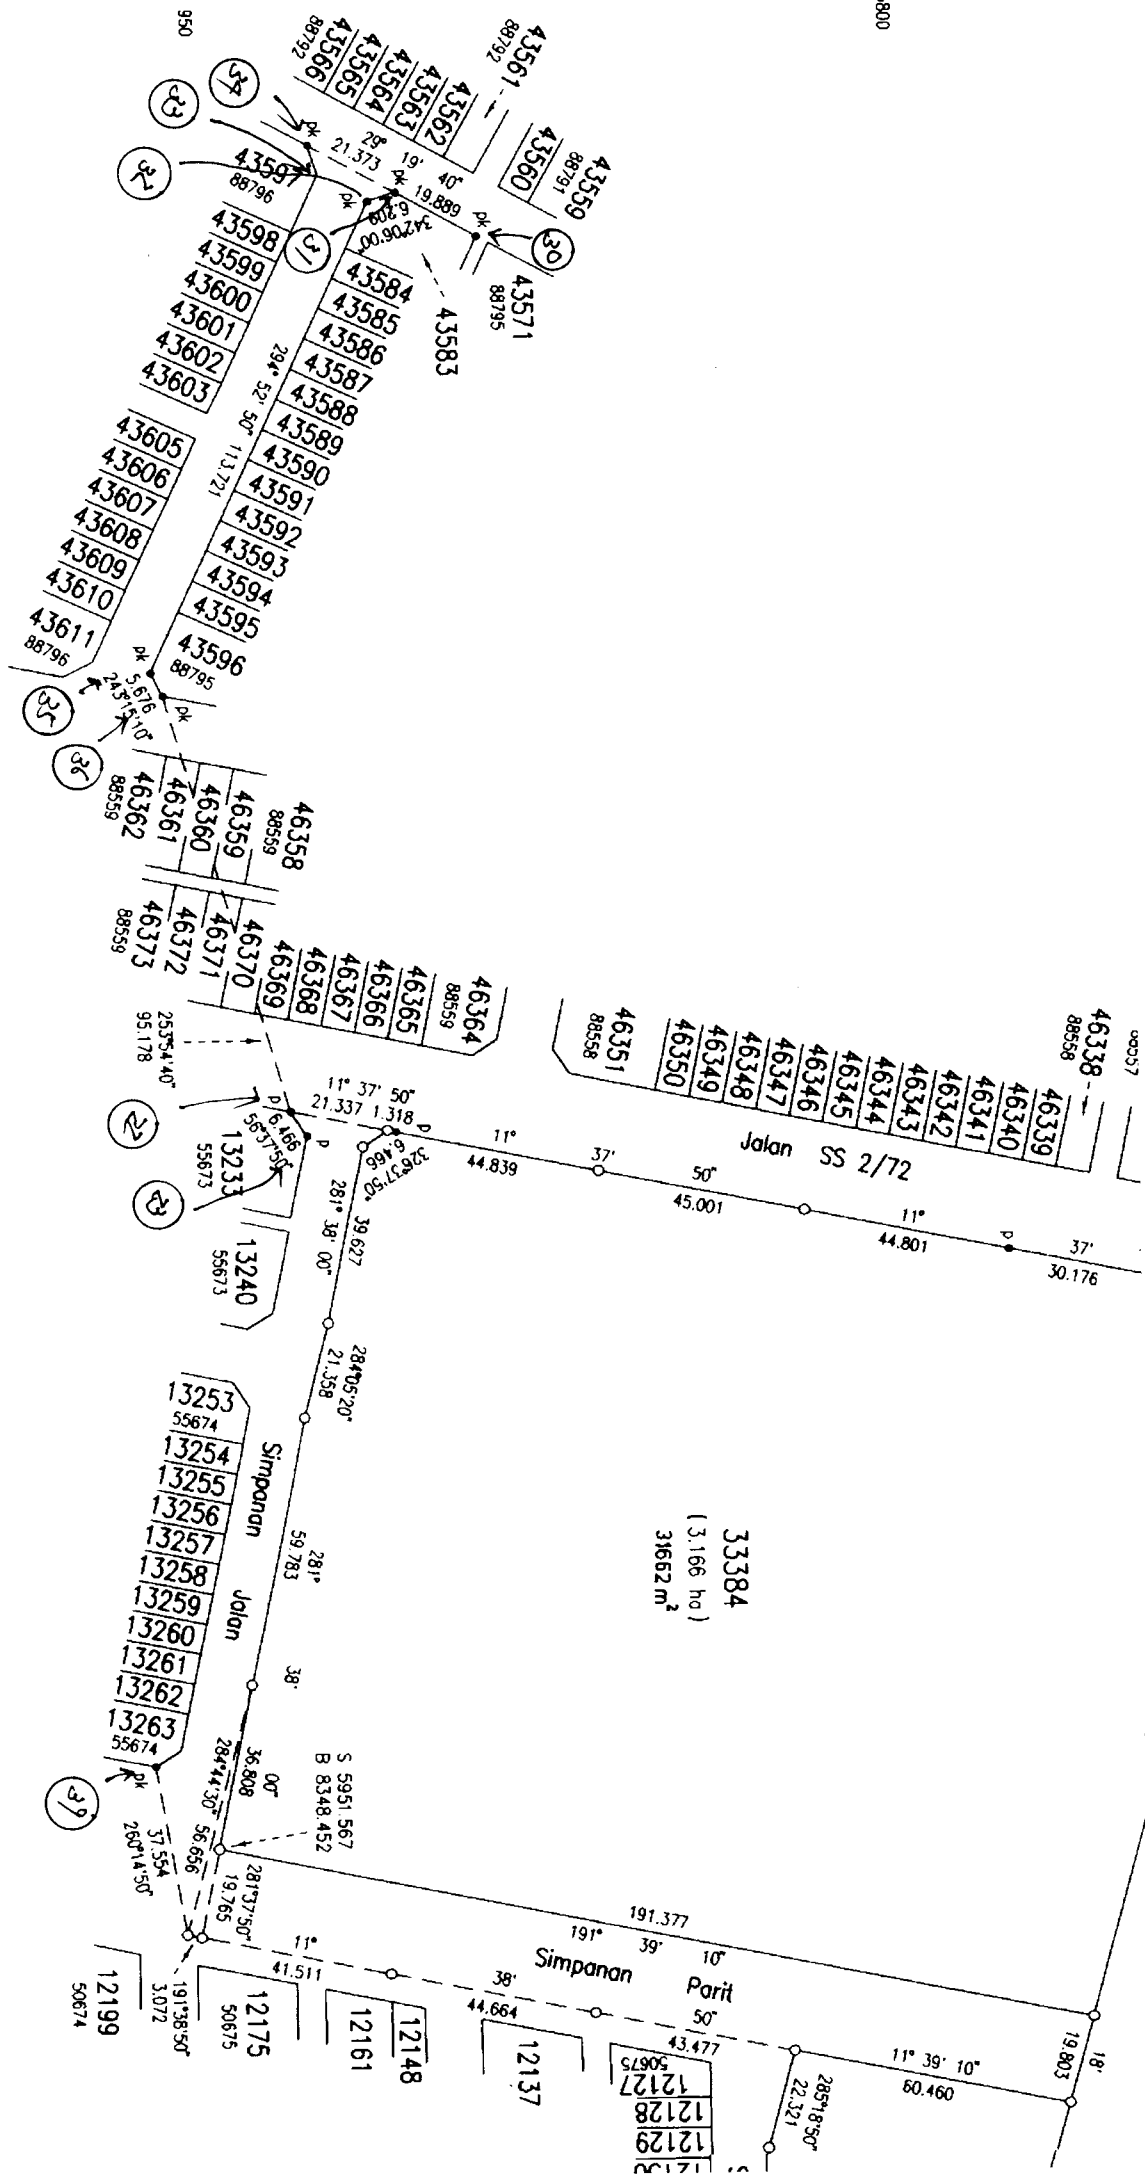

33384
(3.166 ha)
31652 m²