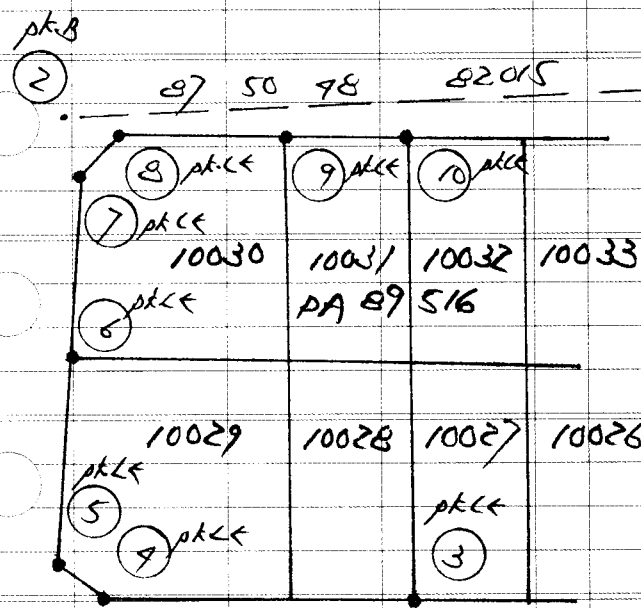


No. Fail JR298 775 Lt 10038

Rajah di muka

Stesen	BEARING / SUDUT			Dari Stn.	GARISAN		Ke Stn.	Sudut Pukak (±)	Jarak	Suhu	Jarak Antara Tupang	Jarak Mukamat
	Penyilang Kiri	Penyilang Kanan	Purata		Bearing Mukamat							
	Datum	Daripada		2	27 50 98	1	4	42.015	18/5/16			22.015
				pk.B		pk.B						
2-3	176 09 50			2	176 09 50	3	4	78.505		pk.C		78.505
2-4	177 45 58			2	177 45 58	4	4	63.853		pk.C		63.853
2-5	181 49 21			2	181 49 21	5	4	59.300		pk.C		59.300
2-6	181 19 37			2	181 19 37	6	4	33.352		pk.C		33.352
2-7	176 39 40			2	176 39 40	7	4	7.932		pk.C	7.932	7.932
2-8	118 21 57			2	118 21 57	8	4	5.991		pk.C		5.991
2-9	95 40 81			2	95 40 81	9	4	27.077		pk.C		27.077
2-10	93 30 50			2	93 30 50	10	4	42.268		pk.C		42.268
	2 267 50 98	27 50 98	70 56 96	1	70 56 96	11	4	72.838				72.838
	11	70 56 96	250 56 96									
		pk.B										
	2	Sepereti Di Atas	23 45 21	1	23 45 21	12	4	72.021				72.021
	12	23 45 21	203 45 21									
		pk.B										
1-13	57 57 38			1	57 57 38	13	4	22.727		pk.L		22.727
1-14	29 36 33			1	29 36 33	14	4	23.892		pk.L		23.892
12-15	173 32 22			12	173 32 22	15	4	9.596		pk.B		9.596
12-16	139 28 53			12	139 28 53	16	4	7.777		pk.B		7.777
11-17	267 02 40			11	267 02 40	17	4	17.572		pk.B		17.572

Rajah di muka

Stesen	BEARING / SUDUT			Dari Stn.	GARISAN	Ke Stn.	Sudut Pukak ($\pm$)	Jarak	Suhu	Jarak Antara Tupang	Jarak Mukamat
	Penyilang Kiri	Penyilang Kar. ar.	Purata		Bearing Mukamat						
	DAERAH UCU LANGSAT MUKIM SEMENYIH TANPA SKALA										
											
	10029 10028 10027 10026										
	10030 10031 10032 10033 PA 89 516										
	10038										
	PA 88 585										
	10038										
	PA 88 585										
Sunny's

Client

J2291

Date

775 60x 9721

Location

Purpose

From	To	RL of Station	Inst. Ht.	Bearing	Vertical Angle + or -	Lower Wire	Middle Wire	Upper Wire	Geod. No.
1.877 (6.05)					70.260			72.71	
+0.605 (1.98)					71.799	78M	F2858		
1.267 (7.16)					70.837	78M	F2857		
1.829 (5.08)					70.875		F2 / 605		

Ht. Diff. + or -	RL of Inst.	RL. Centre Reading	m	RL Object	Remarks
					BM 85292
					GPS Level: 62.092
					BM Level: 61.919
					constant: 40.179
					F2 / 605
					GPS Level: 70.657
					BM Level: -0.179
					<u>70.475</u>

Hydram.
pk. C