

No. Fail JR 298 Jirjang.

Rajah di muka

Stesen	BEARING / SUDUT			Dari Stn.	GARISAN		Ke Stn.	Sudut Pugak ($\pm$)	Jarak	Syhu	Jarak Antara Tupang	Jarak Mukamat
	Penyilang Kiri	Penyilang Kanan	Purata		Bearing Mukamat							
	Dahm Sanpady			2	65 09 09	1	4	72.657	12/4/16			72.657
				pk.B	A3 At.	pk.B						
					Agn my							
2	1	65 09 09	285 09 09	251 15 32	2	251 15 32	3	4			10.806	10.806
	3	251 15 32	71 15 32					90 30 50				
		pk.C										
2	1	Spmi Ji Atas	215 21 83	2	215 21 83	7	90 10 45	67.380				67.380
	7	215 21 83	35 21 83									
		Sp.L										
2	1	Spmi Ji Atas	110 29 90	2	110 29 90	5	90 50 83	37.169				37.169
	5	110 29 90	290 29 90									
		pk.A										
2-6	102 22 06			2	102 22 06	6	89 10 50	5.172		pk.C		5.172
7-7	300 38 19			7	300 38 19	7	89 20 53	75.885		Sp.L		75.885
7-8	300 91 59			7	300 91 59	8	89 48 31	25.070		Sp.L		25.070
5	2	290 29 90	110 29 90	12 37 30	5	12 37 30	1	90 10 20	30.579			30.579
	1	12 37 30	192 37 30									
		p										
5	192 37 30	12 37 30	285 09 09	1	285 09 09	2	Sik Liket	2.1				
1					Bering							
	2	285 09 09	65 09 09		Tek. 49							

No. Fail

Rajah di muka

No. Fail		BEARING / SUDUT			Dari Stn.	GARISAN	Ke Stn.	Sudut Pukak ($\pm$)	Jarak	Suhu	Jarak Antara Tupang	Jarak Mukamat
Stesen		Penyilang Kiri	Penyilang Kanan	Purata		Bearing Mukamat						
Demam rali.												
2-10	106 01 76	6.699	AB									
5-11	289 21 17	6.958	pkB									
1-12	198 36 09	19.282	AB									
1-13	217 55 18	11.197	AB									
2-14	55 50 26	20.606	AB									
2-15	53 17 73	15.895	AB									
2-16	51 06 59	13.251	AB									

WILAYAH PERSEKUTUAN

KUACA CUMPUK

MUKIM BATU

TANPA SKACA

PL 23 AB 16



PL 29 PB 15

AB 28 PB 19

AK 27 42 65 / 20 51 7

56567

WILAYAH PERSEKUTUAN
KUACA LUMPUR
MUKIM BATU
TANPA SKALA

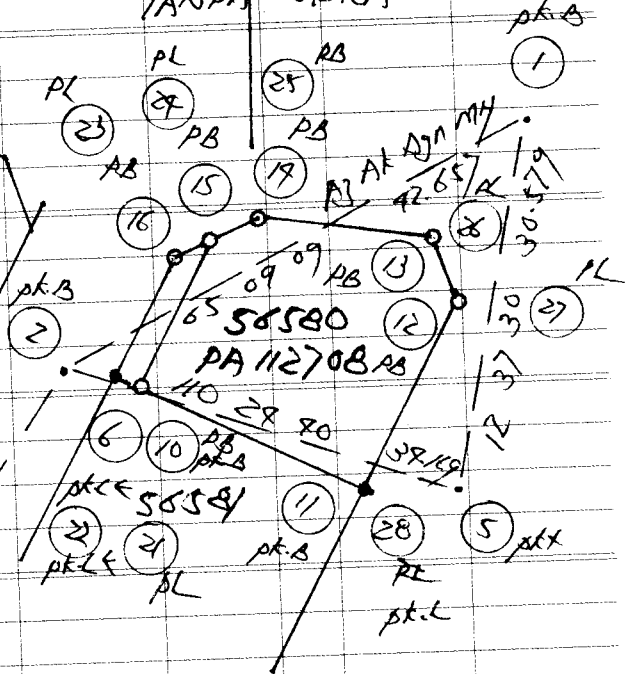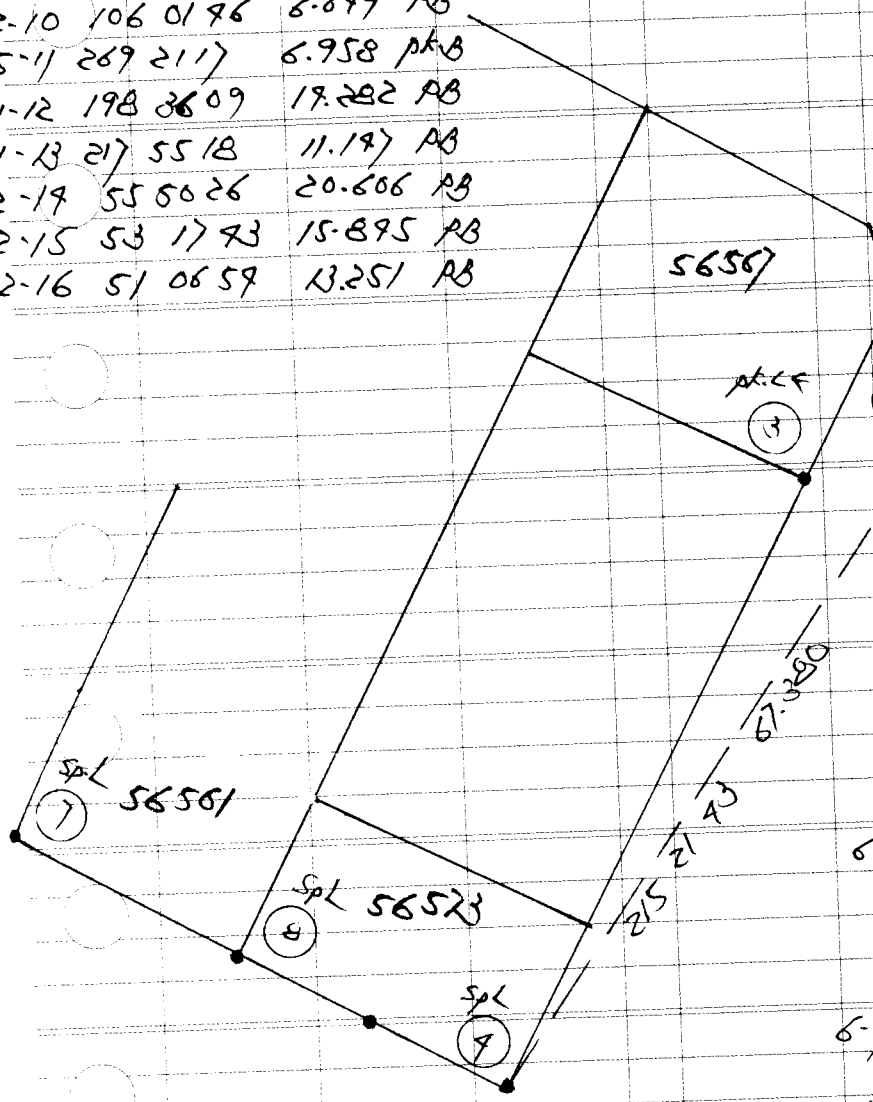

6-7	219 17 11	89.563 ~
	219 17 11	63.69.563 PO
	Ni/	Ni/
6-7	299 57 56	88.907 ~
	299 58 09	88.909 PO
	- 8'	- 0.002

No. Fail

JR 298 Jinjang

Rajah di muka

Stesen	BEARING / SUDUT			Dari Stn.	GARISAN		Ke Stn.	Sudut Pukak ($\pm$)	Jarak	Suhu	Jarak Antara Tupang	Jarak Mukamat
	Penyilang Kiri	Penyilang Kanan	Purata		Bearing Mukamat							
	Datum PB	Danjarda m/s 23		1	285 09 09		2	4	42.65	5/8/16		42.65
2	285 09 09	65 09 09	227 11 25	1	227 11 25		20	4	28.788			28.788
1	20	227 11 25	87 11 25									
	pkt.											
20-21	258 20 37	19.730	PL				20-29	159 29 07	9.959		HWP Grid 1A	
20-22	261 57 11	15.625	pk.L				20-30	118 42 10	7.191		HWP Grid 1C	
20-23	305 20 31	12.515	PL				20-31	82 19 48	8.851		HWP Grid 1A	
20-24	317 00 59	11.470	PL				20-32	198 06 25	6.299		HWP Grid 3E	
20-25	391 41 17	11.050	PB				20-33	119 32 07	1.191		HWP Grid 3C	
20-26	59 36 39	13.904	AB PL				20-34	40 51 17	5.352		HWP Grid 3A	
20-27	76 21 11	19.025	AB PL				20-35	295 33 39	7.758		HWP Grid 5G	
20-28	160 50 15	13.891	pk.L				20-36	298 18 08	4.671		HWP Grid 5C	
							20-37	396 46 22	7.012		HWP Grid 5A	