

J2375 Sambar.

Datum Danipada		2 169 3838		1	4	29/11/17 191.957	191.957		
GPS		pkB		pkB					
2	398 3838	169 3838	168 9118	1	168 9118	3	4	63.063	63.063
1									-
3	168 9118	398 9118							
	pkB								
1	398 9118	168 9118	168 9150	3	168 9150	4	4	62.753	62.753
3									
4	168 9150	398 9150							
	pkB								
3	398 9150	168 9150	90 9655	4	90 9655	5	4	183.989	183.989
4									
5	90 9655	270 9655							
	pkB								
3	Sept Di Abu	270 0052	4	270 0052	6	4	352.297	352.297	
4									
6	270 0052	70 0052							
	pkB								
6-7	71 5758			6	71 5758	7	4	22.769	SPL 22.769
6-8	39 3112			6	39 3112	8	4	38.180	pkLE 38.180
6-9	279 3659			6	279 3659	9	4	12.237	BKL 12.237
5-10	4 3230			5	4 3230	10	4	33.71	BKL 33.71
2-11	89 0027			2	89 0027	11	4	19.799	SPL 19.799

989	2	399 3838	169 3838	189 2857	1	189 2857	12	4	55.537	55.537
	12	189 2857	4 2857							
		pk.B								
063	1	4 2857	189 2857	263 5313	12	263 5313	13	4	102.592	102.592
	12									
	13	263 5313	83 ⁵³ 2813							
		pk.B								


		Demarcate.							
989	3-19	270 8638		3	270 8638	19	4	13.905	pk.B 13.905
	3-15	288 5338		3	288 5338	15	4	22.886	pk.B 22.886
	12-16	399 3918		12	399 3918	16	4	99.309	pk.B 99.309
	12-17	338 1359		12	338 1359	17	4	95.705	pk.B 95.705
297	13-18	180 2239		13	180 2239	18	4	2719	pk.LE 2719
	13-19	399 1716		13	399 1716	19	4	92.338	pk.B 92.338

11-7 228 2793 389.809 ✓
 228 2799 389.793 00

 -67 70.01

11-18 203 0009 225.923 ✓
 203 0008 225.917 00

 -17 70.006

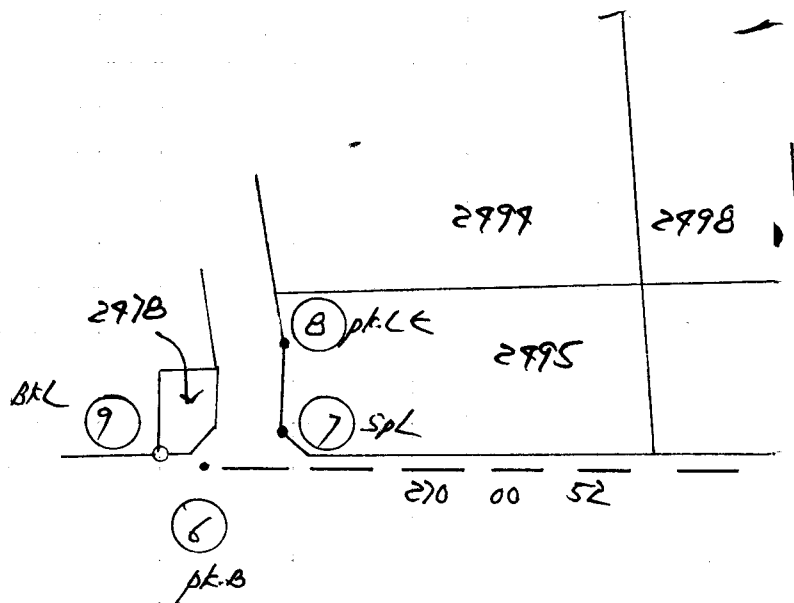

PEKAN BUKIT KERAYANG
DAERAH SEMBILAN
D TANPA SKALA

