


Rajah di muka

[illegible]

[illegible]

No. Fail


Rajah di muka

Stesen	BEARING / SUDUT			Dari Stn.	GARISAN		Ke Stn.	Sudut Pukak (±)	Jarak	Suhu	Jarak Antara Tupang	Jarak Muktar
	Penyilang Kiri	Penyilang Kanan	Purata		Bearing Muktamat							
5	100 35 35	280 35 35 10 96 19	10 96 19	6	10 96 19	11	4	129.985				129.9
6												
11	10 96 19	190 96 19										
6	190 96 19	10 96 19	0 10 18	11	0 10 18	12	4	29.996				29.99
11												
12	0 10 18	180 10 18										
	pk.B											
11-13	296 20 99			11	296 20 99	13	4	9.979			pk.L	9.97
11-19	336 26 56			11	336 26 56	19	4	7.707			pk.L	7.707
12-15	102 20 28			12	102 20 28	15	4	36.758			pk.L	36.7
12-16	99 99 55			12	99 99 55	16	4	36.781			pk.L	36.7
11	180 10 18	0 10 18	98 37 29	12	98 37 29	1	4	62.617				62.6
12												
1	98 37 29	278 37 29										
12	278 37 29	98 37 29	189 25 09	1	189 25 09	2	Sila Lekat m/s 5 R 1					
1												
2	189 25 09	9 25 09										
	Demarcate.											
1-20	270 97 99	2.022	pk.B						10-28	99 36 21	5.933	pk.B
2-21	330 20 95	2.929	pk.B						10-29	5 58 90	23.578	pk.B (R)
5-22	327 05 28	10.962	pk.B						10-30	9 19 15	28.056	77
5-23	208 08 32	13.565	pk.B						6-31	192 01 95	6.566	pk.B (R)
5-24	191 33 09	37.201	pk.B						6-32	395 99 11	3.896	pk.B
10-25	161 95 47	63.998	pk.B						6-33	5 22 38	28.162	pk.B
10-26	155 53 19	22.926	pk.B						11-39	200 23 39	25.150	pk.B
10-27	192 29 27	10.209	pk.B						11-35	203 27 51	25.909	pk.B
									11-36	295 36 11	7.721	pk.B
									12-37	120 45 59	2.169	pk.B

Stesen	BEARING / SUDUT			Dari Stn.	GARISAN	Ke Stn.	Sudut Pukak ($\pm$)	Jarak	Suhu	Jarak Antara Tupang	Jarak Mukamat
	Penyilang Kiri	Penyilang Kanan	Purata								
				WILAYAH PERSEKUTUAN	KEKALAH LUMPUR						
					BAHAGIAN KUALA LUMPUR						
					SEKSYEN 31						
					TANPA STAKA						

No. Fail

Rajah di muka

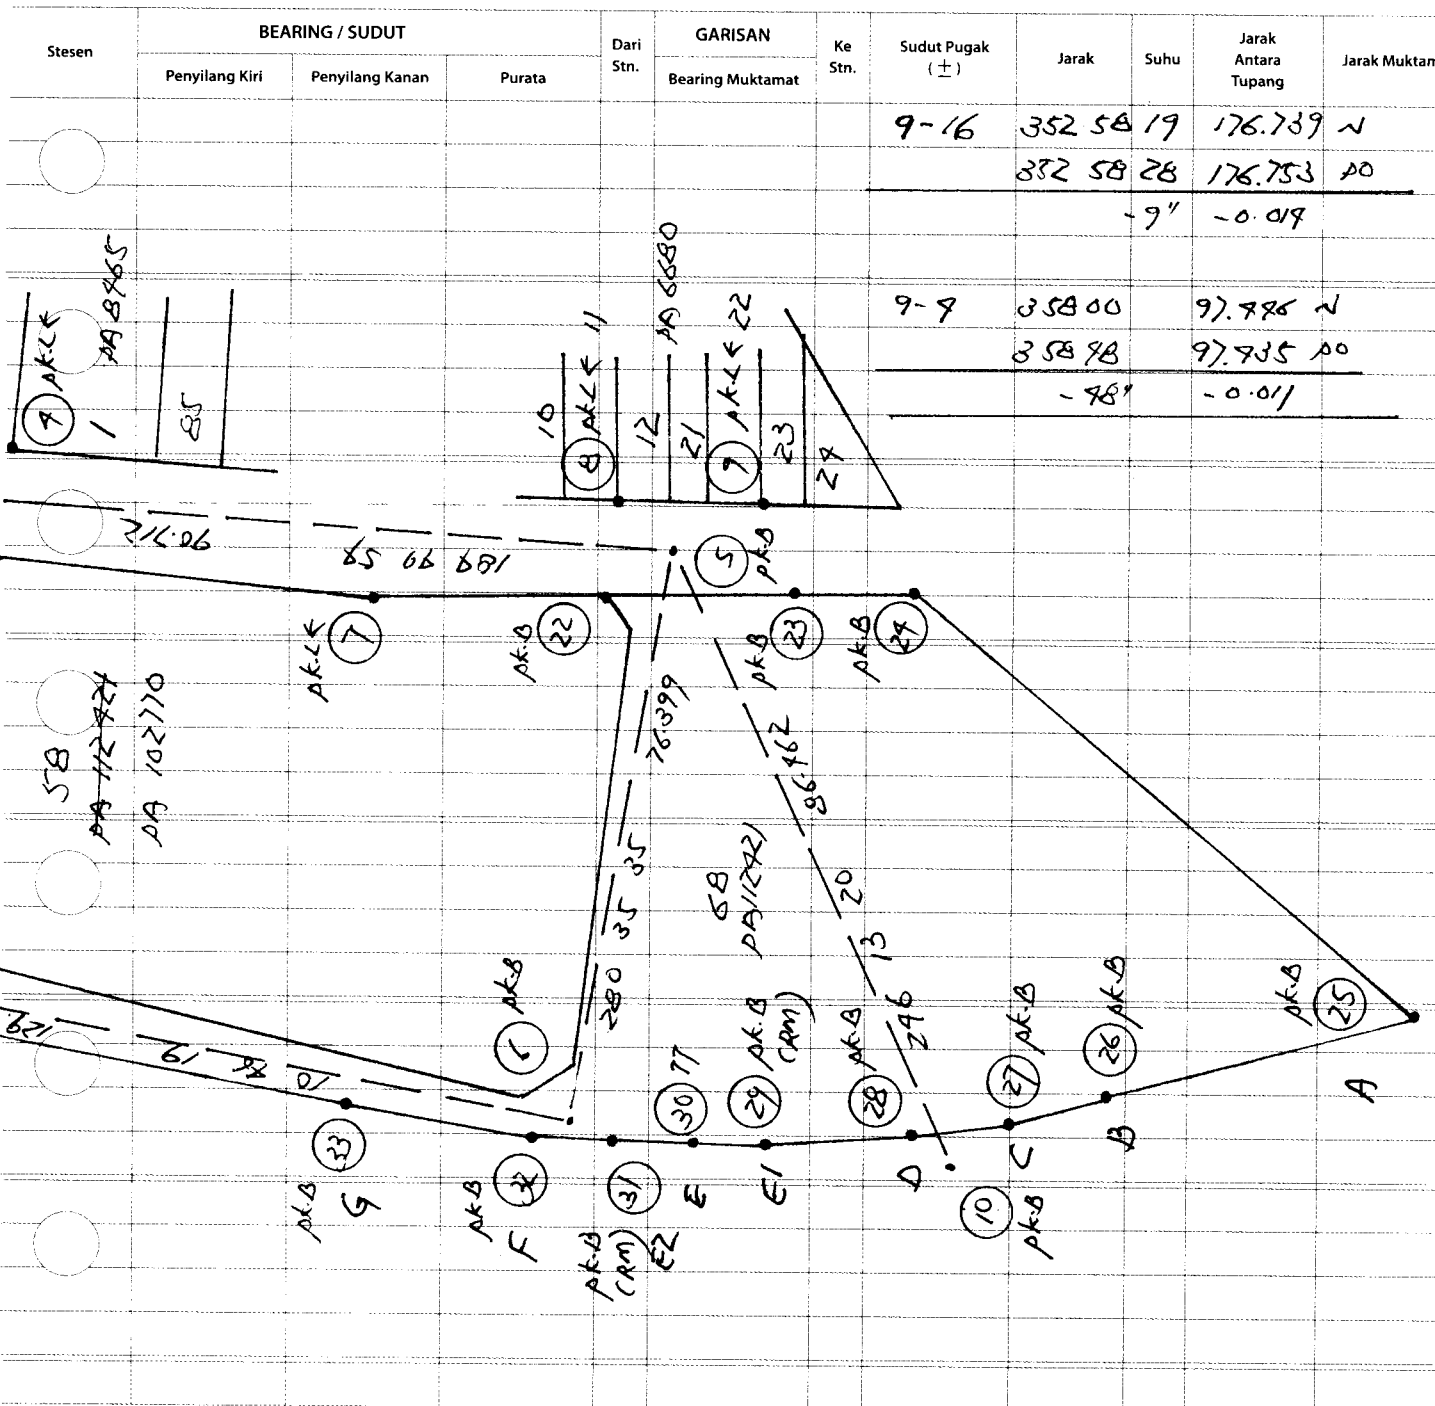

JE 091 Generate.


18/1/2008

10-A	1619597	63.998	pkB
10-B	1555319	22.926	pkL
10-C	1922927	10.209	pkB
10-D	993621	5.933	pkB
10-E1	55890	23.578	pkL (RM)
10-E	91915	28.058	TJ
6-E2	1920195	6.506	pkL (RM)
6-F	3959911	3.896	pkB
6-G	52238	28.162	pkB
11-H	2002339	25.150	pkB
11-I	2032751	25.909	pkB
11-J	2953611	9.721	pkB
11-K	2962099	9.779	pkB
11-L/M	3362856	7.707	Spl (78m)

