

2-3	28/5957	28	0380	27.72					BAL 27.72
2-4	279 1838	279	0856	29.483					BAL 29.483
2-5	307 9119	307	9933	40.951					pk.B 40.951
2-6	329 1329	329	5017	16.995					pk.L (1) 16.995
1	325 0502	175 0502	106 1722	2	106 1722	7	931712	51.867	51.867
2	7	106 1722	286 1722	pk.L ←					
2	286 1722	106 1722	182 0056	7	182 0056	8	92 0219	62257	62257
7	8	182 0056	2 0056	pk.B					
2-9	95 5917	2	95 5917	9	92 5832	51.856			51.856
8-10	171 1051	8	171 1051	10	90 9803	31.298			31.298
7	2 0056	182 0056	188 2919	8	188 2919	11	92 0219	85.179	85.179
8	11	188 2919	8 2919	pk.B					
8	8 2919	188 2919	299 1519	11	299 1519	12	95 2538	60.059	60.059
11	12	299 1519	119 1519	pk.B					

11	119 1519	299 1519	302 28 23	12	302 28 23	13	68 78 89 75.156
12							75.156
13	302 28 23	122 28 23					
	p.k.B						
12	122 28 23	302 28 23	398 38 98	13	398 38 98	17	883 219 152.039
13							152.039
17	398 38 98	168 38 98					
	p.k.B						
13	168 38 98	398 38 98	83 57 32	17	83 57 32	15	69 29 29 38.763
17							38.763
15	83 57 32	263 57 32					
	p.k.B						
17	263 57 32	83 57 32	83 72 01	15	83 72 01	1	82 09 20 27.286
15							27.286
1	83 72 01	263 72 01					
15	263 72 01	83 72 01	195 05 02	1	195 05 02	2	S/L Liket m/s 5 R/
1							
2	195 05 02	325 05 02					
	Boring						
	Turturup.						
1-16	399 95 21						
1-17	399 03 37						
1-18	392 99 19						
1	399 95 21	16	86 09 03	57.899		BKL	57.899
1	399 03 37	17	88 99 30	30.157		BKL	30.157
1	392 99 19	18	93 13 38	15.199		BKL	15.199

No. 1411

English

16-9 165 1792 122.381 ~
 165 1822 122.308 AO
 +1' 20" 70.073

14-3 163 4930 119.559 ~
 163 4835 119.491 AO
 +55" 70.063

16-18 165 2328 72.658 ~
 165 2500 72.683 AO
 3 28" -0.005


16-17 165 3076 27.692 ~
 165 2500 27.685 AO
 +0.007

16-7 358 2399 93.183 ~
 358 2258 93.177 AO
 +76" 70.073

16-9 359 3225 102.288 ~
 359 3150 102.289 AO
 +85" 70.020

Dinant BKB (22/1/18)

1-20	269 39 01	0.796	pk.B
1-21	168 18 11	97 18 18	19.600 pk.B
15-22	69 11 98	93 30 00	7.083 PB
15-23	151 13 37	96 27 51	19.781 PB
19-27	65 59 37	93 10 29	12.164 pk.B
19-25	99 18 57	86 57 58	13.126 pk.B
19-26	129 50 35	88 22 08	17.918 pk.B
15-20	83 32 08	78 41 52	26.547 pk.B

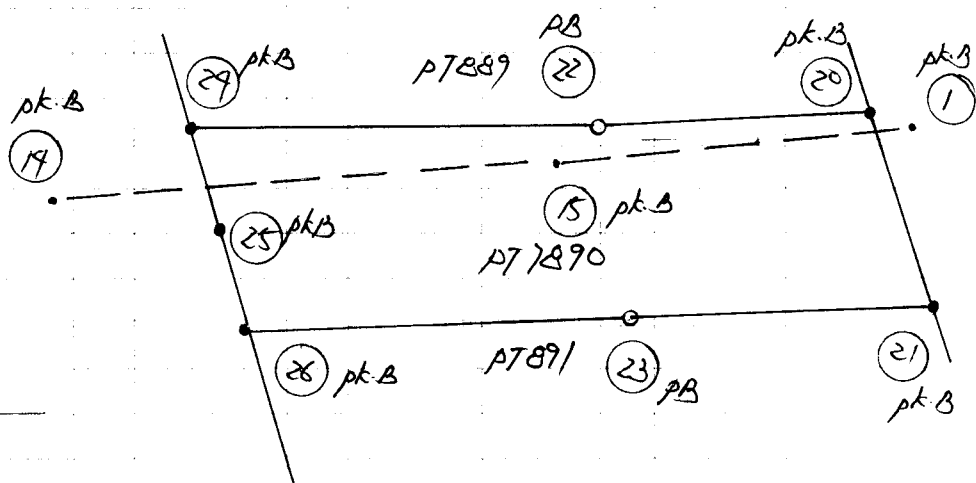

No. Fail

Rajah di muka

