


J2389a Arching Jaya Transmission Line.

Datum Dairipads				7/9/18		
203-209	12/1990	203 122 1198200	H	179.176		179.176
		Aj At.				
		Ajn 625				
203-209	12/1990	203 12/1990 209	H	197.797	787 JAMI	197.797
203-205	12/0202	203 12/0202 205	H	127.729		127.729
203-206	293608	203 293608 206	H	70.065	BKL	70.065
203-207	3572529	203 3572529 207	H	19.867	pkL	19.867
203-208	12/2930	203 12/2930 208	H	107.930	pkL	107.930

176
797
727
055
867
830

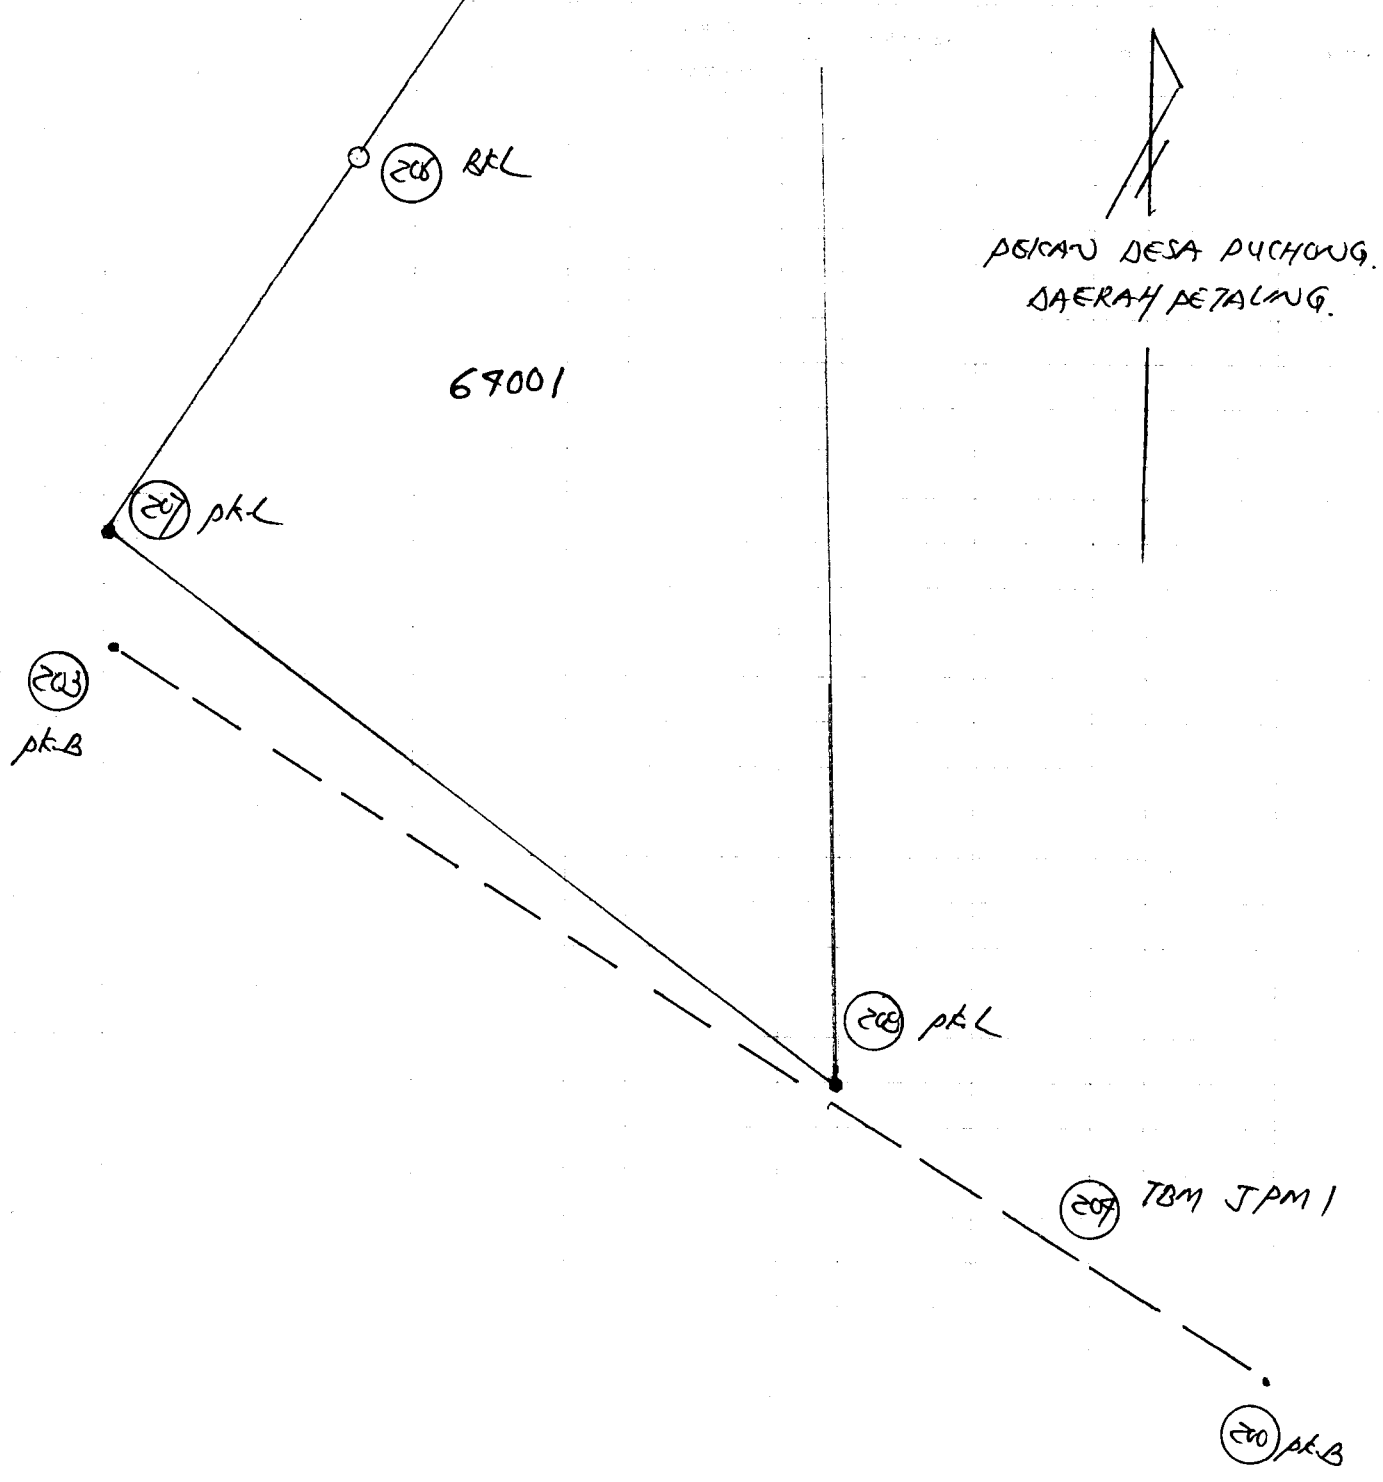

DEKAT DESA PUCHONG,
DAERAH PETALING.