

J2455 Kundang

No. Fail

Rajah di muka

Datum Banjar

2 824811 1 4
 ptB Ag At. ptB
 Dgn 625

15/11/18
170.233

170.233

1 824811 2624811 3565927 2 3565927 3 4

58.883

58.883

3 3565927 1765927
ptB

1 Seperti Di Atas 2522811 2 2522811 4 4

178.020

178.020

4 2522811 722811
ptB2-5 101157
3-6 1139392 101157 5 4
3 113939 6 432.687
47.060PL
PL32.687
47.060

2 722811 2522811 2935899 4 2935899 7 4

68.896

68.896

7 2935899 1135899
ptB

7-8 415021 2
 7-9 3291291
 7-10 2900717
 7-11 2724809

7 415021 8 4
 7 3291291 9 4
 7 2900717 10 4
 7 2724809 11 4

109.318
 98.717
 57.595
 51.526

AtL
 AtL
 AtL
 AtL

109.318
 98.717
 57.595
 51.526

No. Fail


Rajah muka

Stesen	BEARING & JUDIT			Dati Stu	GARISAN dealing Muklamat	Ke Str	Sudut Pagar (°)	Jarak	Subu	Jarak Antara Tiang	Jarak Muxamat
	Pengasing Kiri	Pengasing Kanan	Potang								

Demarcate:

1-20	250009	17.626	PB
1-21	3902129	48.598	PB
3-22	78 0617	139.916	pk.B
3-23	173523	37.129	PB
3-29	1981036	16.989	PB

DAERAH GOMBAK
MUKIM RAWANG.
TANPA SKALA

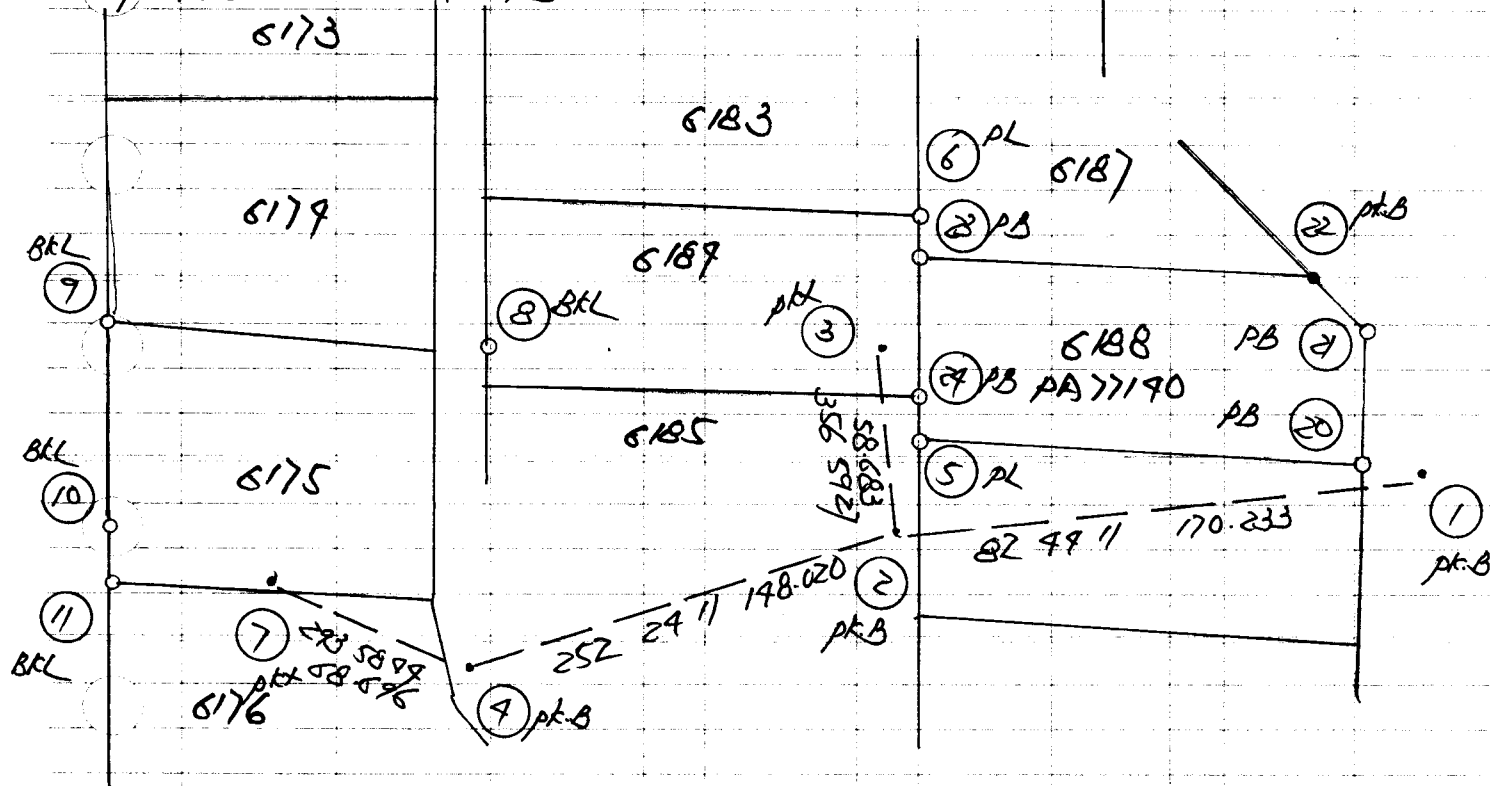

5-11	2595906	285.218	N
	2595339	285.299	PO
	+7"	-0.026	

5-7	978038	22.629	N
	978936	22.665	N/PO
	+1 2"	-0.026	

33

Horiz. Dist.	Ht. Diff. + or -	RL of Inst.	RL Centre Reading	m	RL Object	Remarks
1.7329					32.721	(F1) 78M F3335 GAS
7.5685			0.2550		33.9889	941
2.8563			1.1797 (37.2380)		37.2380	942
			1.3303 (38.369)		38.369	78M F3336
8.767			2.7647			
					BM B249	
					BM B1173	
					GAS Level: 48.698	
					BM Level: 48.524	
					70.129	
					F1 / 78M F3335	
					GAS Level: 32.595	
					constant: - 0.129	
					32.721	