

JZ630 Santa I.

No. Fail

Rajah di muka

[illegible]



No. Fail

Rajah di muka

Stesen	BEARING / SUDUT			Dari Stn.	GARISAN		Ke Stn.	Sudut Pagak (±)	Jarak	Suhu	Jarak Antara Tupang	Jarak Mukamat
	Penyilang Kiri	Penyilang Kanan	Purata		Bearing Mukamat							
13-15	66 70 32			13	66 70 32	15	H	10.110			PL	10.110
14-16	130 17 45			14	130 17 45	16	H	13.321			PL	13.321
14-17	32 49 45			14	32 49 45	17	H	11.739			pk LC	11.739
13	79 52 09	259 52 09	37 26 01	14	37 26 01	1	H	59.167				59.167
14	37 26 01	18 7 28 01										
14	16 7 28 01	37 28 01	75 02 38	1	75 02 38	2	SfH	Lihat m/s	33 R/			
2	75 02 38	255 02 38			Bering Tutup							
2	209 59 25	29 59 25	179 21 36	3	179 21 36	25	H	67.581				67.581
25	179 21 36	329 21 36										
3	329 21 36	179 21 36	50 40 13	25	50 40 13	26	H	67.696				67.696
26	50 40 13	230 40 13										
25	230 40 13	50 40 13	130 43 01	26	130 43 01	27	H	33.039				33.039
27	130 43 01	310 43 01										
26-28	21 59 30			26	21 59 30	28	H	9.190			PL	9.190
27-29	1 22 25			27	1 22 25	29	H	17.470			PL	17.470
27-30	201 56 30			27	201 56 30	30	H	6.750			BAL	6.750

Demarcate Galine mark.

4-31 17 38 21 21.368 HWP
 4-32 17 38 16 42.718 HWP.

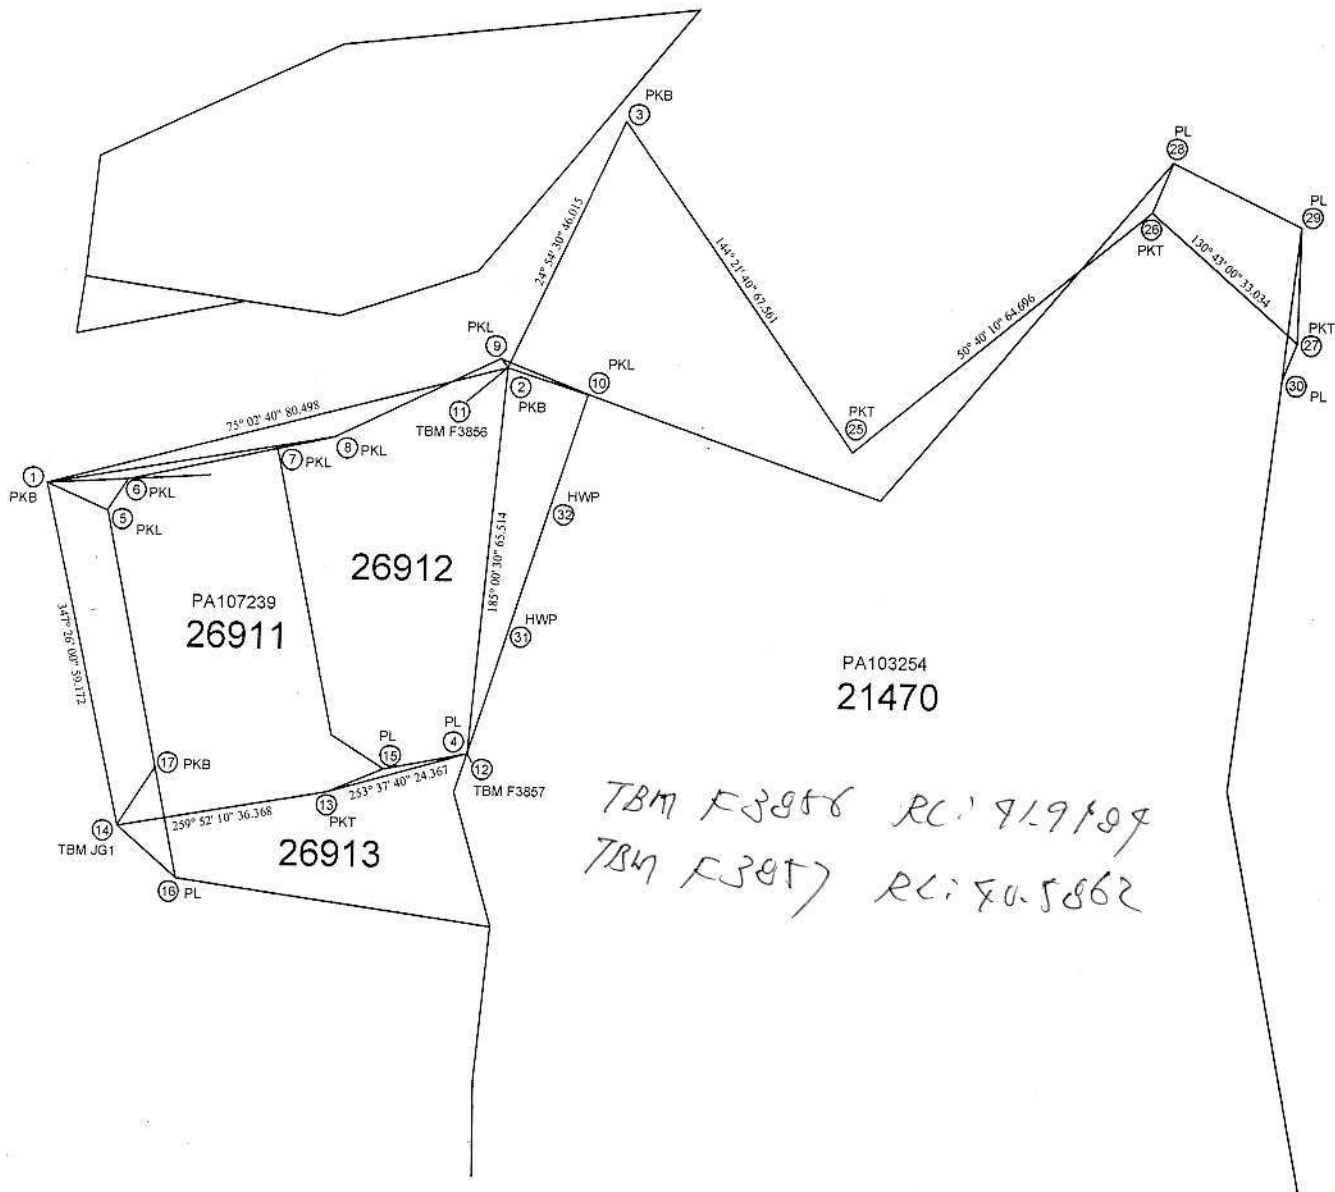

Location

42

Purpose J2630 Sentul.

Horiz. Dist.	Ht. Diff. + or -	RL of Inst.	RL Centre Reading	m	RL Object	Remarks
0.7196					42.9309	F1
	1.7316				41.9189	TBM R3856
1.3835		0.7009			42.6996	SP1
	3.7669				40.5862	TBM R3857
		1.2811			42.712 -	TBM JG1
						↑
1.7631		1.9845				From JG.
						BM B61095
					GPS (re/1:	57.176
					BM (re/1	57.069
						0.107
						TBM JG1
					GPS (re/1:	42.833
					constant	0.107
					foo	42.726
					↑	
					From BM	