

JZ630 Sentul.

No. Fail

Rajah di muka

[illegible]

Stn 11 → TBM K3856 RL: 91.91034
 Stn 12 → TBM K3857 RL: 90.5862

No. Fail


Rajah di muka

Stesen	BEARING / SUDUT			Dari Stn.	GARISAN		Ke Stn.	Sudut Pugak (±)	Jarak	Suhu	Jarak Antara Tupang	Jarak Mukamat
	Penyilang Kiri	Penyilang Kanan	Purata		Bearing Mukamat							
13-15	669032			13	669032	15	H	4	10.110		PL	10.110
14-16	130 1795			14	130 1795	16	H	4	13.321		PL	13.321
14-17	324995			14	324995	17	H	4	11.739		pkLE	11.739
13	795209	2595209	3472801	14	3472801	1	H	4	59.167			59.167
14	3472801	1872801										
1	3472801	1872801										
14	1672801	3472801	750238	1	750238	2	Sila	Lihat m/s	33 R/			
2	750238	2550238			Bering Tertutup							
2	2095925	295925	1942136	3	1942136	25	H	4	67.561			67.561
3	1942136	3242136										
25	3242136	1942136	504013	25	504013	26	H	4	64.696			64.696
26	504013	2304013										
25	2304013	504013	1304304	26	1304304	27	H	4	33.034			33.034
27	1304304	3104304										
26	215930			26	215930	28	H	4	9.190		PL	9.190
27-29	12225			27	12225	29	H	4	19.470		PL	19.470
27-30	2015630			27	2015630	30	H	4	6.750		BKL	6.750

Demarcate Galine mark.

4-31 17 38 21 21.368 HWP
 4-32 17 38 16 42.718 HWP plus

4-31 17 38 21 21.388 (HWP) (X)
 4-32 17 38 16 42.718 (PKB) (Y)
 4-33 197 37 15 3.833 PK.L (M)
 13-34 128 45 16 35.597 PK.L (N)
 13-35
 14-16 130 17 45 13321 PK.L (P)

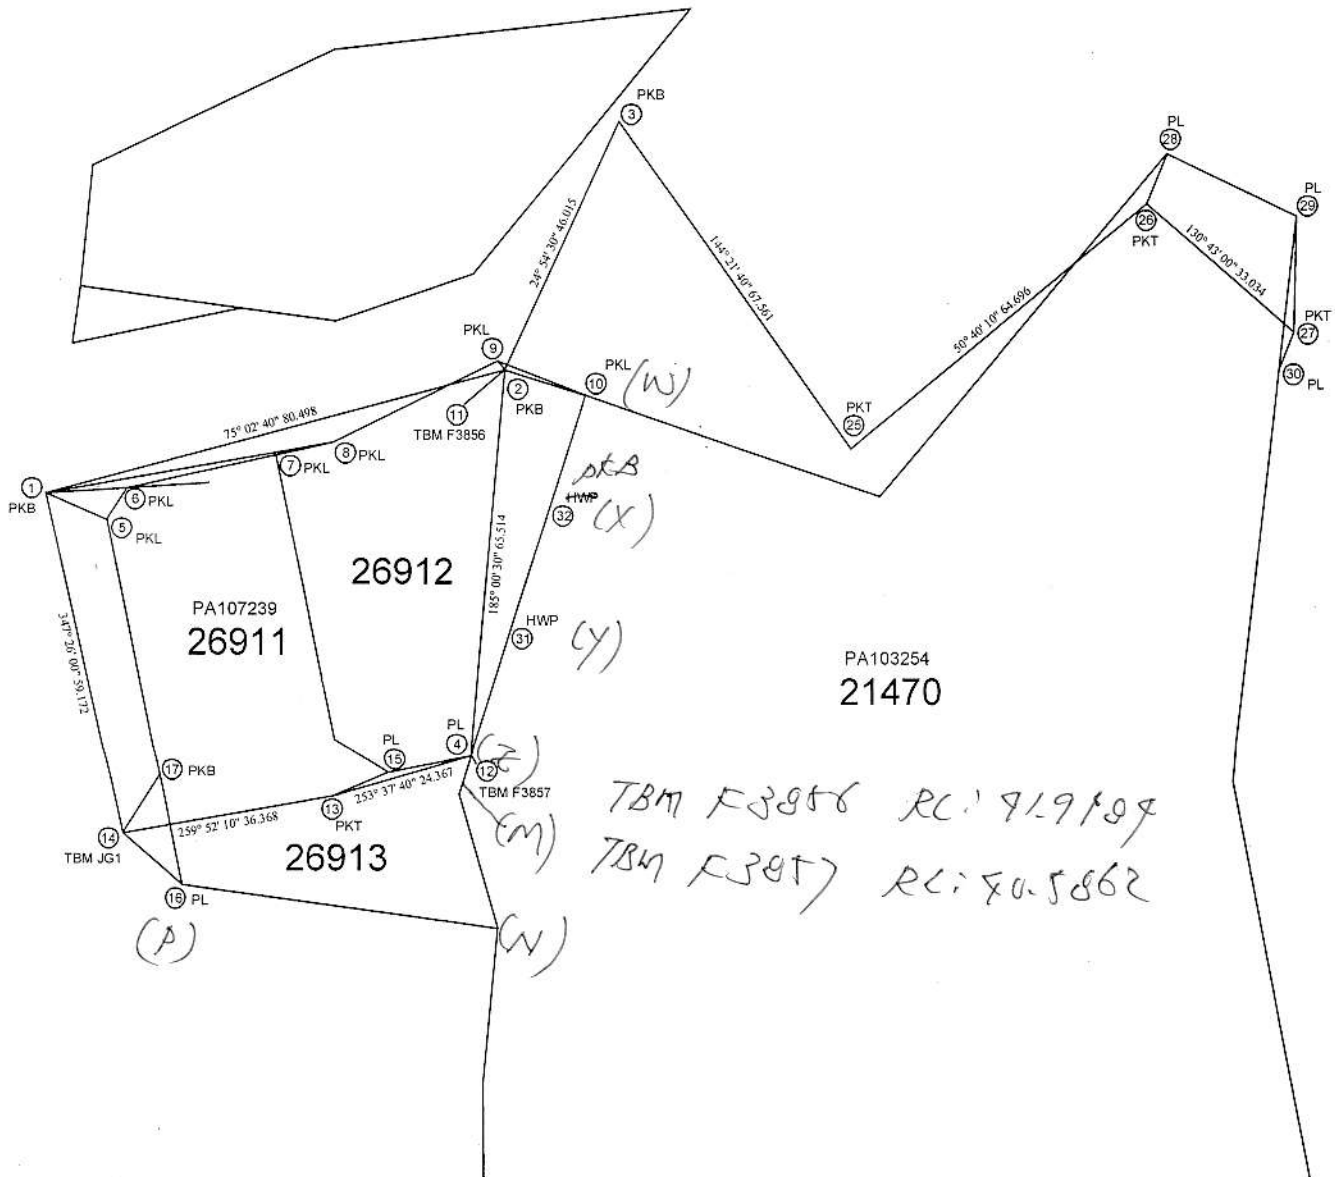

TBM F3856 RC: 71.9187
 TBM F3857 RC: 70.5862

Location

42

Purpose J2630 Sentul.

Horiz. Dist.	Ht. Diff. + or -	RL of Inst.	RL Centre Reading	m	RL Object	Remarks
0.7196					42.9309	PI
	1.4316				41.9189	TBM R3856
1.0735		0.7007			42.6796	PI
	3.7669				40.5862	TBM R3857
		1.2811			42.712 -	TBM J61
						↑
1.7631		1.9815				from J6.
						BM B61095
					GPS level:	57.176
					BM level:	57.069
						<u>0.107</u>
						TBM J61
					GPS level:	42.833
					constant	<u>0.107</u>
					foo	42.726
					↑	
					from BM	