

No. Fail


Rajah di muka

[illegible]

No. Fail

Rajah di muka

Stesen	BEARING / SUDUT			Dari Stn.	GARISAN	Ke Stn.	Sudut Pukak (±)	Jarak	Suhu	Jarak Antara Tupang	Jarak Mukamat
	Penyilang Kiri	Penyilang Kanan	Purata		Bearing Mukamat						
12	88 57 59	268 57 59	180 16 18	13	180 16 18	11	4	27.478			27.478
13											
11	180 16 18	0 16 18									
13	0 16 18	180 16 18	106 75 20	11	106 75 20	10	Sila Lihat m/s 17 r 5.				
11					Bering Tertutup.						
10	106 75 20	286 75 20									
9	289 33 10	59 33 10	162 09 47	10	162 09 47	14	4	6.625		pk. LE	6.625
10											
14	162 09 47	342 09 47									
	pk LE										
	Demarcate.										
9-20	73 05 39			9	73 05 39	20	4	12.121		77	12.121
9-21	73 73 16			9	73 73 16	21	4	11.971		pk B (Rm)	11.971
12-22	38 79 13			12	38 79 13	22	4	7.855		77	7.855
12-23	76 07 40			12	76 07 40	23	4	7.166		pk B (Rm)	7.166
13-29	398 05 33			13	398 05 33	29	4	7.961		77	7.961
13-25	395 78 57			13	395 78 57	25	4	7.286		pk B (Rm)	7.286

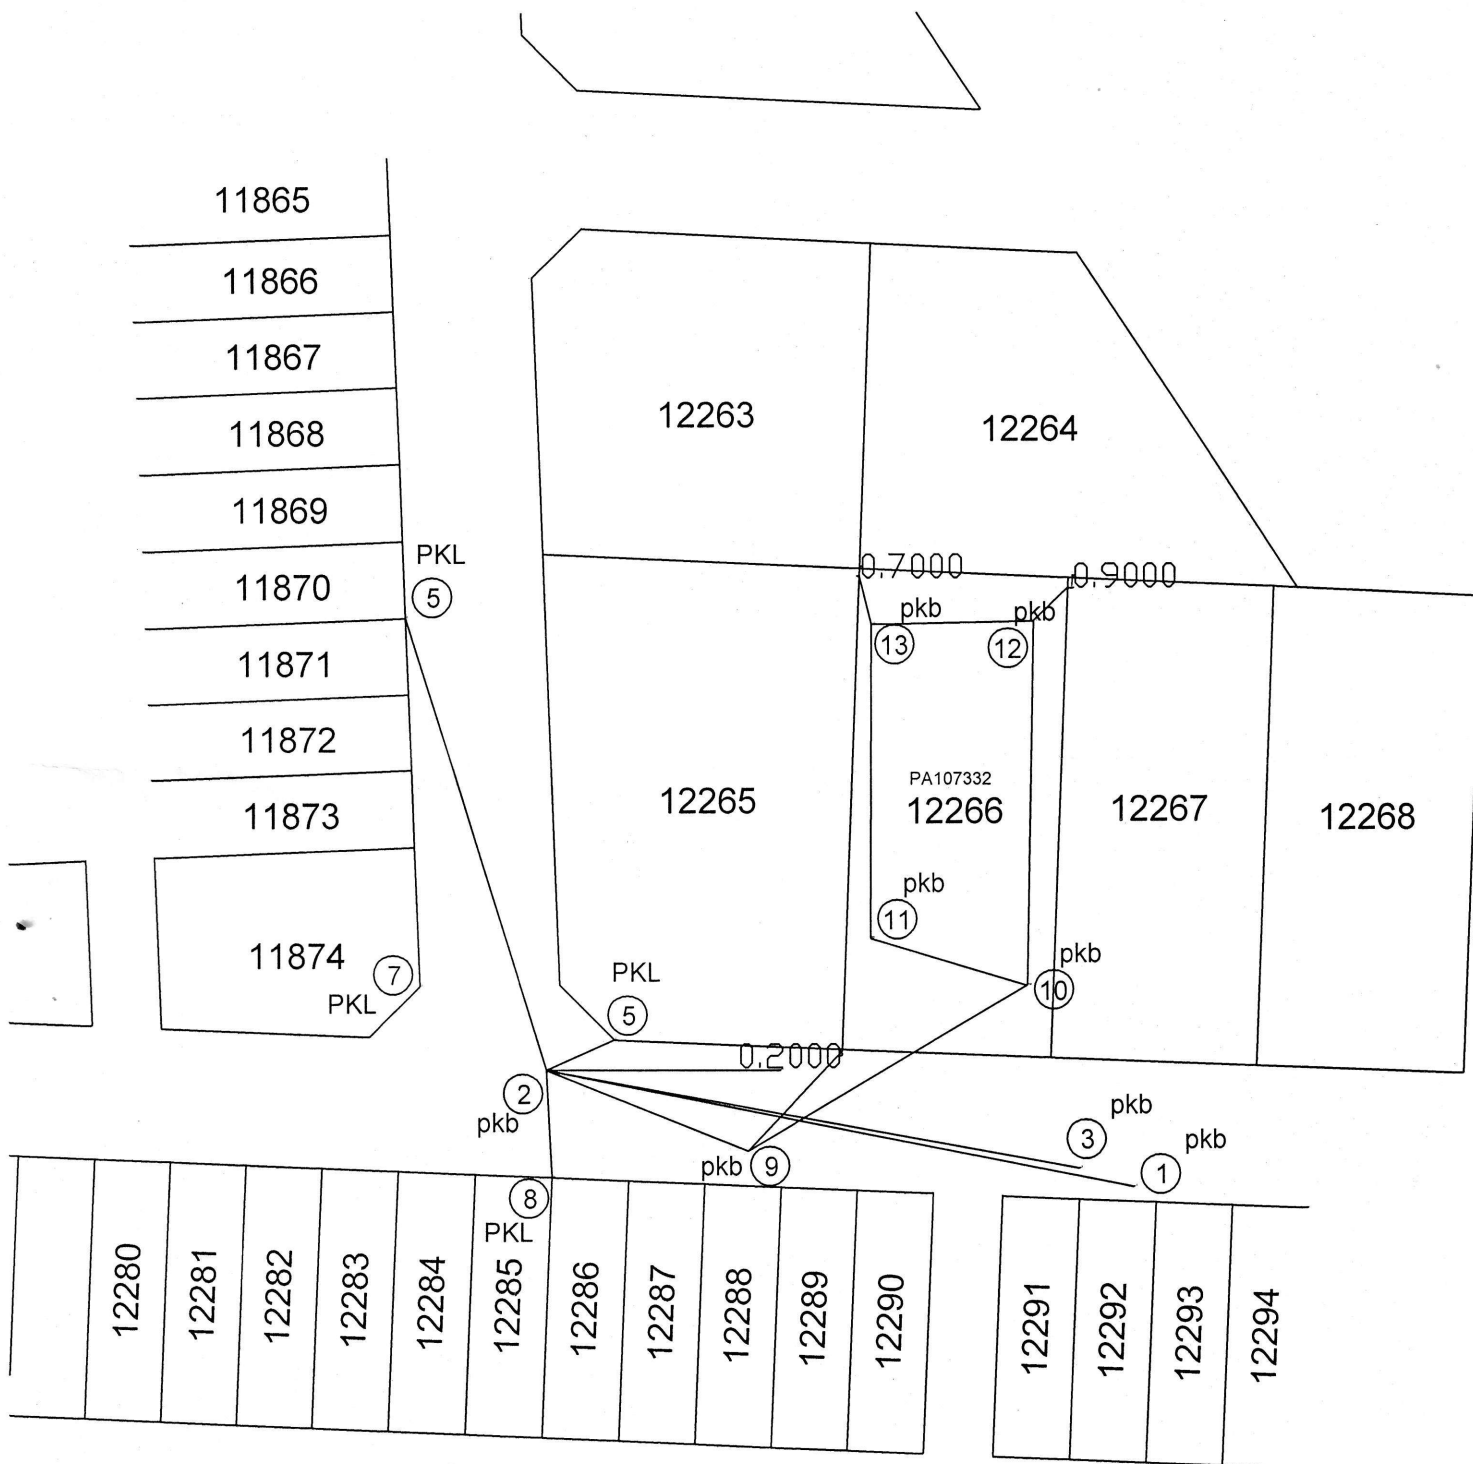

29/83

0.3337

0.5184

1.6337

1.1853

82.0590

F2

87.6736

7BM F3889

87.4589

F3

83.3739

F9

83.7920

7BM F3885

BM 80725

BM Lev/ : 81.482

GPS Lev/ : 81.482

Nt/

F2

GPS Lev/ : 82.059