

No. Fail J2667 Ulay Bandara Tokong

Rajah di muka

Stesen	BEARING / SUDUT			Dari Stn.	GARISAN		Ke Stn.	Sudut Pukak (±)	Jarak	Suhu	Jarak Antara Tupang	Jarak Muktamat
	Penyilang Kiri	Penyilang Kanan	Purata		Bearing Muktamat							
○	Datum	Diripada		2	181/1052		1	H	78.297	21/9/23		78.297
					Ag Ak.							
					Ag mH							
2-3	1863/56			2	1863/56		3	H	67.980		pkL	67.980
2-4	1881/53			2	1881/53		4	H	52.936		pkL	52.936
2-5	2050875			2	2050875		5	H	17.858		BK	17.858
②	1 181/1052	1 1052	357274	2	357274		6	H	70.185			70.185
	6 357274	179274										
	pkA											
②	1 Spriti Di Atas	2362946		2	2362946		7	H	37.532			37.532
	2362946	562946										
	pkB											
⑦	2 562946	2362946	189271	7	189271		8	H	35.777			35.777
	8 189271	7 271										
	pkC											
⑧	7 271	189271	761320	8	761320		1	H	38.027			38.027
	1 761320	2561320										
①	8 2561320	761320	1 1052	1	1 1052		2	H	38.027			
	2 1 1052	181 1052									Sila Lihat Atas R/	

Rajah di muka											
No. Fall				Dari Stn.	GARISAN	Ke Stn.	Sudut Pugak (+)	Jarak	Suhu	Jarak Antara Tupang	Jarak Mukdamat
Stesen	BEARING / SUDUT										
	Penyilang Kiri	Penyilang Kanan	Purata	Bearing Muklamat							
2	179 294	159 294	26 00 92	6	26 00 92	9	H	78.336			78.336
(6) 9	26 00 92	206 00 92									
6	pt.										
6	206 00 92	26 00 92	78.322	9	78.322	10	H	105.713			105.713
(9) 10	78.322	228.322									
10	pt.										
9	228.322	78.322	151.321	10	151.321	11	H	136.812			136.812
(10) 11	151.321	331.321									
11	pt.										
11-12	298.933				11	298.933	12	H	17.024	pkL	17.024
11-13	130.994				11	130.994	13	H	79.596	pkL	79.596

Penilik: JZ667 Ukay Perdana Tarikh: 21/09/2023

Stn. 1 Koordinat: U3252 T7914 Selangor

T.R. 2 B.K. Ms.

Tiodolit Satu bah. aras ufuk:


Waktu	Sasaran	Ufuk	Gelembong	Puguk
	T.R.	185 00 00		
8 46	M.H.	94 37 37	64 57 05	Waktu purata 8 46 30
8 46	M.H.	94 02 45	64 51 20	Beza dari U.T. - 8 00 00
8 47	M.H.	274 02 59	295 14 24	U.T. 0 46 30
8 47	M.H.	274 38 38	295 20 31	Deklinasi 0 52 33
	T.R.	5 00 00		

	T.R.	185 00 00		
8 48	M.H.	94 39 31	64 27 43	Waktu purata 8 48 30
8 48	M.H.	94 04 21	64 23 35	Beza dari U.T. - 8 00 00
8 49	M.H.	274 04 33	295 41 18	U.T. 0 48 30
8 49	M.H.	274 40 22	295 47 12	Deklinasi 0 52 31
	T.R.	5 00 00		

	Set 1	Set 2
Sudut pugak	25 11 38	25 39 18
Pembetulan	- 0 01 45	- 0 01 43
Altitud	25 09 53	25 37 35
Jarak kutub	89 07 27	89 07 29
Latitud	3 12 13	3 12 13
Azimut M.H. yang dikira	90 32 15	90 33 58
Purata ke M.H.	94 20 30	94 22 12
Selisih:	- 3 48 15	- 3 48 14
Purata ke T.R.	185 00 00	185 00 00
Azimuth T.R. sebenar	181 11 45	181 11 46
Pembetulan aras	+ 0 00 00	+ 0 00 00
Tirusan	- 0 00 54	- 0 00 54
Bering grid T.R.	181 10 51	181 10 52

Purata bering grid T.R. 181 10 52

2-1	0	20	49	36.579(New)
	0	21	20	36.576(Po)
	-31		0.003	
4-13	67	51	13	220.163(New)
	67	51	00	220.186(Po)
	13		-0.023	

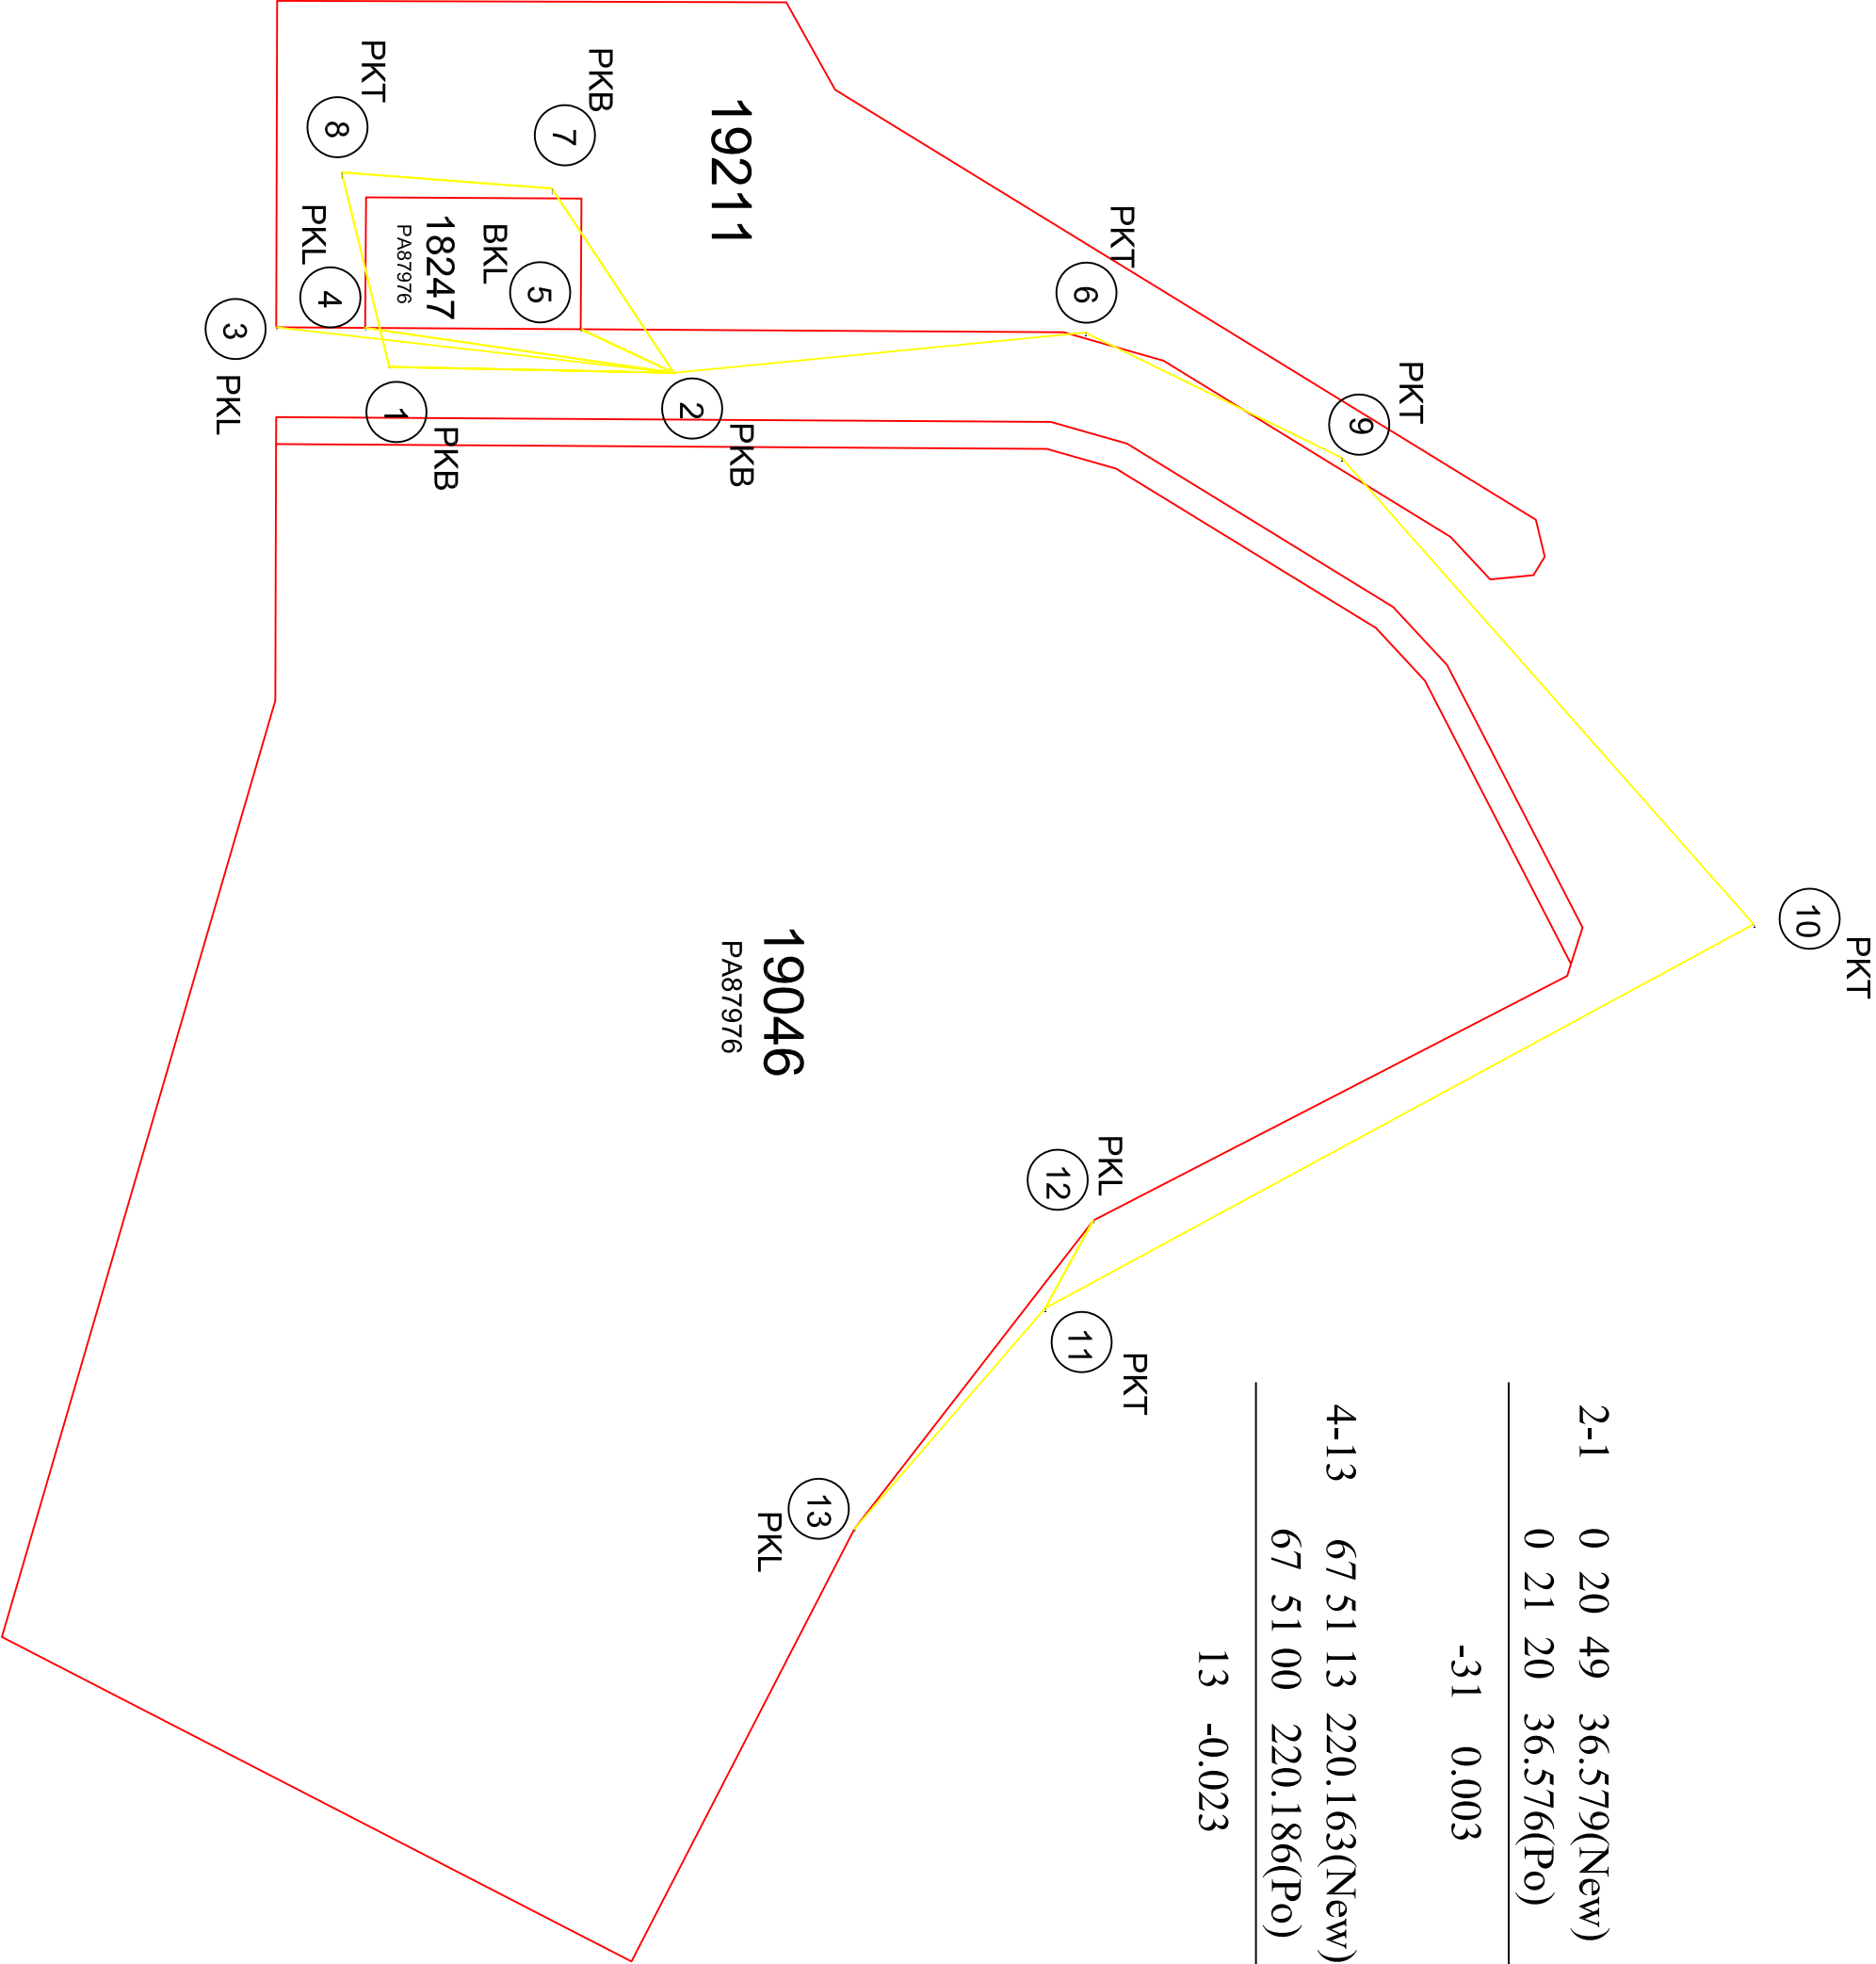

JE667 Ukay Perdana Tokong.

JE66

1.9507

1.5513

1.3353

1.9139

161.6052

162.0046

162.2206

161.742

TBM K3208

SIN F1

SIN F2

TBM K3209
baster ball

2.3728

2.39

0.176

BM B61058

BM 61062

BM B61060

GPS Level: 61.180

GPS Level: 50.329

GPS Level: 55.049

BM Level: 61.167

BM Level: 50.339

BM Level: 55.049

+0.013

-0.005

Base, 0.000

F1
GPS Level:
constant:

TBM K3209

GPS Level: 161.742

constant: 0.000