

No Fail

Rajah di muka

Stasiun	BEARING / SUDUT			Dari Stn.	GARISAN	Ke Stn.	Sudut Pukak (±)	29/3/89		Jarak Antara Tupang	Jarak Muktamat
	Penyilang Kiri	Penyilang Kanan	Purata		Bearing Muktamat			Jarak	Suhu		
	Datum	Danipada		1	413017	2	4	121.512			121.512
				pkB	A3 pk	pkB					
					Agg M4						
2-3	325 27 06			2	325 27 06	3	4	79.275		pkL	79.275
2-4	356 16 42			2	356 16 42	4	4	26.931		pkL	26.931
2-5	17 35 49			2	17 35 49	5	4	28.985		pkL	28.985
2-6	22 36 03			2	22 36 03	6	4	37.530		pkL	37.530
2-7	30 10 03			2	30 10 03	7	4	55.722		pkL	55.722
2-8	37 21 07			2	37 21 07	8	4	73.133		pkL	73.133
1-9	31 01 06			1	31 01 06	9	4	42.178		pkB	42.178

Penilik: JZ684 Thamby Abdulah Tarikh: 20/03/2024
 Stn. 2 Koordinat: S4999 B2396 W.P. Kuala Lumpur
 T.R. 1 B.K. Ms.
 Tiodolit Satu bah. aras ufuk:


Waktu	Sasaran	Ufuk	Gelembong	Puguk		
	T.R.	60 00 00				
8 54	M.H.	110 10 55		66 25 55	Waktu purata	8 54 30
8 54	M.H.	109 36 20		66 19 12	Beza dari U.T. -	8 00 00
8 55	M.H.	289 36 50		293 49 25	U.T.	0 54 30
8 55	M.H.	290 12 37		293 59 34	Deklinasi -	0 02 11
	T.R.	240 00 00				

	T.R.	60 00 00				
8 56	M.H.	110 13 19		65 50 26	Waktu purata	8 56 30
8 56	M.H.	109 38 37		65 42 44	Beza dari U.T. -	8 00 00
8 57	M.H.	289 39 09		294 27 20	U.T.	0 56 30
8 57	M.H.	290 14 59		294 34 45	Deklinasi -	0 02 09
	T.R.	240 00 00				

	Set 1	Set 2
Sudut pugak	23 45 58	24 22 14
Pembetulan	- 0 01 53	- 0 01 49
Altitud	23 44 05	24 20 25
Jarak kutub	90 02 11	90 02 09
Latitud	3 07 44	3 07 44
Azimut M.H. yang dikira	91 25 01	91 27 23
Purata ke M.H.	109 54 11	109 56 31
Selisih:	- 18 29 10	- 18 29 08
Purata ke T.R.	60 00 00	60 00 00
Azimuth T.R. sebenar	41 30 50	41 30 52
Pembetulan aras	+ 0 00 00	+ 0 00 00
Tirusan	- 0 00 34	- 0 00 34
Bering grid T.R.	41 30 16	41 30 18

Purata bering grid T.R. 41 30 17

JZ684 Thamby Abdullah

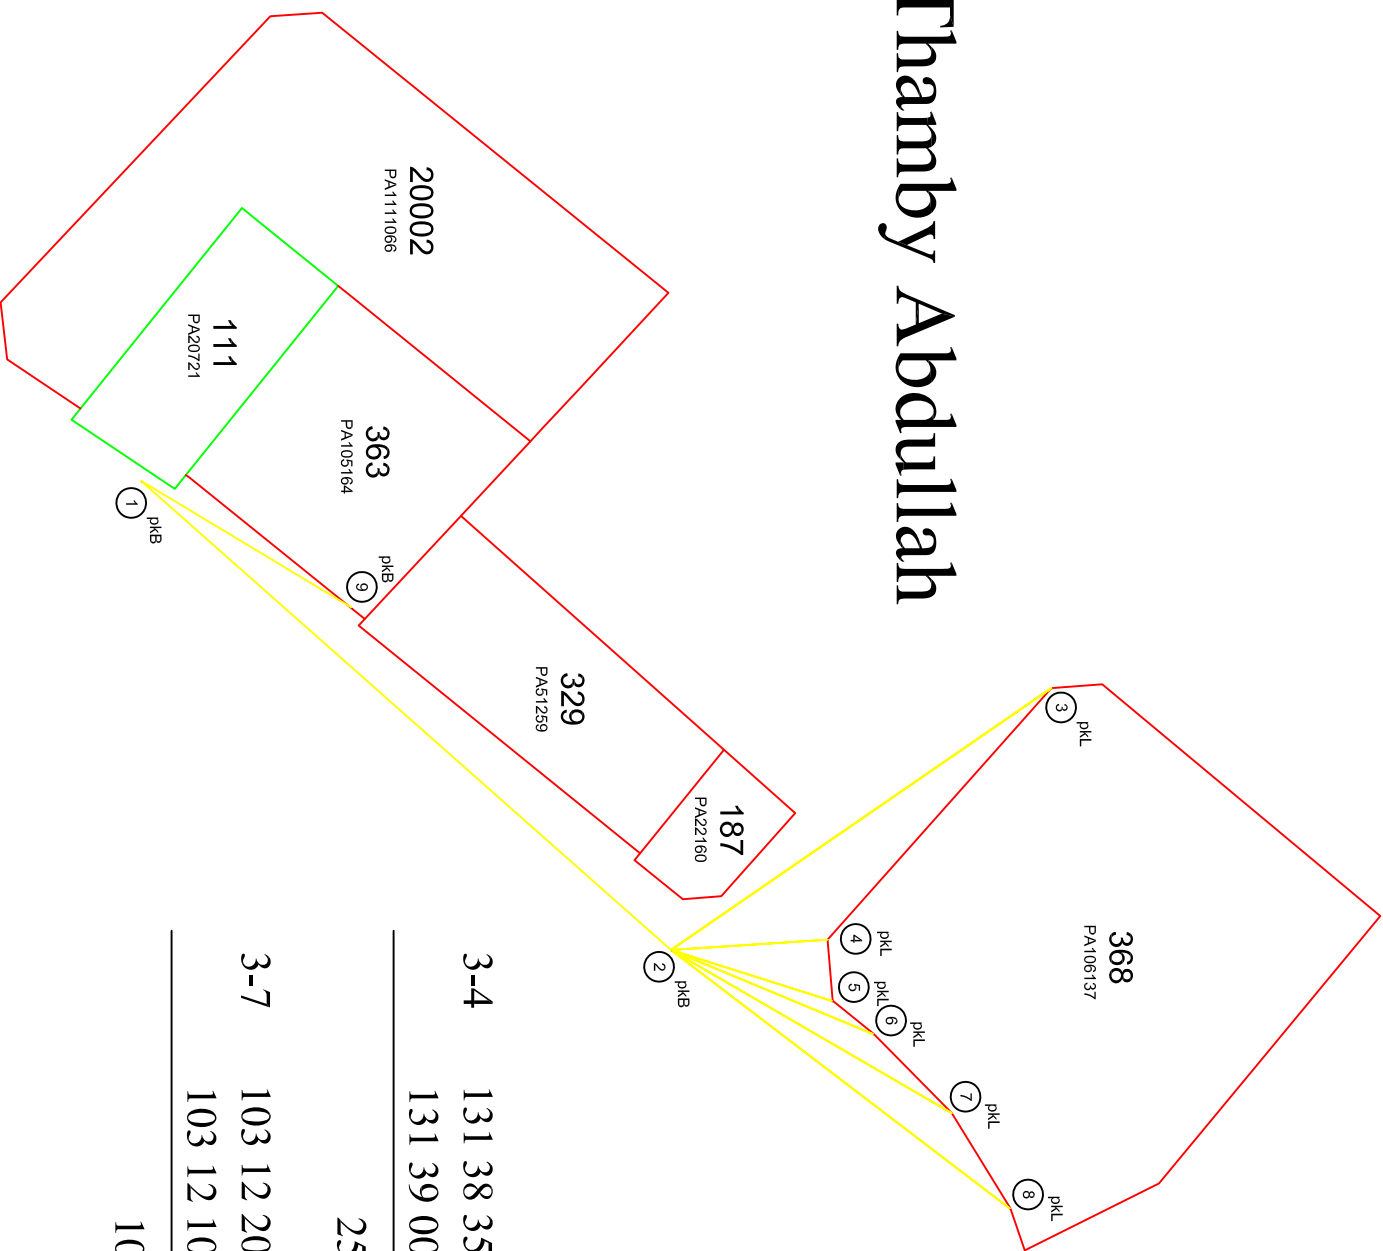

3-4	131	38	35	57.821(New)
	131	39	00	57.804(Po)
	25	0.017		
3-7	103	12	20	57.941(New)
	103	12	10	74.932(Po)
	10	0.009		

JZ 689 Thamy Abdullah

2.1085

1.8678

1.8715

2.0769

1.3597

1.3239

26.895

GPS / FZ

27.079

CP

26.9709

TBM F 4013

27.1921

TBM F 4019

27.2239

F1

BM W 0007

GPS Level: 26.961

BM Level: 26.892

0.069

FZ / GPS

GPS Level: 26.919

constant: 0.069

26.895

JE 689 Thamby Abdullah.

F2	2.1055		26.895	F2/GPS
	1.4678	1.8715	27.079	CP1
3	2.0769		26.4709	7BM R34013
2	1.357		27.192	7BM R 9014
		1.4749	27.029	F1

BM N0017

GPS level: 26.961

BM level: 26.892

0.069

F2/GPS.

GPS level: 26.919

constant: 0.069

26.895