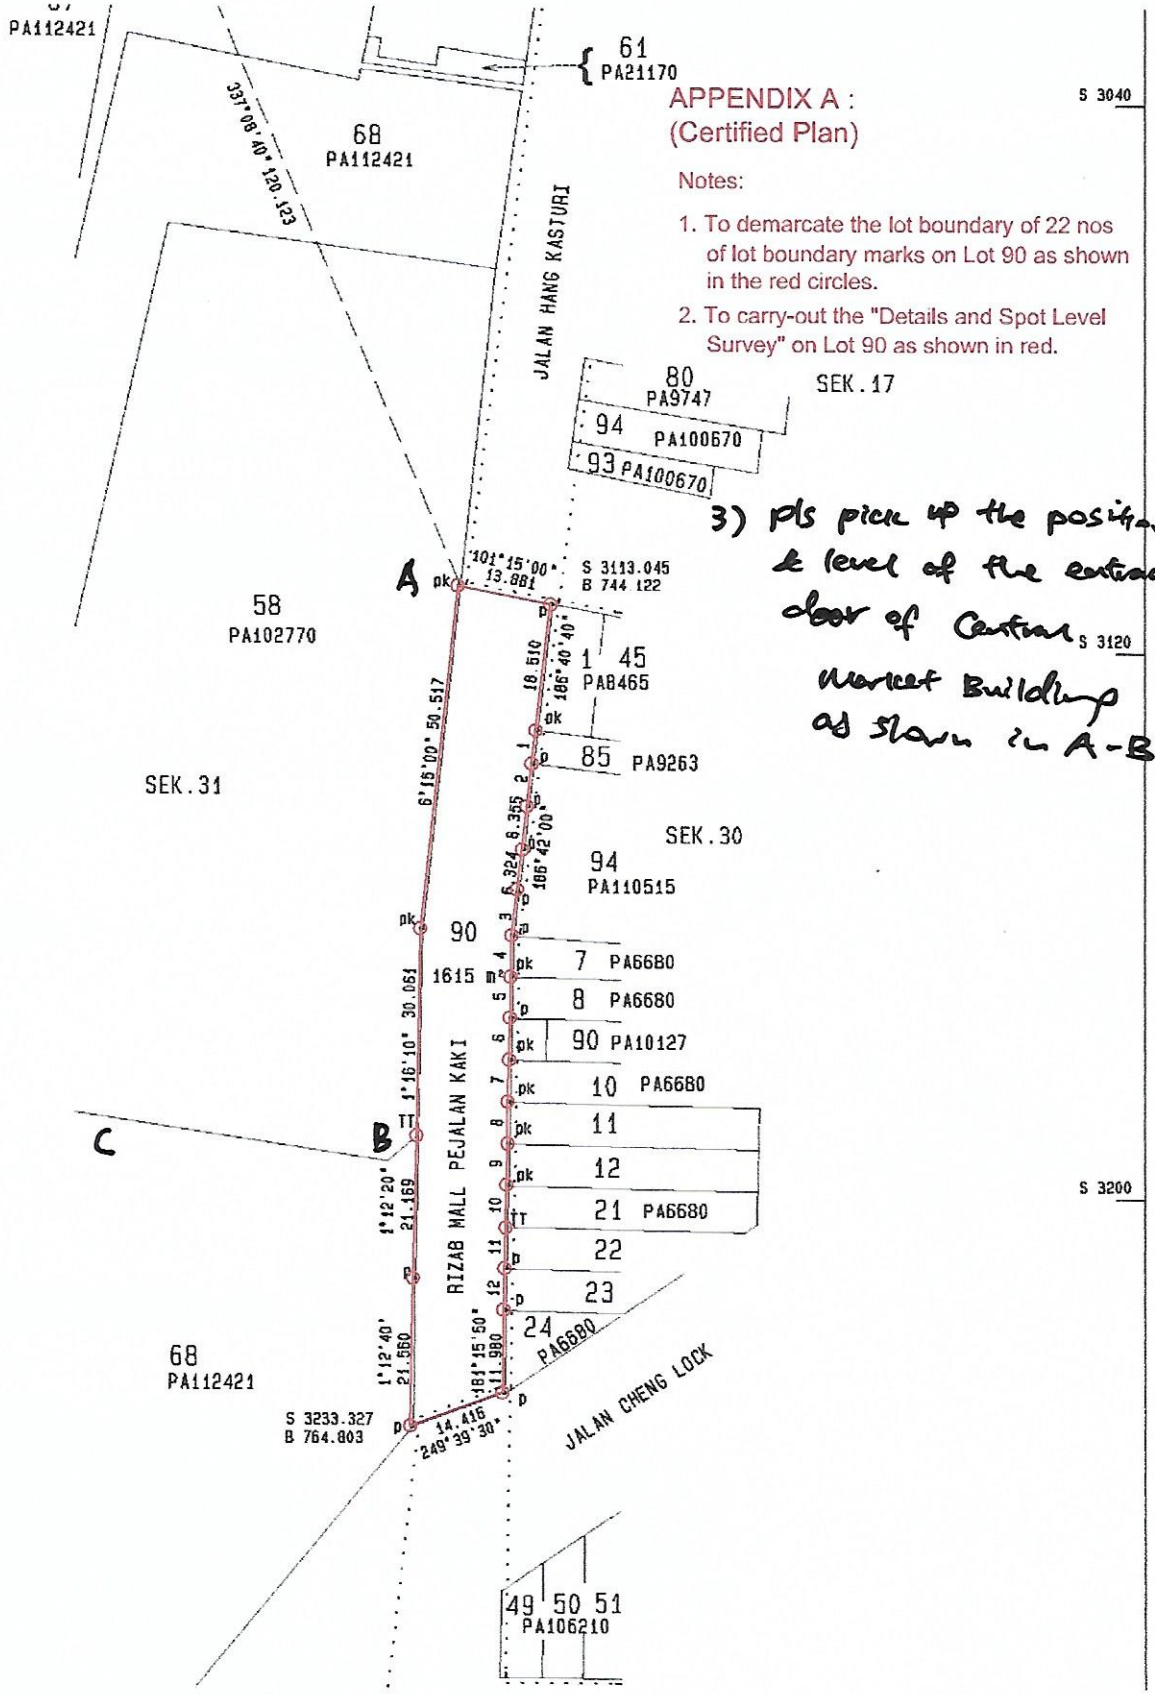

APPENDIX A :
(Certified Plan)
Notes:
1. To demarcate the lot boundary of 22 nos of lot boundary marks on Lot 90 as shown in the red circles.
2. To carry-out the "Details and Spot Level Survey" on Lot 90 as shown in red.
3) pls pick up the position, ground & level of the entrance door of Central Market Building as shown in A-B-C.
PA112421
61
PA21170
68
PA112421
337°08'40" 120.123
JALAN HANG KASTURI
80
PA9747
94
PA100670
93 PA100670
SEK.17
S 3040
A
pk
101°15'00"
13.881
S 3113.045
B 744 122
58
PA102770
1 45
PA8465
85 PA9263
SEK.31
SEK.30
94
PA110515
S 3120
6°15'00" 50.517
90
1615 m²
7 PA6680
8 PA6680
90 PA10127
10 PA6680
11
12
21 PA6680
22
23
24 PA6680
RIZAB MALL PEJALAN KAKI
B
C
1°16'10" 30.061
1°12'20" 21.169
1°12'40" 21.560
181°15'50" 11.980
14.416
249°39'30"
S 3233.327
B 764.803
68
PA112421
JALAN CHENG LOCK
49 50 51
PA106210
S 3200