

No. Fail


Rajah di muka

[illegible]

No. Fail

Rajah di muka

Stesen	BEARING / SUDUT			Dari Stn.	GARISAN		Ke Stn.	Sudut Pukak (±)	Jarak	Sudut	Jarak Antara Tupang	Jarak Mukamat
	Penyilang Kiri	Penyilang Kanan	Purata		Bearing Mukamat							
	Pkat BtB.											
2-50	309 2706	37.891	pk.B									
2-51	295 0258	9.653	pk.B									
2-52	290 3033	18.831	pk.B									
2-53	278 5122	36.920	pk.B									
2-54	278 3327	37.105	pk.B									
2-55	197 2659	32.809	BtB									
4-56	133 3037	35.329	BtB									
4-57	136 5303	36.051	pk.B									
4-58	158 1310	37.783	pk.B									
4-59	169 0709	37.862	pk.B									
4-60	163 3235	42.053	pk.B									
4-61	166 1132	29.596	pk.B									
4-62	147 0058	22.951	pk.B									
4-63	210 8326	11.829	pk.B									
4-64	210 1812	21.935	pk.B		7-79	331 1852	20.757	pk.B				
4-65	263 2396	28.747	pk.B		7-75	93 1811	15.728	pk.B				
4-66	282 0329	56.009	pk.B		7-76	95 2035	35.827	pk.B				
					7-77	197 1309	29.193	pk.B				
11-67	167 0032	11.303	pk.B									
11-68	187 0900	9.209	pk.B									
11-69	187 0959	10.359	pk.B									
9-70	130 5899	29.880	pk.B									
8-71	101 3301	25.915	pk.B									
8-72	212 1229	11.685	pk.B									
8-73	210 5190	26.309	pk.B									

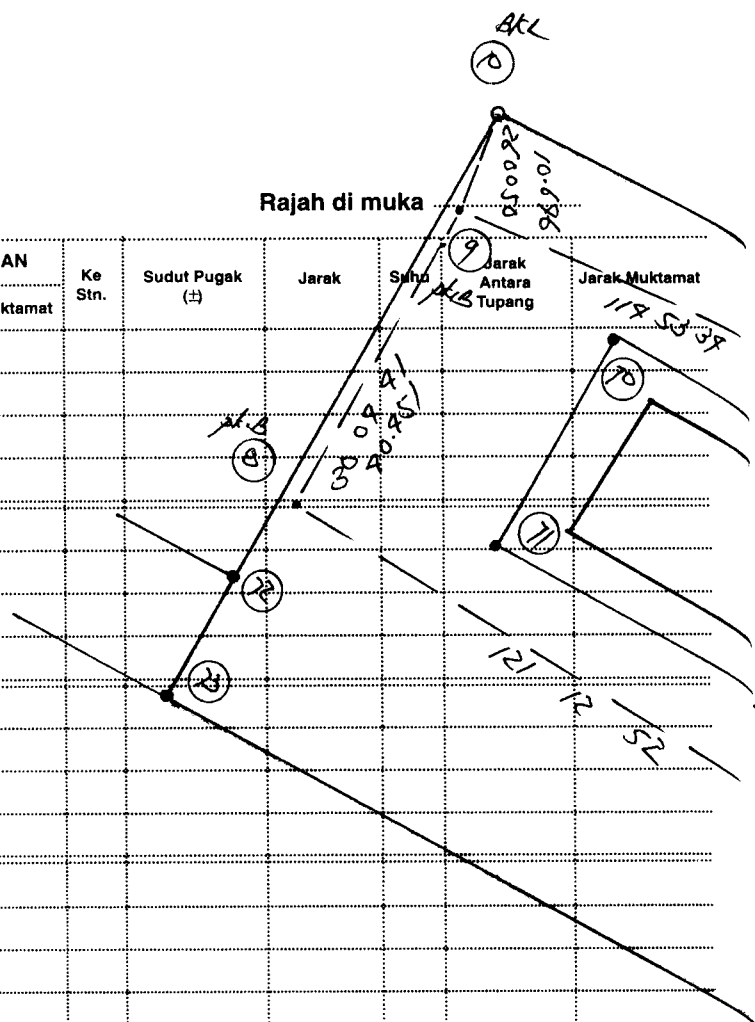


No. Fail

Rajah di muka

[illegible]

No. Fail

Stesen	BEARING / SUDUT			Dari Stn.	GARISAN		Ke Stn.	Sudut Pukak ($\pm$)	Jarak	Suhu	Jarak Antara Tupang	Jarak Mukamat
	Penyilang Kiri	Penyilang Kanan	Purata		Bearing Mukamat							
	<u>Observe Building.</u>											
9-80	100 55 57	1.918	RC									
9-81	111 21 96	5.716	RC									
9-82	91 29 39	8.888	RC									
11-83	309 35 09	79.722	RC									
11-89	282 25 12	32.669	CC									
9-85	263 13 15	28.903	CC									
9-86	197 19 19	78.923	RC									
2-86												
2-87	226 13 37	39.518	RC									
2-88	219 28 36	38.512	RC									
5-89	12 31 09	75.956	RC									
7-90	33 39 23	20.865	CC									
8-91	101 09 08	26.136	CC									

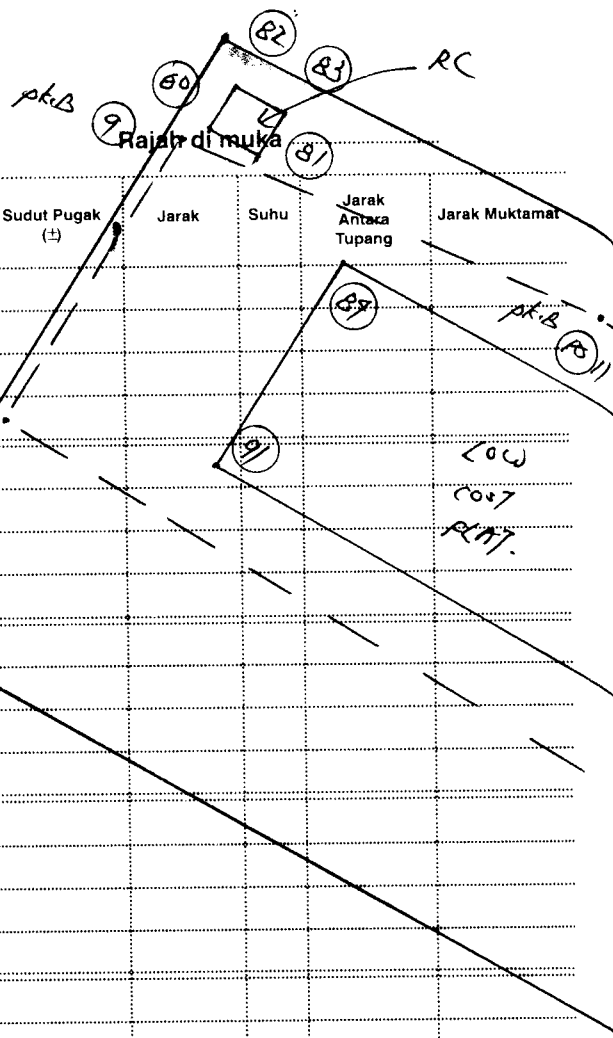

No. Fail

Rajah di muka

