

No. Fail JGC 918 Temple Park.

Rajah di muka

Stesen	BEARING / SUDUT		Dari Stn.	GARISAN Bearing Muklatam	Ke Stn.	Sudut Pugak (±)	Jarak	Suhu	Jarak Antara Tupang	Jarak Muklatam
	Penyilang Kiri	Penyilang Kanan								
	Datum Daripada	12/8558	2	12/8558	2	4	51.981			51.981
				Aj Ak. Dgn M4						
1	30/8558	12/8558	72808	2	72808	3	4	58.809		58.809
2										
3	72808	12/8558								
			PL							
1	Sports Di Atas	12/8327	2	12/8327	7	4	95.286			95.286
2										
7	12/8327	30/8327								
			pkB							
1	Sports Di Atas	975118	2	975118	5	4	92.916			92.916
2										
5	975118	27/5118								
			AL							
2	30/8327	12/8327	2511601	7	2511601	6	4	130.292		130.292
7										
6	2511601	711601								
			pkA							
7	711601	2511601	2229315	6	2229315	7	4	59.777		59.777
6										
7	2229315	929315								
			pkA							
6	929315	2229315	2211327	7	2211327	8	4	76.266		76.266
7										
8	2211327	911327								
			pkA							

Rajah di muka

[illegible]

No. Fail

Rajah di muka

No. Fail


Rajah di muka

Stesen	BEARING / SUDUT			Dari Stn.	GARISAN		Ke Stn.	Sudut Pukak (±)	Jarak	Suhu	Jarak Antara Tupang	Jarak Mukamat
	Penyilang Kiri	Penyilang Kanan	Purata		Bearing Mukamat							

DAERAH SOMBAK.
MUKIM RAWANG.
69C
TANDA SKALA.

Demarcation.

2-50 0 27 95 38.993 RB
2-51 77 50 15 70.529 RB

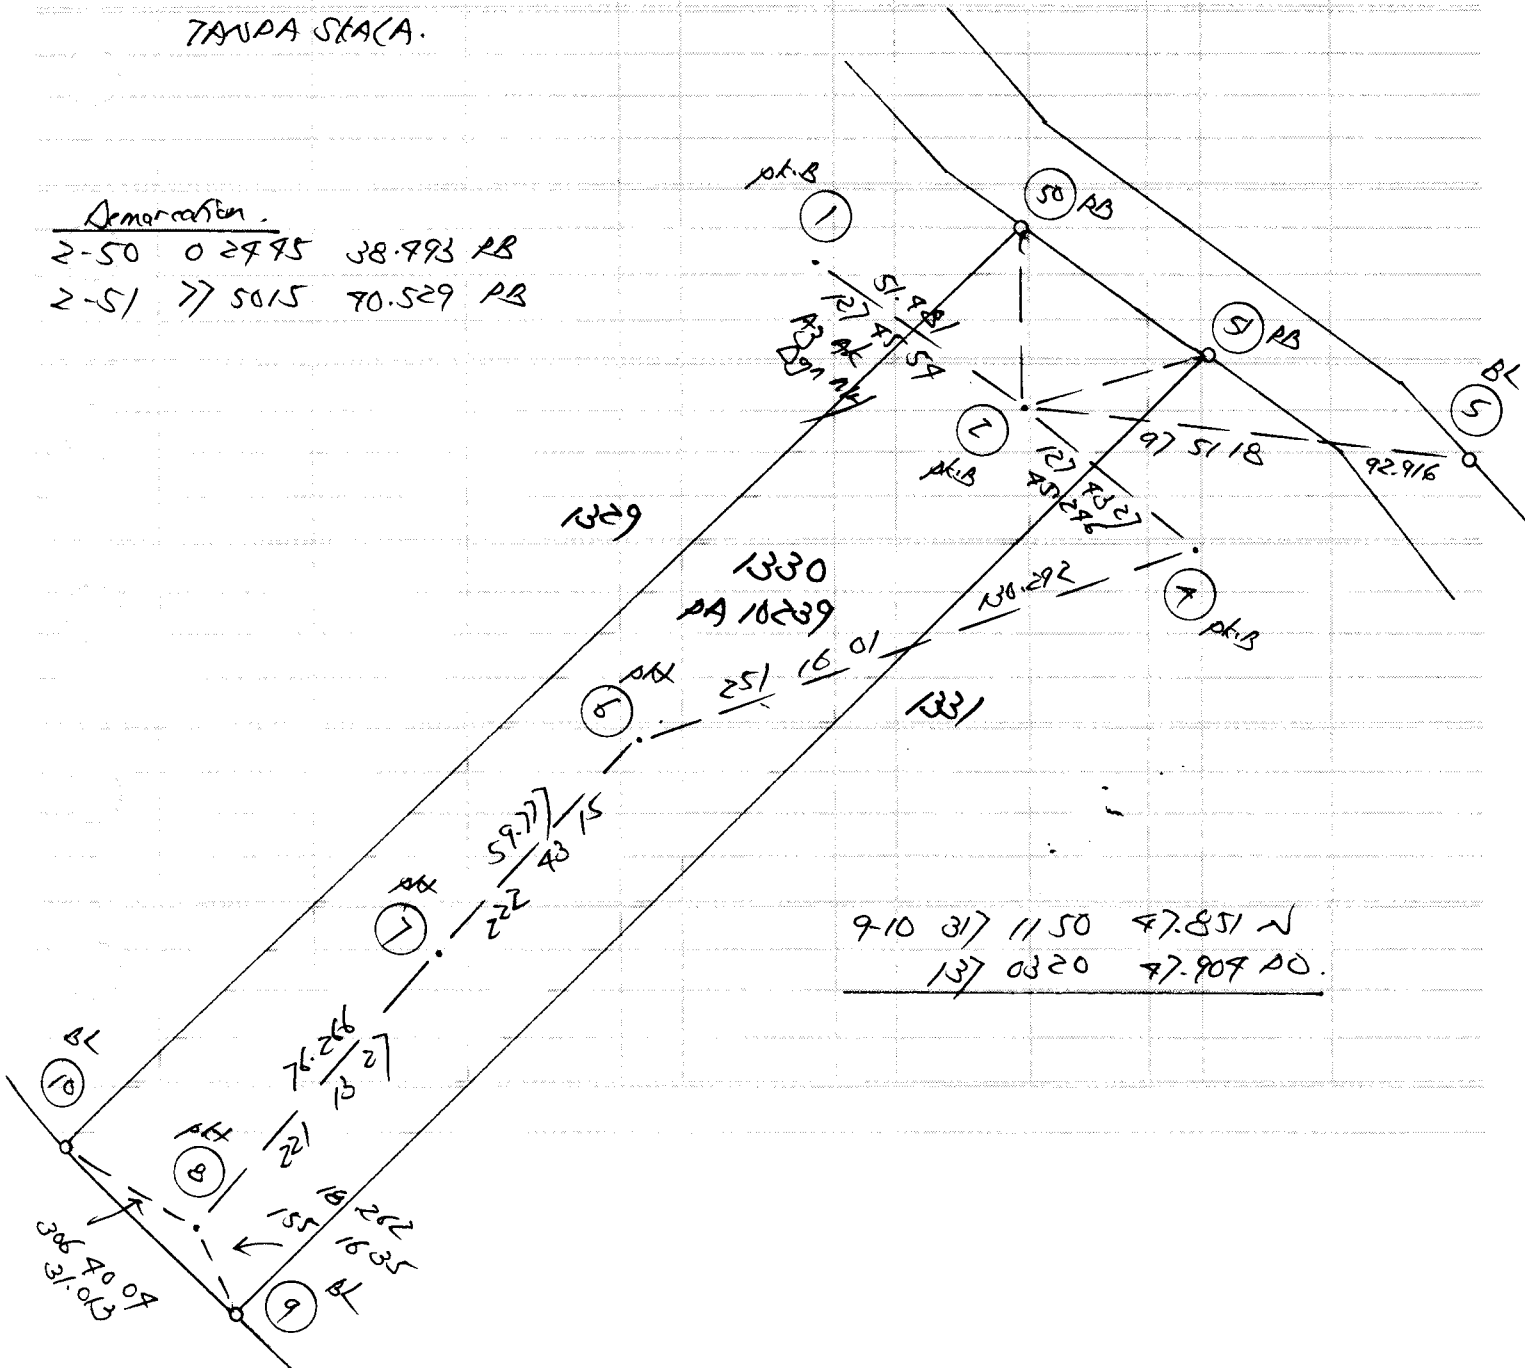

CERAPAN MATAHARI BAGI AZIMUT

Penilik _____ Hari _____ Tarikh _____ Bulan _____ Tahun _____
 Stesen _____ T.R. _____ B.K. _____ Ms. _____ Tiodolait (jenis) _____ I Bah. Aras Ufuk - a _____

Penilik: JGC414 Templer Tarikh: 07/07/2010
 Stn. 2 Koordinat: U11924 B6284 Selangor
 T.R. 1 B.K. Ms.
 Tiodolit Satu bah. aras ufuk:

Waktu	Sasaran	Ufuk	Gelembong	Puguk		
	T.R.	326 00 00				
10 20	M.H.	80 35 31	47 31 02	Waktu purata	10 20 30	
10 20	M.H.	79 50 30	47 25 52	Beza dari U.T. -	8 00 00	
10 21	M.H.	259 46 09	312 41 14	U.T.	2 20 30	
10 21	M.H.	260 26 54	312 46 41	Deklinasi	22 36 24	
	T.R.	146 00 00				
	T.R.	326 00 00				
10 22	M.H.	80 25 07	47 05 52	Waktu purata	10 22 30	
10 22	M.H.	79 40 10	47 01 50	Beza dari U.T. -	8 00 00	
10 23	M.H.	259 36 31	313 02 51	U.T.	2 22 30	
10 23	M.H.	260 17 40	313 08 34	Deklinasi	22 36 23	
	T.R.	146 00 00				

	Set 1	Set 2
Sudut pugak	42 37 45	43 00 56
Pembetulan	- 0 00 51	- 0 00 51
Altitud	42 36 54	43 00 05
Jarak kutub	67 23 36	67 23 37
Latitud	3 16 55	3 16 55
Azimut M.H. yang dikira	61 56 13	61 46 15
Purata ke M.H.	80 09 46	79 59 52
Selisih:	- 18 13 33	- 18 13 37
Purata ke T.R.	326 00 00	326 00 00
Azimuth T.R. sebenar	307 46 27	307 46 23
Pembetulan aras	+ 0 00 00	+ 0 00 00
Tirusan	- 0 00 29	- 0 00 29
Bering grid T.R.	307 45 58	307 45 54
Purata bering grid T.R.	307 45 56	

