

No. 100

Rajah di muka

15	2923519	623519	3363299	16	3363299	17	4	69.772	69.772
16									
17	3363299	1563299							
	pkf								
16	1563299	3363299	330539	17	330539	18	4	73.078	73.078
17									
18	330539	1330539							
	pkf.								
17	1330539	330539	3503091	18	3503091	19	4	79.363	79.363
18									
19	3503091	1703091							
	PL								
17	Seperti Di Atas	3195729	18	3195729	20	4	65.117	65.117	
18									
20	3195729	1395729							
	pkf.								
18	1395729	3195729	2870298	20	2870298	21	4	12.719	12.719
20									
21	2870298	1070298							
	pkf.								
20	1070298	2870298	2390953	21	2390953	22	4	132.881	132.881
21									
22	2390953	590953							
	pkf.								
21	590953	2390953	799807	22	799807	23	4	73.610	73.610
22									
23	799807	2599807							
	PL								

No. Lari


21	59 09 53	279 09 53	258 2138	22	258 2138	27	4	21.918	21.918
22	27	258 2138	78 2138						
		pk							
22	78 2138	258 2138	255 2310	27	255 2310	25	4	32.626	32.626
27	25	255 2310	75 2310						
		pk.							
27	75 2310	255 2310	225 5508	25	225 5508	28	4	99.701	99.701
25	26	225 5508	75 5508						
		pk.							
25	75 5508	225 5508	200 2938	26	200 2938	27	4	6.970	6.970
26	27	200 2938	20 2938						
		BL							
25	Sept. Di Atas	69 1657	26	69 1657	28	4	23.979	23.979	
26	28	69 1657	299 1657						
		pk							
26	299 1657	69 1657	186 2217	28	186 2217	1	4	167.720	167.720
28	1	186 2217	6 2217						
28	6 2217	186 2217	100 0507	1	100 0507	12	Srla	Lihat mps 6 R 3	
1	12	100 0507	280 0507						

Bring 1-12 Dibaca 100 05 07
 Sepatutnya Dibaca 100 05 07

 Titik-titik Ni/
 Pembetulan Ni/


BEASING & DUM			DAS		GARISAN		Ke		Suhu Angk		Parak		Suhu		Jarak Antara		Jarak Muktam	
Beasung Muktam			94		Beasung Muktam		Se		9		Parak		Suhu		Jarak Antara		Jarak Muktam	


16-50 314 0129 17.339 RB

10-19 73 1951 369.106 ✓
73 1578 369.052 PO
-57 70.079

10-27 359 0231 153.378 ✓
359 0100 153.377 PO
4/31⁴ 10.001

19-27 657016 280.350 N
657158 280.707 PO
-142' -0.057

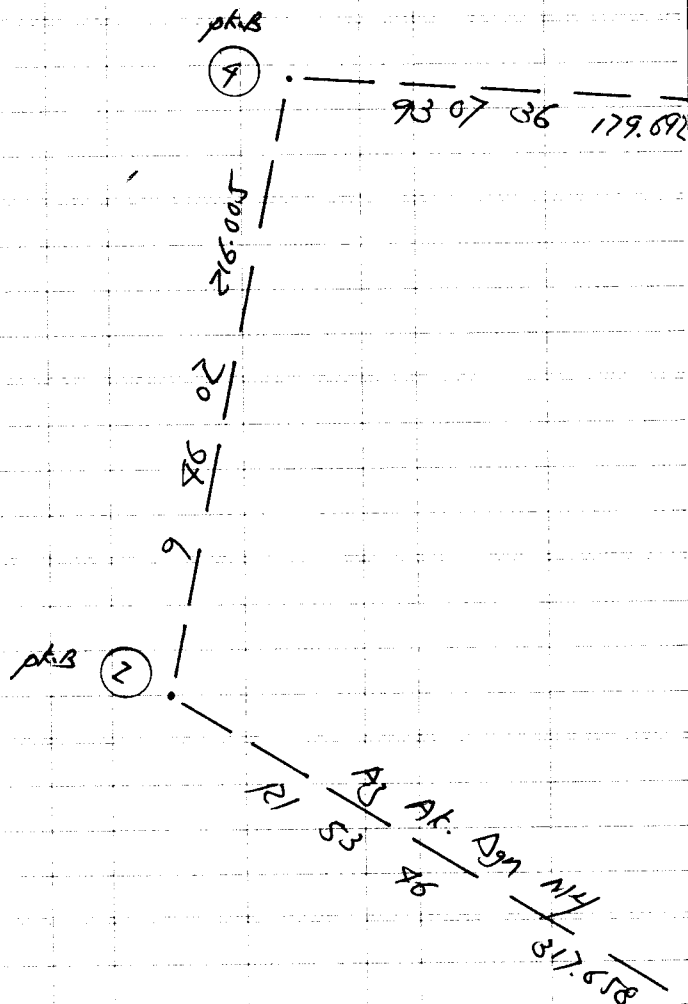

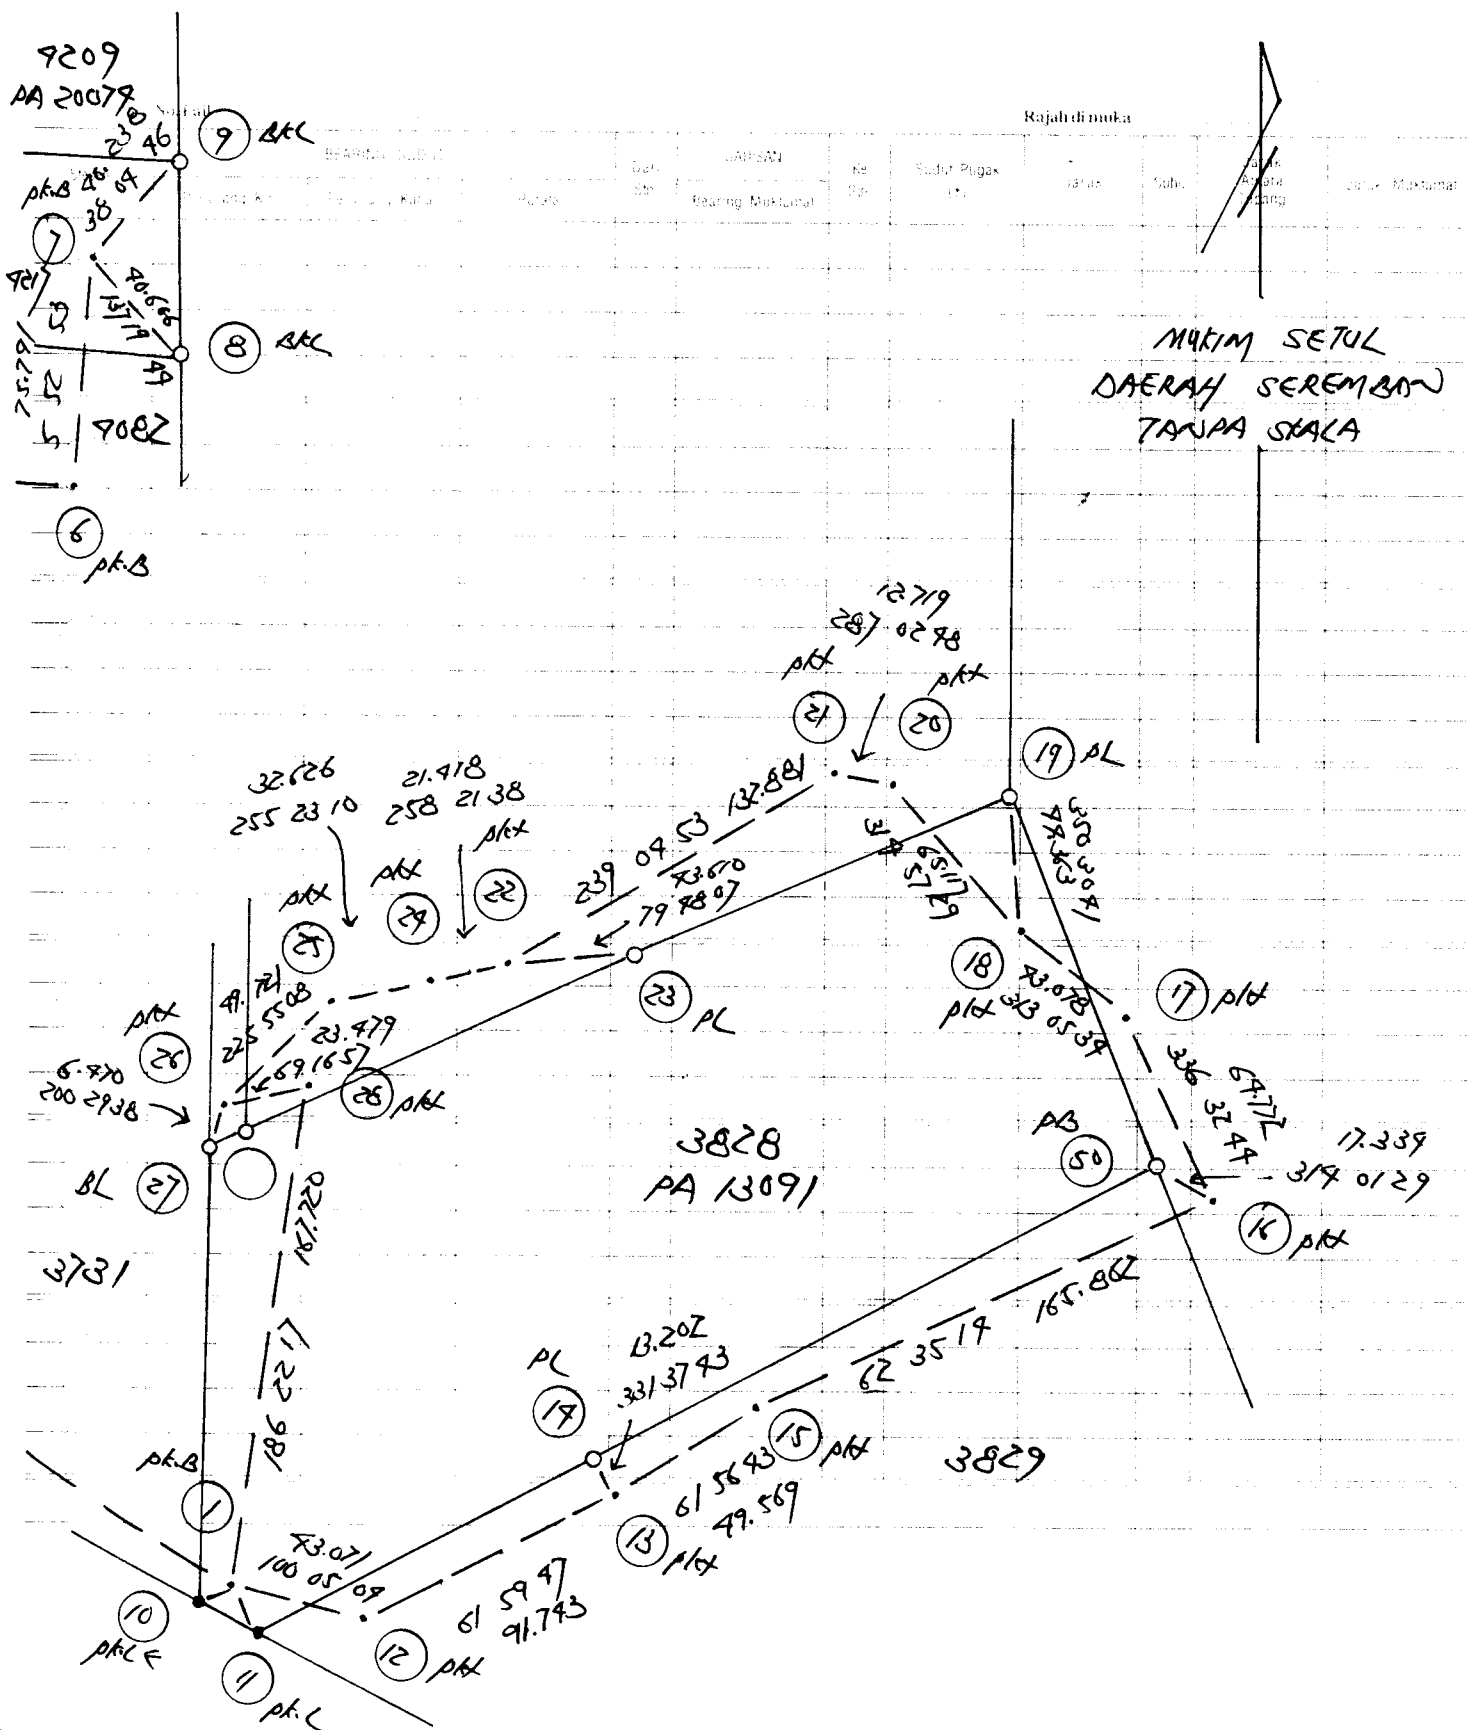

CERAPAN MATAHARI BAGI AZIMUT

No. 1

Hari

Tarikh: ... Bulan: ...

Tahun

Penilik: JITU001 NILAI Tarikh: 18/08/2011

Stn. 2 Koordinat: U12600 B12654 Negeri Sembilan

T.R. 1 B.K. Ms.

Tiodolit Satu bah. aras ufuk:

Waktu	Sasaran	Ufuk	Gelembong	Puguk
-------	---------	------	-----------	-------

	T.R.	134 00 00				
8 22	M.H.	89 21 45	73 02 27	Waktu purata	8 22 30	
8 22	M.H.	88 48 29	72 57 43	Beza dari U.T. -	8 00 00	
8 23	M.H.	268 48 40	287 07 20	U.T.	0 22 30	
8 23	M.H.	269 21 45	287 13 49	Deklinasi	13 16 18	
	T.R.	314 00 00				

	T.R.	134 00 00				
8 24	M.H.	89 21 17	72 39 28	Waktu purata	8 24 30	
8 24	M.H.	88 48 00	72 35 16	Beza dari U.T. -	8 00 00	
8 25	M.H.	268 48 12	287 30 59	U.T.	0 24 30	
8 25	M.H.	269 21 20	287 36 55	Deklinasi	13 16 17	
	T.R.	314 00 00				

	Set 1	Set 2
Sudut pugak	17 05 15	17 28 18
Pembetulan	- 0 02 43	- 0 02 39
Altitud	17 02 32	17 25 39
Jarak kutub	76 43 42	76 43 43
Latitud	2 50 05	2 50 05
Azimut M.H. yang dikira	76 59 01	76 58 33
Purata ke M.H.	89 05 10	89 04 42
Selisih:	- 12 06 09	- 12 06 09
Purata ke T.R.	134 00 00	134 00 00
Azimuth T.R. sebenar	121 53 51	121 53 51
Pembetulan aras	+ 0 00 00	+ 0 00 00
Tirusan	+ 0 00 20	+ 0 00 20
Bering grid T.R.	121 54 11	121 54 11

Purata bering grid T.R.	121 54 11
-------------------------	-----------

No. 1

Koordinat: U12600 B12654

Hari

Tarikh:

Bulan:

Tahun

Dibuat untuk

7th Kunding

.....**Ke**

Pandangan Belakang	Pandangan Antara	Pandangan Hadapan	Naik	Turun	Aras Yang Dilaras	Jarak	Catitan
1.577 (1898)						78M F 1934	
1.489 (1889)	1.609	(1528)				14056	
1.483	(1883)					78M F 1935	
1.483 (1883)	1.395	(1881)				F10 57M F1	
0.998 (1192)						57M 975	
	3.37	(1106)				57M 975	
0.210 (1069)							
0.188 (1062)	3.355	(1100)					
0.996 (1327)	2.895	(1950)					
1.339 (1838)	1.953	(1977)					
	1.630	(1535)					
1.509 (1895)	1.387	(1815)					
	0.875	(1287)					