


51.970

Don't

18.559


9/823

STB

12.980

PL

79.523

pt.B

17.132

skL

23-772

WLB

7 337 2823 159 2823 117 1137 8 117 1137 9 4 1.755 1.755

8
9 117 1137 237 1137

7 337 2823 159 2823 117 1137 8 117 1137 9 4 1.755 1.755

8
6 2823 199 823 199

8 823 199 2823 149 392 5219 6 392 5219 2 Sika Likat m/s 5 RS

6
2 392 5219 182 5219 Bring
Tutuhup.

Bring 6-2 Dikara 392 5219

Spit-tape Dikara 392 5219

Tikaian (u)

Ambetulan (u)

2 259 9705 79 9705 178 9298 1 178 9298 10 4 7.968 7.968

10 178 9298 358 9298

Sp-L


pt. B

④ 209

3-10	7253 00	37.193 ✓
	7259 27	37.139 00
	- 1 27"	+ 0.009

3-9	118 2921	58.685 ✓
	118 2225	58.653 00
	- 1 56"	+ 0.032

WILAYAH KERSEKUTUAN
 MUKIM KAYAK CUMPAK
 0356
 TANPA SKALA

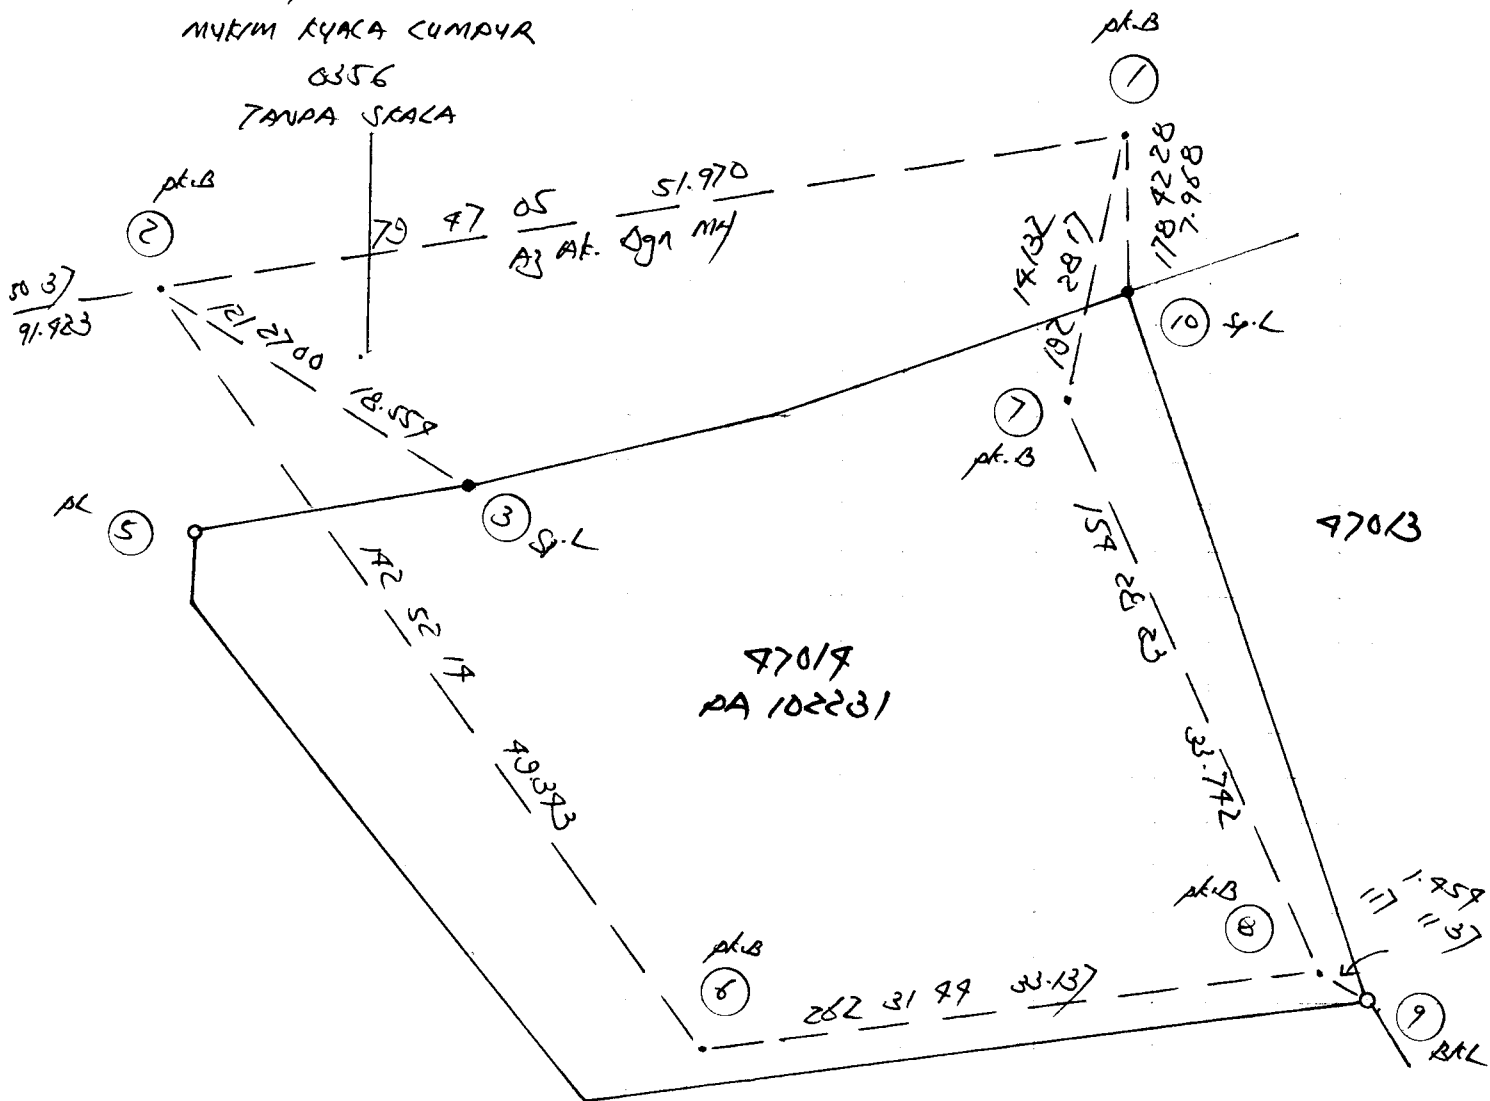

DAFTAR HASILAN KAMU AZIMUT


Stn. 2 Koordinat: S3510 B4918 W.P. Kuala Lumpur

T.R. 1 B.K. Ms.

Tiodolit Satu bah. aras ufuk:

Waktu	Sasaran	Ufuk	Gelembong	Puguk		
	T.R.	259 48 06				
9 24	M.H.	69 12 36		60 26 47	Waktu purata	9 24 30
9 24	M.H.	68 35 42		60 23 00	Beza dari U.T. -	8 00 00
9 25	M.H.	248 33 31		299 48 06	U.T.	1 24 30
9 25	M.H.	249 08 58		299 52 59	Deklinasi	19 52 07
	T.R.	79 48 26				

	T.R.	259 48 06				
9 26	M.H.	69 08 15		59 58 17	Waktu purata	9 26 30
9 26	M.H.	68 31 16		59 55 14	Beza dari U.T. -	8 00 00
9 27	M.H.	248 29 53		300 10 56	U.T.	1 26 30
9 27	M.H.	249 05 19		300 16 28	Deklinasi	19 52 06
	T.R.	79 48 26				

	Set 1	Set 2
Sudut pugak	29 42 49	30 08 28
Pembetulan	- 0 01 24	- 0 01 22
Altitud	29 41 25	30 07 06
Jarak kutub	70 07 53	70 07 54
Latitud	3 08 33	3 08 33
Azimut M.H. yang dikira	68 52 06	68 47 55
Purata ke M.H.	68 52 42	68 48 41
Selisih:	- 0 00 36	- 0 00 46
Purata ke T.R.	259 48 16	259 48 16
Azimuth T.R. sebenar	259 47 40	259 47 30
Pembetulan aras	+ 0 00 00	+ 0 00 00
Tirusan	- 0 00 30	- 0 00 30
Bering grid T.R.	259 47 10	259 47 00

Purata bering grid T.R. 259 47 05

19

.....Ke

.....Ke

Pandangan Belakang	Pandangan Antara	Pandangan Hadapan	Naik	Turun	Aras Yang Dilaras	Jarak	Catitan
0.781	(256)				113.179	1100 / 152	
	2553	(838)			111.807	78m 11809 / 152	1806 m/s 15 AC: 111.807
		3812	(1250)		110.188	1101 / 151	BM 110071