

No. Fail

JAS 81297


H/COA Sec 28

Rajah di muka

[illegible]

No. Fail

Rajah di muka

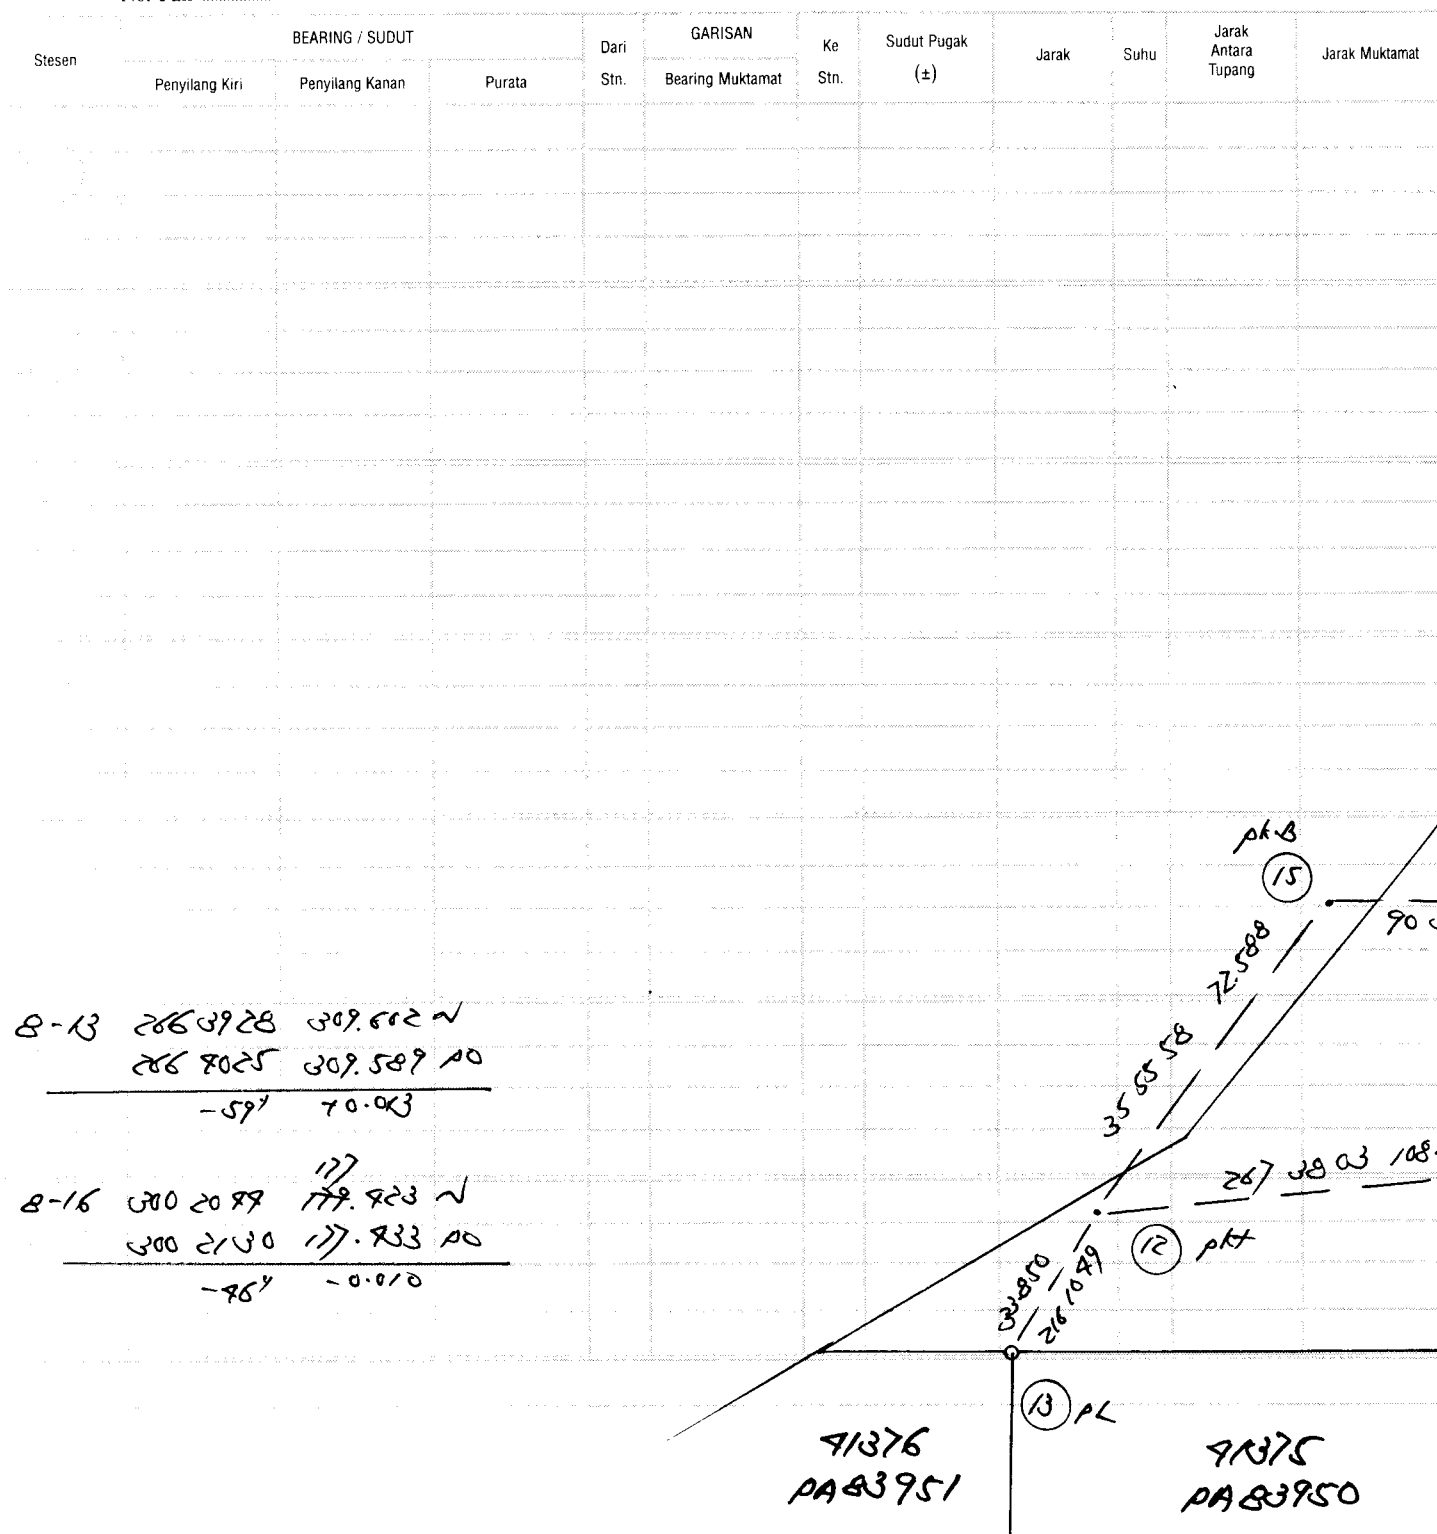


No. Fail

Rajah di muka

Stesen	BEARING / SUDUT			Dari Stn.	GARISAN		Ke Stn.	Sudut Pukak ($\pm$)	Jarak	Suhu	Jarak Antara Tupang	Jarak Mukamat
	Penyilang Kiri	Penyilang Kanan	Purata		Bearing Mukamat							

DARAH DETALING.
 PERAN HICOM
 100B
 TANPA SKALA

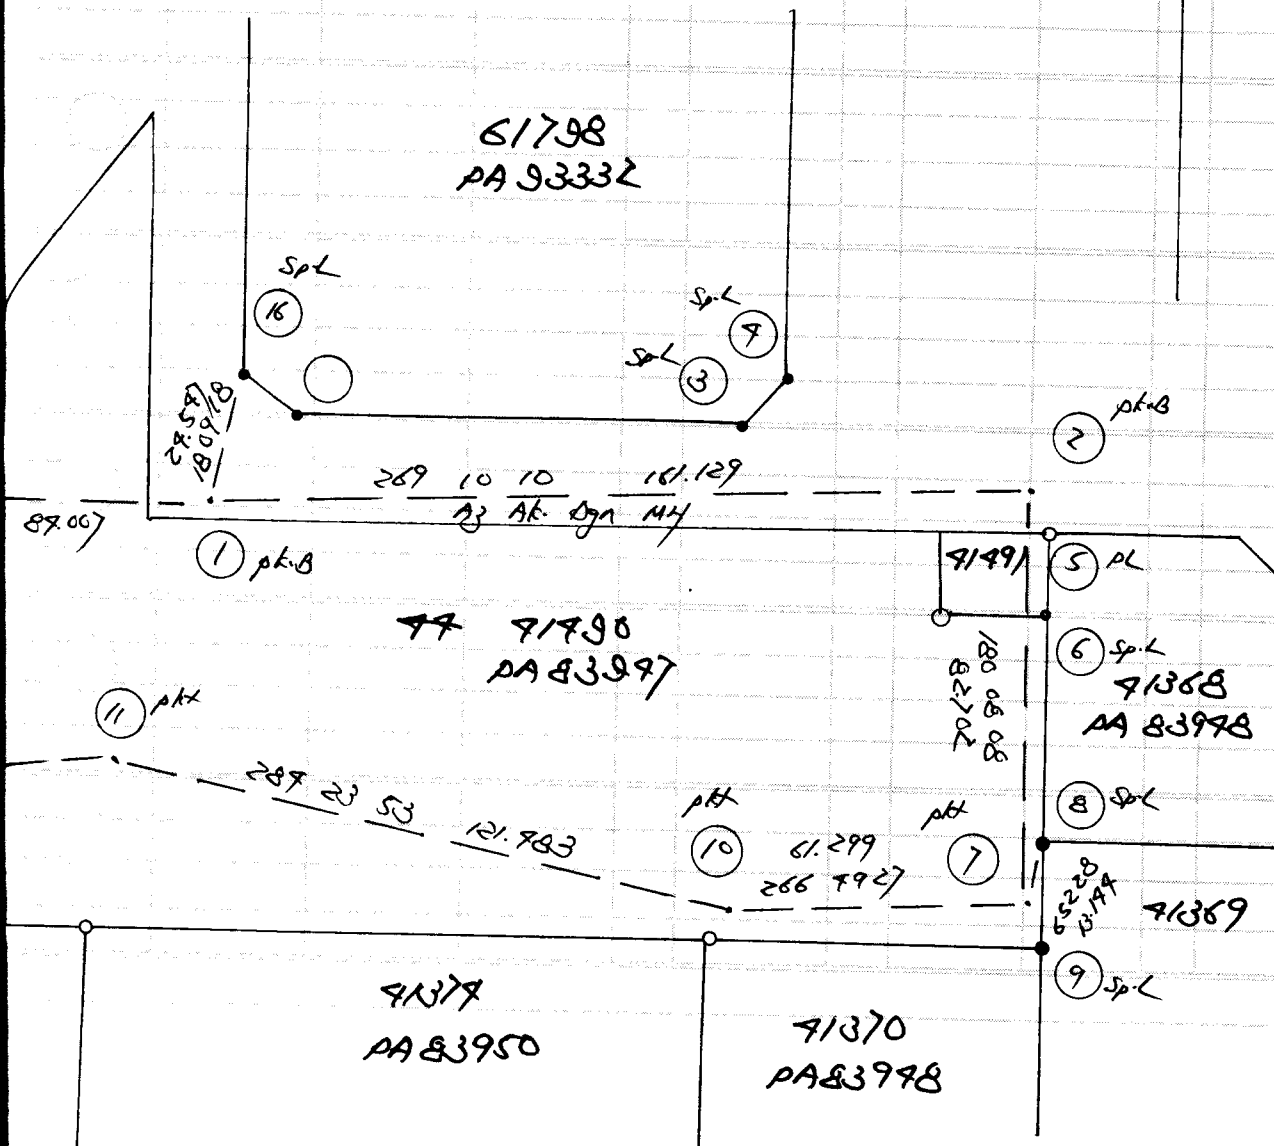

Penilik: JRS81297 Hicom Sec 28 Tarikh: 07/09/2010

Stn. 2 Koordinat: S17641 B15890 Selangor

T.R. 1 B.K. Ms.

Tiodolit Satu bah. aras ufuk:

Waktu	Sasaran	Ufuk	Gelembong	Puguk		
	T.R.	265 00 00				
10 28	M.H.	80 20 52		41 07 20	Waktu purata	10 28 30
10 28	M.H.	79 32 07		41 02 05	Beza dari U.T. -	8 00 00
10 29	M.H.	259 29 42		319 07 00	U.T.	2 28 30
10 29	M.H.	260 18 08		319 14 13	Deklinasi	6 08 51
	T.R.	85 00 00				

	T.R.	265 00 00				
10 30	M.H.	80 19 07		40 35 25	Waktu purata	10 30 30
10 30	M.H.	79 29 50		40 31 19	Beza dari U.T. -	8 00 00
10 31	M.H.	259 27 48		319 34 56	U.T.	2 30 30
10 31	M.H.	260 16 31		319 43 02	Deklinasi	6 08 49
	T.R.	85 00 00				

	Set 1	Set 2
Sudut pugak	49 02 57	49 32 49
Pembetulan	- 0 00 41	- 0 00 40
Altitud	49 02 16	49 32 09
Jarak kutub	83 51 09	83 51 11
Latitud	3 00 53	3 00 53
Azimut M.H. yang dikira	84 05 35	84 03 36
Purata ke M.H.	79 55 12	79 53 19
Selisih:	4 10 23	4 10 17
Purata ke T.R.	265 00 00	265 00 00
Azimuth T.R. sebenar	269 10 23	269 10 17
Pembetulan aras	+ 0 00 00	+ 0 00 00
Tirusan	- 0 00 10	- 0 00 10
Bering grid T.R.	269 10 13	269 10 07

Purata bering grid T.R.

269 10 10

Daripada

TR5 91297

Pandangan Belakang	Pandangan Antara	Pandangan Hadapan	Naik	Turun	Aras Yang Dilaras	Jarak	Catitan
1.505	(12.83)				7.382	78M N/768	Atu spike.
	1.477	(12.85)			7.910	P/1	
1.625	(533)	1.960	(12.79)		7.427		
	1.193	(12.91)			7.859	78M N/76	
		1.536	(502)		7.516	P2	
3.130		2.996					
1.657	(598)				7.516	P2	
1.695	(539)	0.947	(13.11)				
1.607	(5.2)	1.389	(12.56)				
1.656	(5.83)	1.317	(12.32)				
1.457	(12.78)	1.663	(15.46)				
1.473	(12.83)	1.870	(16.12)				
2.055	(16.12)	1.623	(15.32)				
		2.089	(16.45)		8.168	H5	(AC: 8.168m) P47/8/886/02.
							P47/8/782/02.
11.550		10.898					BM 8/030