

JRS 81380 Bkt Sordang 2.

No. Tail

Baphenimaks

CLEARING CODE		A/S/N		B/S/N		C/S/N		IJ/S/N		IK/S/N		IL/S/N		LM/S/N		LN/S/N		LO/S/N		

Kajalib marku

2	239 53 83	53 53 83	339 1129	9	339 1129	12	4	117.352		117.352
9										
12	339 1129	159 1129								
	pk.									
9	159 1129	339 1129	107 1839	12	107 1839	13	4	137.117		137.117
12										
13	107 1839	287 1839								
	pk.									
9	Sprts 01 Atas	326 3519	12	326 3519	19	4		12.025		12.025
12										
19	326 3519	196 3519								
	BL									
12	287 1839	107 1839	69 2327	13	69 2327	15	4	63.136		63.136
13										
15	69 2327	279 2327								
	pk.									
15-17	25 0637		15	25 0637	17	4		20.582	BL	20.582
15-18	38 5812		15	38 5812	18	4		23.813	PL	23.813
13	279 2327	69 2327	180 2120	15	180 2120	11	4	83.927		83.927
15										
11	180 2120	0 2120								
15	0 2120	180 2120	286 7819	11	286 7819	9		Sik Likat m/s 31 R7		
11										
9	286 7819	86 7819								

Bring 11-9	Dibaca	286 7819
Sepuluhnya	Dibaca	286 7819
Tikoran		Ni/
Pembetulan		Ni/

S. 1. 1. 1.

S. 1. 1. 1.

DAERAH DETALING.
MUKIM DETALING.
TANPA SKAKA
930

MUKAYAH PERSEKUT BL
MUKIM DETALING. 19
35/29
DA 105927

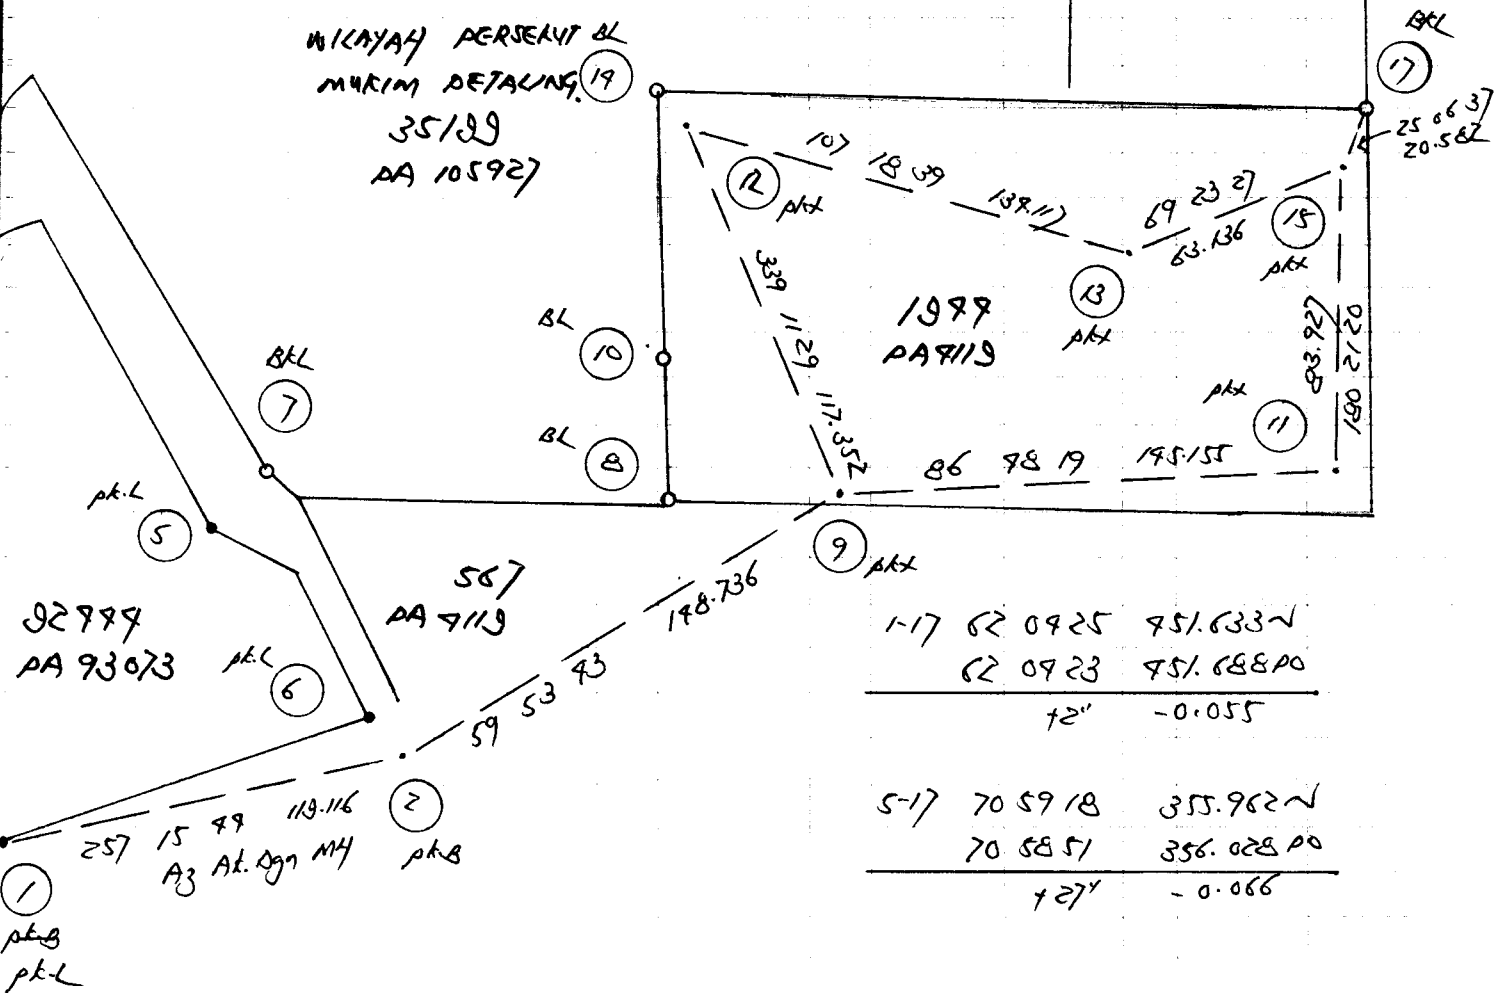

SERAPAN MATAHARI BAGI AZIMUT

Tempat: _____ Hari: _____ Indeks: _____ Bahan: _____ Tahun: _____

Stasiun: _____ B.K. _____ Ms. _____ Tiodolit (jenis): _____ I. Bah. (jenis): _____

Penilik: JRS81380 Bkt Serdang 2 Tarikh: 13/11/2010

Stn. 2 Koordinat: S14535.621 B1368.183 Selangor

T.R. 1 B.K. Ms.

Tiodolit Satu bah. aras ufuk:

Waktu	Sasaran	Ufuk	Gelembong	Puguk
	T.R.	257 13 25		
8 05	M.H.	109 38 03	75 04 47	Waktu purata 8 05 30
8 05	M.H.	109 05 17	75 00 25	Beza dari U.T. - 8 00 00
8 06	M.H.	289 05 48	285 06 50	U.T. 0 05 30
8 06	M.H.	289 40 15	285 13 25	Deklinasi - 17 52 27
	T.R.	77 13 35		
	T.R.	257 13 25		
8 07	M.H.	109 41 54	74 39 08	Waktu purata 8 07 30
8 07	M.H.	109 08 57	74 36 09	Beza dari U.T. - 8 00 00
8 08	M.H.	289 09 20	285 29 46	U.T. 0 07 30
8 08	M.H.	289 43 50	285 36 47	Deklinasi - 17 52 28
	T.R.	77 13 35		

	Set 1	Set 2
Sudut pugak	15 03 46	15 27 49
Pembetulan	- 0 03 06	- 0 03 01
Altitud	15 00 40	15 24 48
Jarak kutub	107 52 27	107 52 28
Latitud	3 02 34	3 02 34
Azimut M.H. yang dikira	109 25 08	109 28 50
Purata ke M.H.	109 22 21	109 26 00
Selisih:	0 02 47	0 02 50
Purata ke T.R.	257 13 30	257 13 30
Azimuth T.R. sebenar	257 16 17	257 16 20
Pembetulan aras	+ 0 00 00	+ 0 00 00
Tirusan	- 0 00 35	- 0 00 35
Bering grid T.R.	257 15 42	257 15 45

Purata bering grid T.R. 257 15 44

Tarikh 8th Sunday 2. Aras

Dibuat untuk 68

Daripada 78581380

Ke

Pandangan Belakang	Pandangan Antara	Pandangan Hadapan	Naik	Turun	Aras Yang Dilas	Jarak	Catitan
7.083	(7.57)				78.983		
	1.131	(3.71)			78.275 78.983	784 51021	(AC 48.983m)
3.194	(10.86)	1.529	(5.24)				
3.925	(12.86)	0.359	(1.18)				
3.330	(10.92)	0.079	(0.16)				
3.137	(10.29)	0.111	(0.35)				
3.998	(12.95)	0.095	(0.31)				
3.031	(7.98)	0.108	(0.38)				
0.896	(2.78)	1.329	(8.36)				
0.077	(0.25)	3.960	(12.99)				
0.233	(0.76)	3.873	(12.1)				
2.365	(7.76)	1.982	(9.75)				
3.216	(10.55)	1.078	(3.58)				
3.398	(11.45)	0.357	(1.17)				
3.161	(10.3)	0.385	(1.25)				
3.916	(12.85)	0.137	(0.45)		67.39/ 67.655		
3.910		1.686	(5.53)			40 x (513)	
		16.500					

Tarikh Aras

Dibuat untuk

Daripada

Ke

Pandangan Belakang	Pandangan Antara	Pandangan Hadapan	Naik	Turun	Aras Yang Dilaras	Jarak	Catitan
1.686 0.859	(2.78)	2.009 3.802	(6.59)	(13.306)	67.653	90x (R13)	RL: 67.391m
0.151	(10.50)	3.563	(11.99)	68.67	60.223	90x	RL: 67.068m
0.531	(1.78)	3.818	(12.53)	61.010	57.997	78m R1792	RL: 68.915m
0.086	(10.15)	1.318	(9.32)	60.223	57.997	R2	RL: 68.798m
		2.772	(9.10)	57.997	57.997	R2	RL: 59.961m
3.283		13.919				R3	RL: 57.235m -