

No. Fail

Rajah di muka

Stesen	BEARING / SUDUT			Dari Stn.	GARISAN		Ke Stn.	Sudut Pukak (±)	Jarak	Suhu	Jarak Antara Tupang	Jarak Muktamat
	Penyilang Kiri	Penyilang Kanan	Purata		Bearing	Muktamat						
15	17 289 59 19	107 59 19	130 00 10	15	130 00 10	4-8	4	78.530				78.530
	16	130 00 10	310 00 10									

8 16	15	310 00 10	130 00 10	130 29 23	16	130 29 23	8	8	Stla Likat m/s 33 R7.			
	7 8	130 29 23	310 29 23				7					

Bering
Tertutup.

Bering 8-7
 Sepatutnya Di baca 130 29 23
 Tikaian Ni/
 Ambetulan Ni)

No. Fail


Rajah di muka

Rajah di muka

[illegible]

Rajah di muka

~~Suho~~

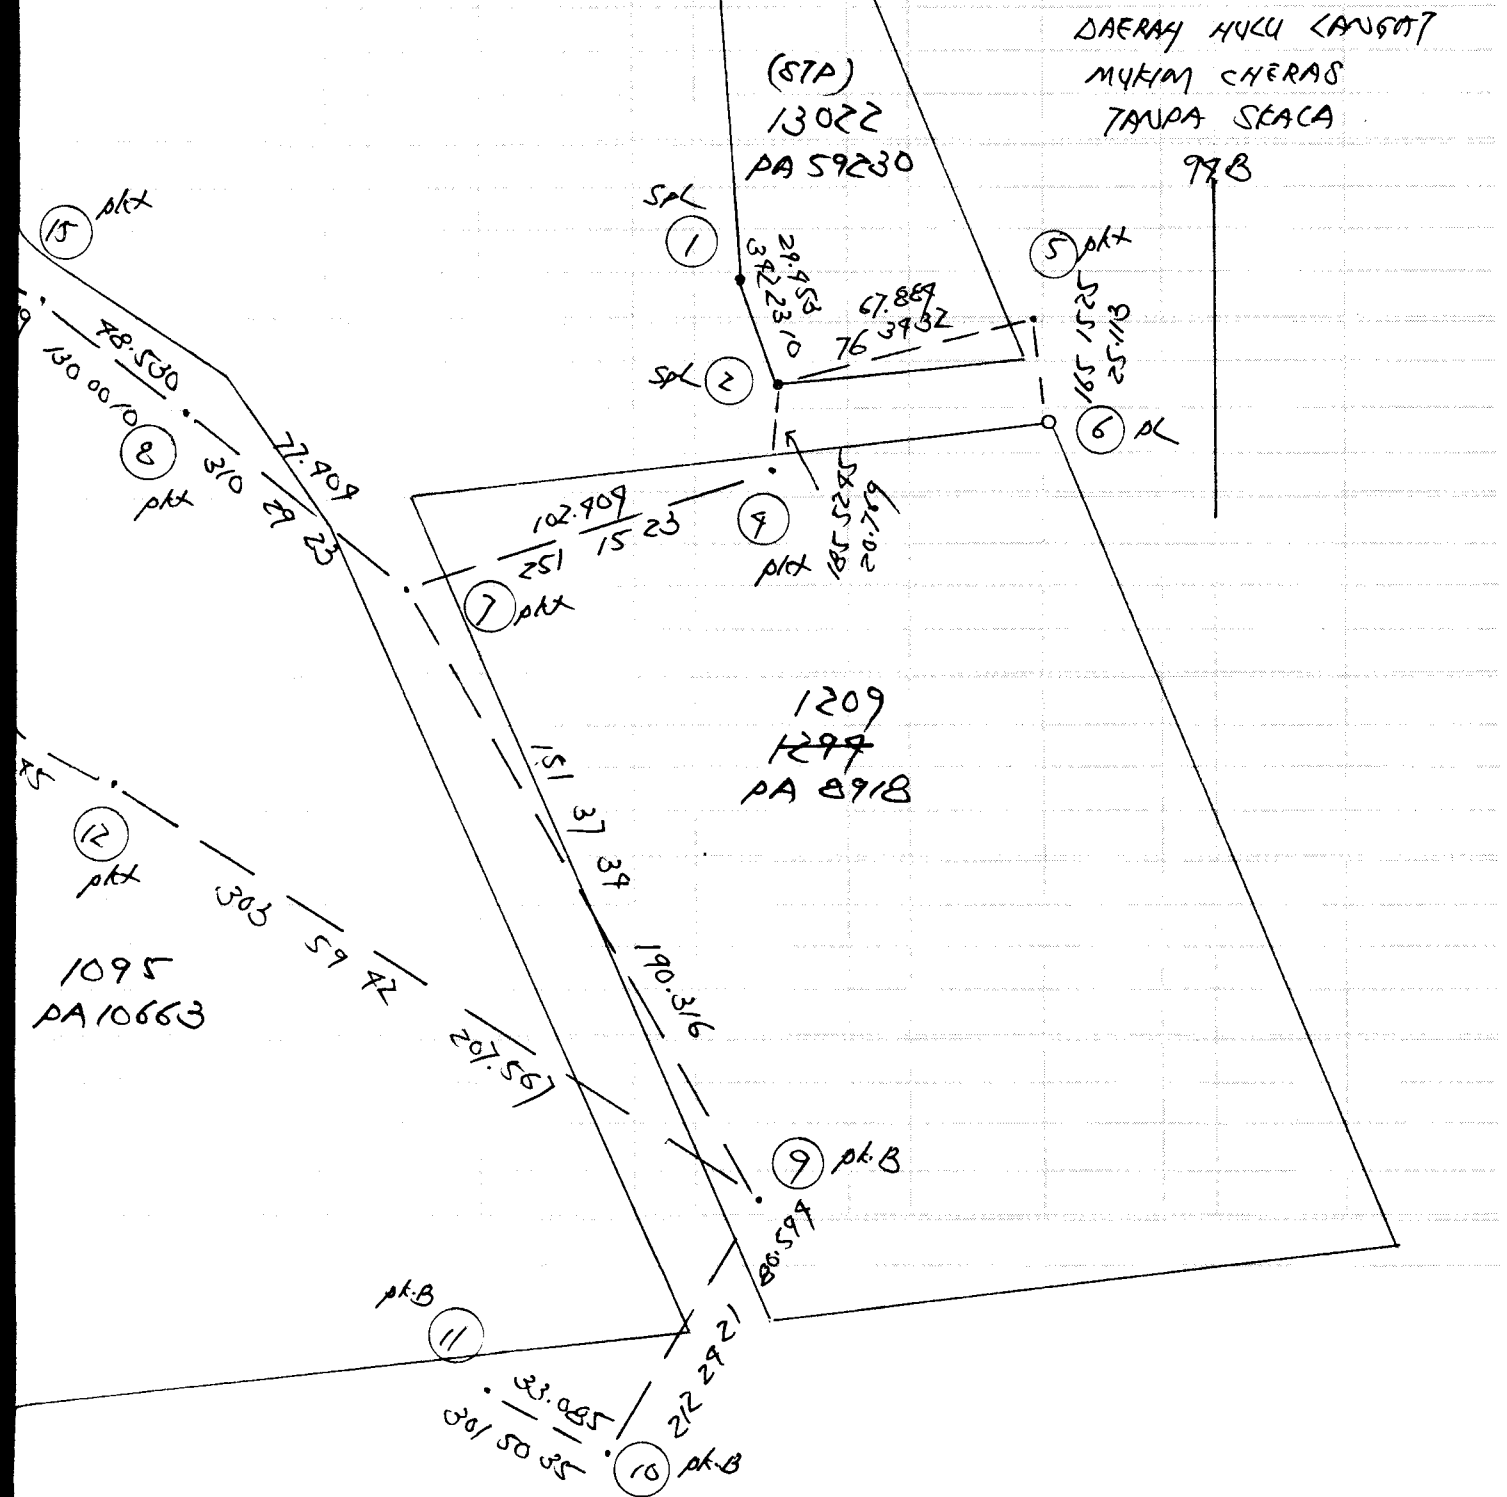

Cheng Anqian

Aras

Dibuat untuk

13

Tarikh

DRS 21/3/90

Ke

Pandangan
Belakang

Naik

Turun

Aras Yang
Dilars

Jarak

Catitan

0.063	(102)	(18.01)			72056	11001	(19)	
	2.626	(15.96)			69993	121 69964		
	2.851	(18.09)			69668	RC: 69.689		
0.783	(1.59)	8.15	(13.63)		67.962	Q		
2.225	(7.30)	1.013	(13.33)		67.982			
	0.957	(13.19)			68.700	78M 0471 - RC: 68.700M		2310 M/S
		0.738	(12.91)		68.923	15578 (K10)		DRS 200309
2771		5908						