

JRS 81671 Outamas.

Rapat di muka

21/5/201

Natwa Dapada 17 3033 2 17 3033 1 4 77.255 77.255  
 DA Ag At. pt. L

Dj 1114

1 17 3033 17 3033 32 0323 2 32 0323 3 4 30.936 30.936  
 2 pt. L  
 3 32 0323 212 0323

1 Septi Di Atwa 158 328 5805 2 158 5805 7 4 56.986 56.986  
 2 158 308  
 7 328 5805 758 5805  
 pt. B

1 Septi Di Atwa 12/3650 2 12/3650 5 4 63.337 63.337  
 2 5 12/3650 34 3650  
 pt. B

2 30/3650 12/3650 890501 5 890501 7 4 76.652 76.652  
 5 7 89 0501 2890501  
 pt. B

5 2890501 890501 1360103 7 1360103 8 4 35.377 35.377  
 7 8 1360103 3160103  
 pt. B

7 3160103 1360103 2762759 8 2762759 9 4 47.906 47.906  
 8

9 2762759 652759  
 pt. B

No. Lari

Kardinal

Kardinal

Kardinal

|    |         |         |         |    |         |    |    |         |           |
|----|---------|---------|---------|----|---------|----|----|---------|-----------|
| 8  | 662759  | 2962759 | 1951096 | 9  | 1951096 | 10 | 4  | 57.637  | 57.637    |
| 9  |         |         |         |    |         |    |    |         |           |
| 10 | 1951096 | 25 1096 |         |    |         |    |    |         |           |
|    | pk.     |         |         |    |         |    |    |         |           |
| 9  | 3251096 | 1951096 | 1555826 | 10 | 1555826 | 11 | 4  | 28.922  | 28.922    |
| 10 |         |         |         |    |         |    |    |         |           |
| 11 | 1555826 | 3255826 |         |    |         |    |    |         |           |
|    | pk.     |         |         |    |         |    |    |         |           |
| 10 | 3255826 | 1555826 | 2582855 | 11 | 2582855 | 12 | 4  | 9.871   | 9.871     |
| 11 |         |         |         |    |         |    |    |         |           |
| 12 | 2582855 | 762855  |         |    |         |    |    |         |           |
|    | pk.     |         |         |    |         |    |    |         |           |
| 10 | Sept    | Di. Aka | 2787831 | 11 | 2787831 | 13 | 4  | 72.566  | 72.566    |
| 11 |         |         |         |    |         |    |    |         |           |
| 13 | 2787831 | 687831  |         |    |         |    |    |         |           |
|    | pk.     |         |         |    |         |    |    |         |           |
| 11 | 687831  | 2787831 | 3027321 | 13 | 3027321 | 17 | 4  | 111.788 | 111.788   |
| 13 |         |         |         |    |         |    |    |         |           |
| 17 | 3027321 | 1227321 |         |    |         |    |    |         |           |
|    | pk.     |         |         |    |         |    |    |         |           |
| 13 | 1227321 | 3027321 | 0 00 03 | 17 | 0 00 03 | 7  | 4  | 79.677  | 79.677    |
| 17 |         |         |         |    |         |    |    |         |           |
| 7  | 0 00 03 | 1800003 |         |    |         |    |    |         |           |
|    | pk.     |         |         |    |         |    |    |         |           |
| 17 | 1800003 | 0 00 03 | 3385805 | 7  | 3385805 | 2  | 5A | Likt    | ms 29 R 3 |
| 7  |         |         |         |    |         |    |    |         |           |
| 2  | 3385805 | 1585805 |         |    |         |    |    |         |           |

Bering 7-2 Di. baka 338 58 05

Sapuluh Di. baka 338 58 05

Tika. baka

Vi/

Pembetulan

Vi/

No. Ind

Rajah dan muka

PEABIRU 50011

Tar

BARISAN

Ke

Sudu, Masjid

Tanjung

Ind

Jarak

A. M. A.

Tanjung

Jarak Muktamat

Desa Janda K.

Desa Janda Kapan

Jarak


Desa Janda Muktamat

1-12 150 5251 256.988 ✓  
 150 5192 256.960 PO  
 +1 9' +0.028

1-3 183 2731 78.661 ✓  
 183 2750 78.662 PO  
 -1 9' -0.001

No. Easi

Rajah di muka

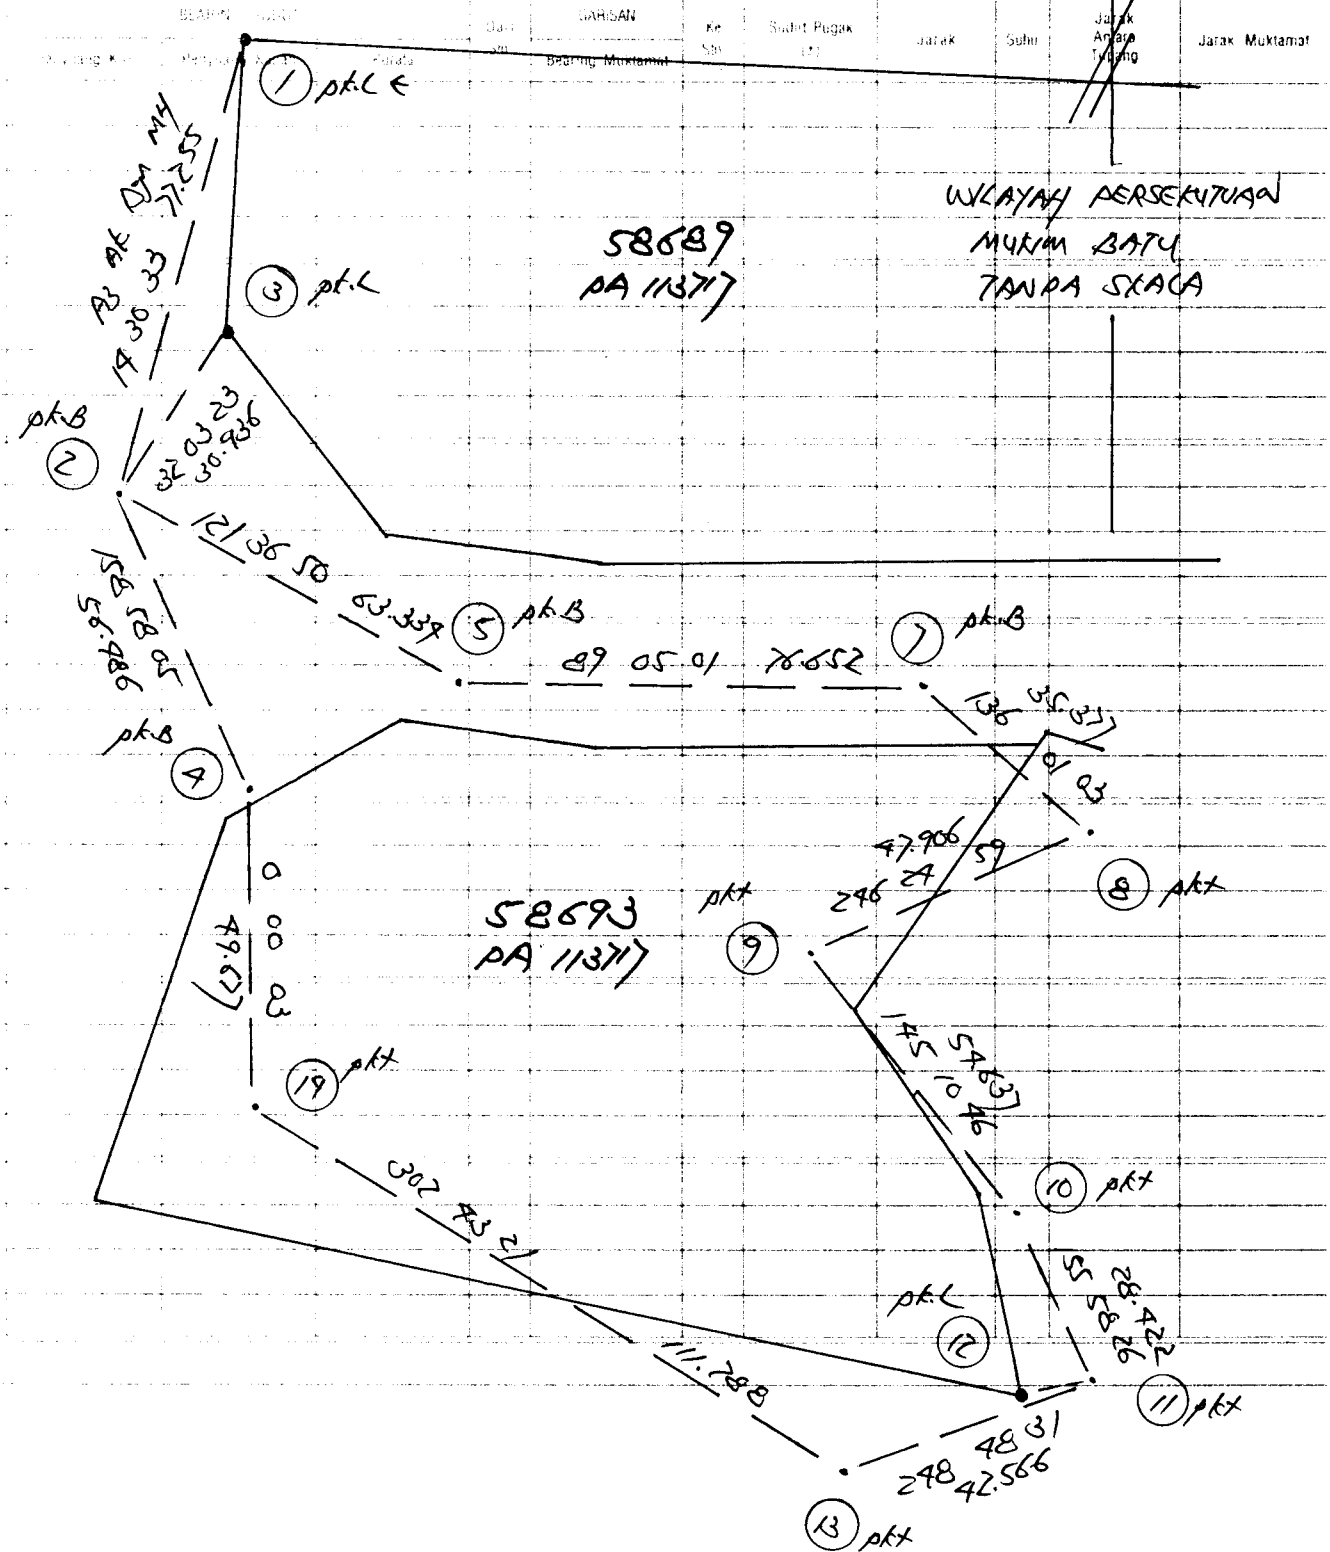

Autamas.

Aras

Dibuat untuk

15

Tarikh

28/5/68

Daripada

Ke

| Pandangan Belakang | Pandangan Antara | Pandangan Hadapan | Naik    | Turun | Aras Yang Dilaras | Jarak           | Catitan                 |
|--------------------|------------------|-------------------|---------|-------|-------------------|-----------------|-------------------------|
| 0.725              | (12.38)          | (15.20)           |         |       | 63.100            | 78M x 1892 / R2 |                         |
|                    | 1.585            | (15.20)           |         |       | 62.280            | 78M 6785 /      | RC: 62.280 ± 6y 685.    |
|                    | 1.599            | (15.25)           |         |       | 62.226            | 12026           |                         |
| 2.968              | (19.74)          | 1.390             | (18.39) |       | 62.785            |                 |                         |
| 3.315              | (10.88)          | 0.337             | (11.1)  |       | 65.116            |                 |                         |
| 3.507              | (11.50)          | 0.963             | (11.52) |       | 67.968            |                 |                         |
| 2.398              | (12.70)          | 0.066             | (10.21) |       | 71.909            | 78M 6785        | RC: 71.909m ± 6y 72.685 |
|                    |                  | 1.333             | (18.33) |       | 72.929            | x               |                         |