



Rajah di muka


## No. Fail

ZANDA SEACA

| Stasiun | BEARING SUDUT |                |        | Dari<br>Stn | GARISAN         | Ke<br>Stn | Sudut Pukak<br>( $\theta$ ) | Jarak | TANDA SEKA |                         |
|---------|---------------|----------------|--------|-------------|-----------------|-----------|-----------------------------|-------|------------|-------------------------|
|         | Penyiang Kiri | Penyiang Kanan | Purata |             |                 |           |                             |       | Subj       | Jarak Antara<br>Pangkal |
|         |               |                |        |             | Bearing Mukamat |           |                             |       | 117        |                         |

Demarcation.

|      |          |        |    |
|------|----------|--------|----|
| 8-10 | 296 0200 | 15.960 | AB |
| 8-11 | 290 5797 | 51.860 | AB |
| 9-12 | 235 9819 | 10.931 | AB |
| 9-13 | 233 7319 | 50.020 | AB |

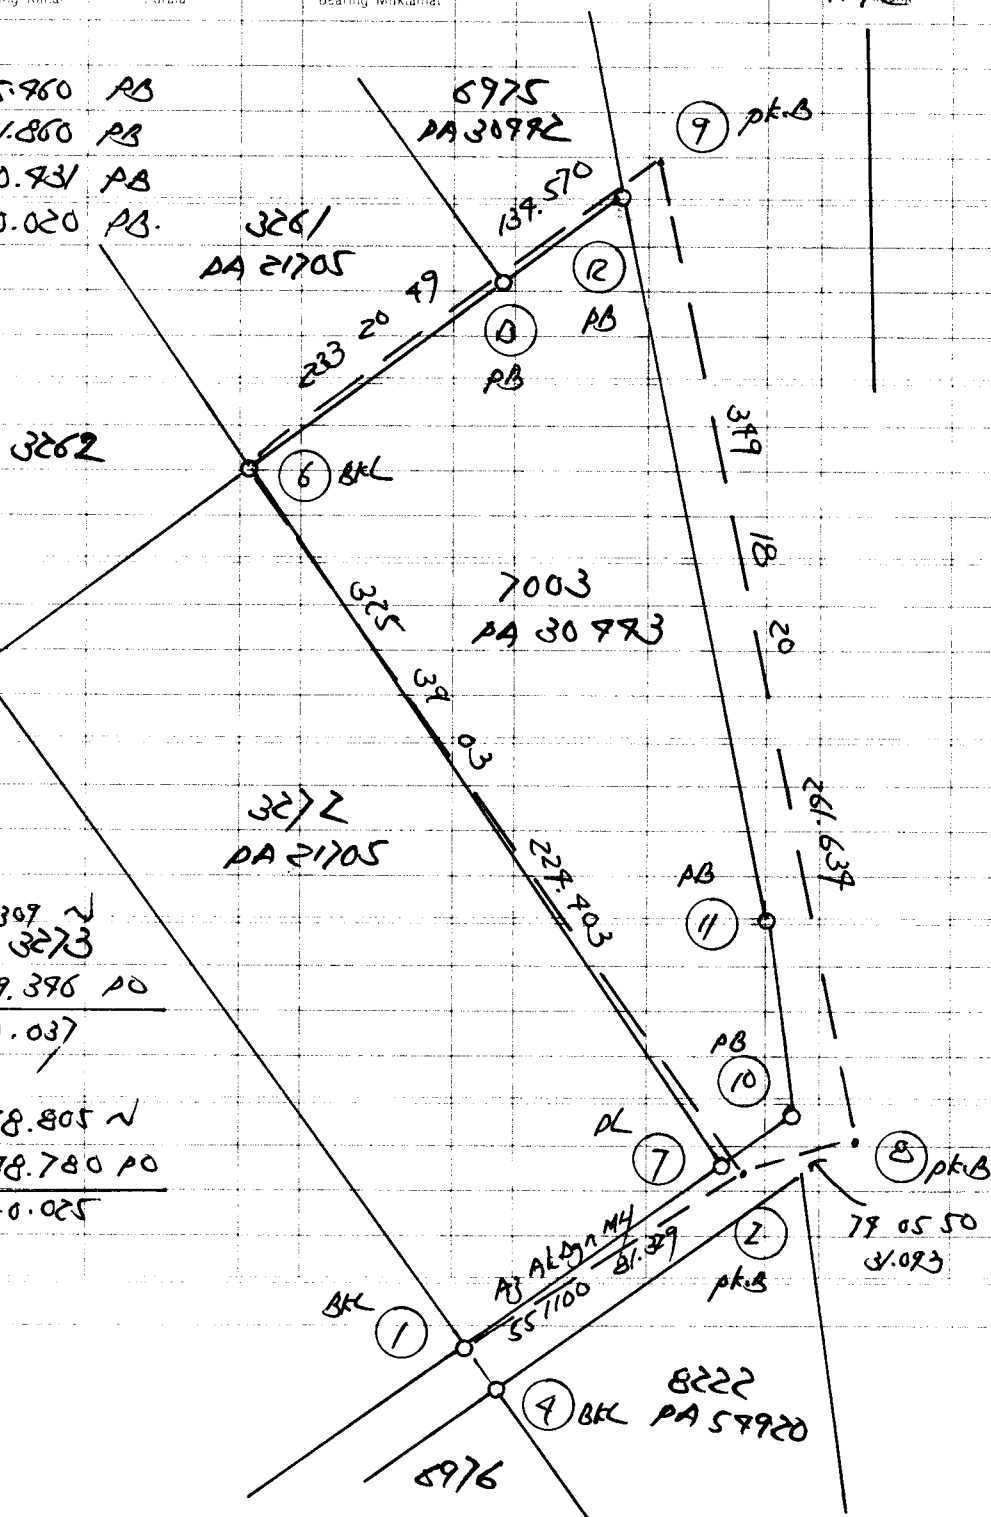

5-1 395 3107 239.3273  
395 3107 239.396 10  
31 -0.037

5-7 169 913 / 298.805 N  
169 70 78 298.780 PO  
+99' +0.025

kg Or Aki  
BT Taktikary

BT Changfeng

Aras

TR 8/733

Daripada

Ke

Dibuat untuk

| Pandangan Belakang | Pandangan Antara | Pandangan Hadapan | Naik   | Turun | Aras Yang Diaras | Jarak     | Catitan                     |
|--------------------|------------------|-------------------|--------|-------|------------------|-----------|-----------------------------|
| 1.978              | (16.79)          | 2.377             | (7.84) |       | 12023 78m41      | R 78m 41  | RC: 12073                   |
| 0.950              | (11.98)          | 2.377             | (7.84) |       |                  |           | All the heights based on BM |
| 0.236              | (10.77)          | 2.696             | (8.85) |       |                  |           | B 0951                      |
| 2.280              | (7.48)           | 1.769             | (5.80) |       |                  |           |                             |
| 2.155              | (7.07)           | 0.781             | (2.56) |       |                  |           |                             |
| 0.746              | (2.95)           | 2.321             | (7.80) |       |                  |           |                             |
| 1.296              | (9.25)           | 2.224             | (7.30) |       |                  |           |                             |
| 9.191              |                  | 1.537             | (5.09) |       | 7.509 BM         | BM 85253  | B (5000) Di bawah 5/8       |
|                    |                  | 13.705            |        |       |                  | BM 85253  | Payas Machi Westlands.      |
| 1.537              |                  |                   |        |       | BM               |           | 5/8 BM                      |
| 0.853              | (2.80)           | 1.666             | (5.87) |       | 7.509            |           |                             |
| 1.087              | (3.57)           | 1.674             | (5.33) |       |                  |           |                             |
| 1.019              | (3.38)           | 2.098             | (6.86) |       |                  |           |                             |
| 1.764              | (5.78)           | 1.663             | (5.86) |       |                  |           |                             |
| 1.585              | (5.13)           | 1.986             | (4.78) |       |                  |           |                             |
| 1.5285             | (5.20)           | 1.604             | (5.28) |       |                  |           |                             |
| 1.596              | (5.19)           | 1.575             | (5.17) |       |                  |           |                             |
| 1.584              | (4.25)           | 1.711             | (5.61) |       |                  |           |                             |
| 1.295              |                  | 1.615             | (5.30) |       | 7.796 BM         |           |                             |
| 12.289             |                  | 15.002            |        |       |                  | 78m 41940 |                             |

Tarikh ..... Aras

Dibuat untuk .....

Daripada .....

Ke .....

| Pandangan Belakang | Pandangan Antara | Pandangan Hadapan | Naik   | Turun | Aras Yang Dilaras | Jarak     | Catitan |
|--------------------|------------------|-------------------|--------|-------|-------------------|-----------|---------|
| 1.615              | 1.933            | (4.70)            |        |       | 7.796 -           | 78M F1988 |         |
|                    | 1.980            | (4.72)            |        |       | 7.968             | F1096     |         |
| 1.758              | (5.78)           | 1.748             | (5.72) |       | 7.971             | F1097     |         |
| 1.611              | (5.29)           | 1.380             | (8.53) |       | 5.081             | F1050     |         |
| 1.568              | (5.13)           | 1.391             | (8.55) |       | 5.261             | F1056     |         |
|                    | 1.681            | (5.52)            |        |       | 5.198             | F1006     |         |
|                    |                  | 1.322             | (4.50) |       | 5.953             | F2        |         |
| 6.598              |                  | 5.887             |        |       |                   | 78M F1949 |         |

