

JRS 81636 Pulau Miranti

Kajang Branku

2/11/2011

Natun Daripada 3365820 2 3365820 1 4 47.785 47.785
pk.B Sp-L

1 3365820 1565820 3033915 2 3033915 3 4 20.282 20.282
2

3 3033915 2233915
Sp-L

1 Spriti Di Atas 2283910 2 2283910 7 4 31.827 31.827
2

7 2283910 8983910
pk.B

1 Spriti Di Atas 1760210 2 1760210 5 4 52.780 52.780
2

5 1760210 3580210
pk.B

2 3580210 1760210 1705320 5 1705320 8 4 99.622 99.622
5

8 1705320 3505320
pk.B

7-6 1823120 7 1823120 6 4 11.791 PL 11.791

8-9 682515 8 682515 9 4 116.209 PL 116.209


5 3505320 1705320 1792220 8 1792220 10 4 163.895 163.895
8

10 1792220 3592220
pk.B

8	3572220	1782220	871926	10	871926	11	4	135.978	135.978
10	11	871926	2671926						
		pk.							
10	2671926	871926	3392801	11	3392801	12	4	105.095	105.095
11									
12	3392801	1592801							
		pk							
11	1592801	3392801	2298025	12	2998025	13	4	12.961	12.961
12									
13	2998025	1198025							
		pk							

No. 141

Rajapada moka

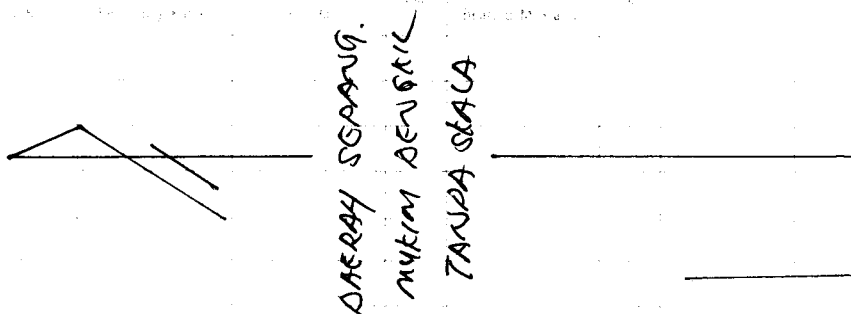Demarcate 01 1770112.


11-50 2793205 52.735 PB (RM offset 2m)
 11-51 2930018 10.061 PB
 12-52 875227 28.201 RLB
 12-53 2762318 11.379 pt.B.

1-9 1360929 211.090 ~
 1360902 211.095 PD

 722' -0.085

3-9 1293717 187.792 ~
 1293639 187.792 PD

 738' -0.021

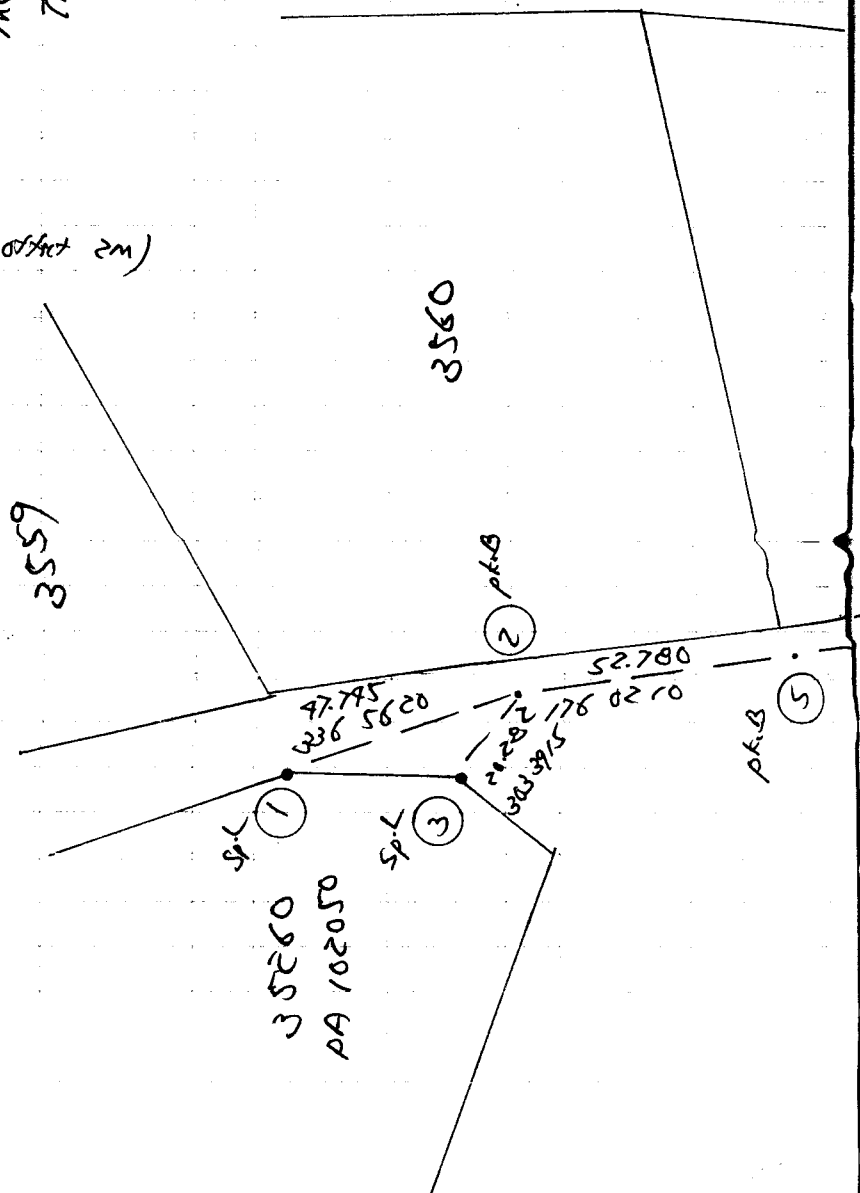



11-66 262 36 91	62018 (77)
11-61 259 06 09	65.155 (PB) -RM (offset 5m)
11-62 222 44 44	11.260 (77)
11-63 210 01 48	15.326 (PB) -RM (offset 5m)
11-69 186 52 34	66.477 (PB)
11-65 235 12 58	119.861 (PB)