

TR581832 Bkt Sybang Title.

Datum Daripada 56 1331 2 ⁵⁶ ~~236~~ 1331 1 4 18/1/2017 78.917 78.917
 FB 130 m/535 pt.B pt.C
 R1 pt.C

2-3	230 0005	2	230 0005	3	4	51.125	BKL	51.125
2-4	228 5138	2	228 5138	4	4	79.937	BKL	79.937

1 56133/236133/2330205 < 2330205 5 4 170.036 170.038

5 23 0205 53 0205

РКБ

PKB
2 53 02 05 233 02 05 285 08 26 5 285 08 26 6 4 138 255 138 255

6 285 0826 / 105 0826

pt. B

5 ^{pk-B} 1050828 2850828 2992036 6 2992036 7 H 127.379 127.379

6
297 2036 117 2036

pkf

6-8	80 0125	8	80 0125	8	4	51.570	BK	51.570
7-9	180 1522	7	180 1522	9	4	18.390	PK	18.390

6 1A 2036 29 2036 662106 7 662106 10 4 30.798 p 30.798

10 8621082762108

Р.К.В


7	2962106	662106	3362219	10	3362219	11	4	86.522	86.522
10	11	3362219	1562219						
		pk.							
10	1562219	3362219	120829	11	120829	12	4	115.865	115.865
11	12	120829	1920829						
		pk.							
11	1920829	120829	2213995	12	2213995	13	4	28.891	28.891
12	13	2213995	913995						
		pk							
11	Sept	A: A6	1092907	12	1092907	19	4	117.052	117.052
12	17	1092907	289007						
		pk.							
12	2892907	1092907	1839156	19	1839156	15	4	86.602	86.602
19	15	1839156	39156						
		pk							
19	39156	1839156	1179336	15	1179336	16	4	82.091	82.091
15	16	1179336	3579336						
		pk							
15	3579336	1179336	1905535	16	1905535	6	4	50.750	50.750
16	6	1905535	105535						

16 10 5535 190 5535 2982036 6 2982036 7 Sila Liket m/s 27 R5
 6
 7 2982036 1182036 Bring
 Terhuy.

Bring 6-7 Dibaca 2982036
 Sepatutnya Dibaca 2982036
 Titikatan Nil
 Ambekulan Nil

Plant Store.

6-50	82989	31.006	pk.B
10-51	1095822	53.253	pk.B
10-52	762832	13.367	pk.B
10-53	720898	12.761	pk.B
11-58	1105588	7.118	PB
12-55	2152295	36.680	PB
12-56	1705057	35.571	PB
19-57	3093553	10.095	PB

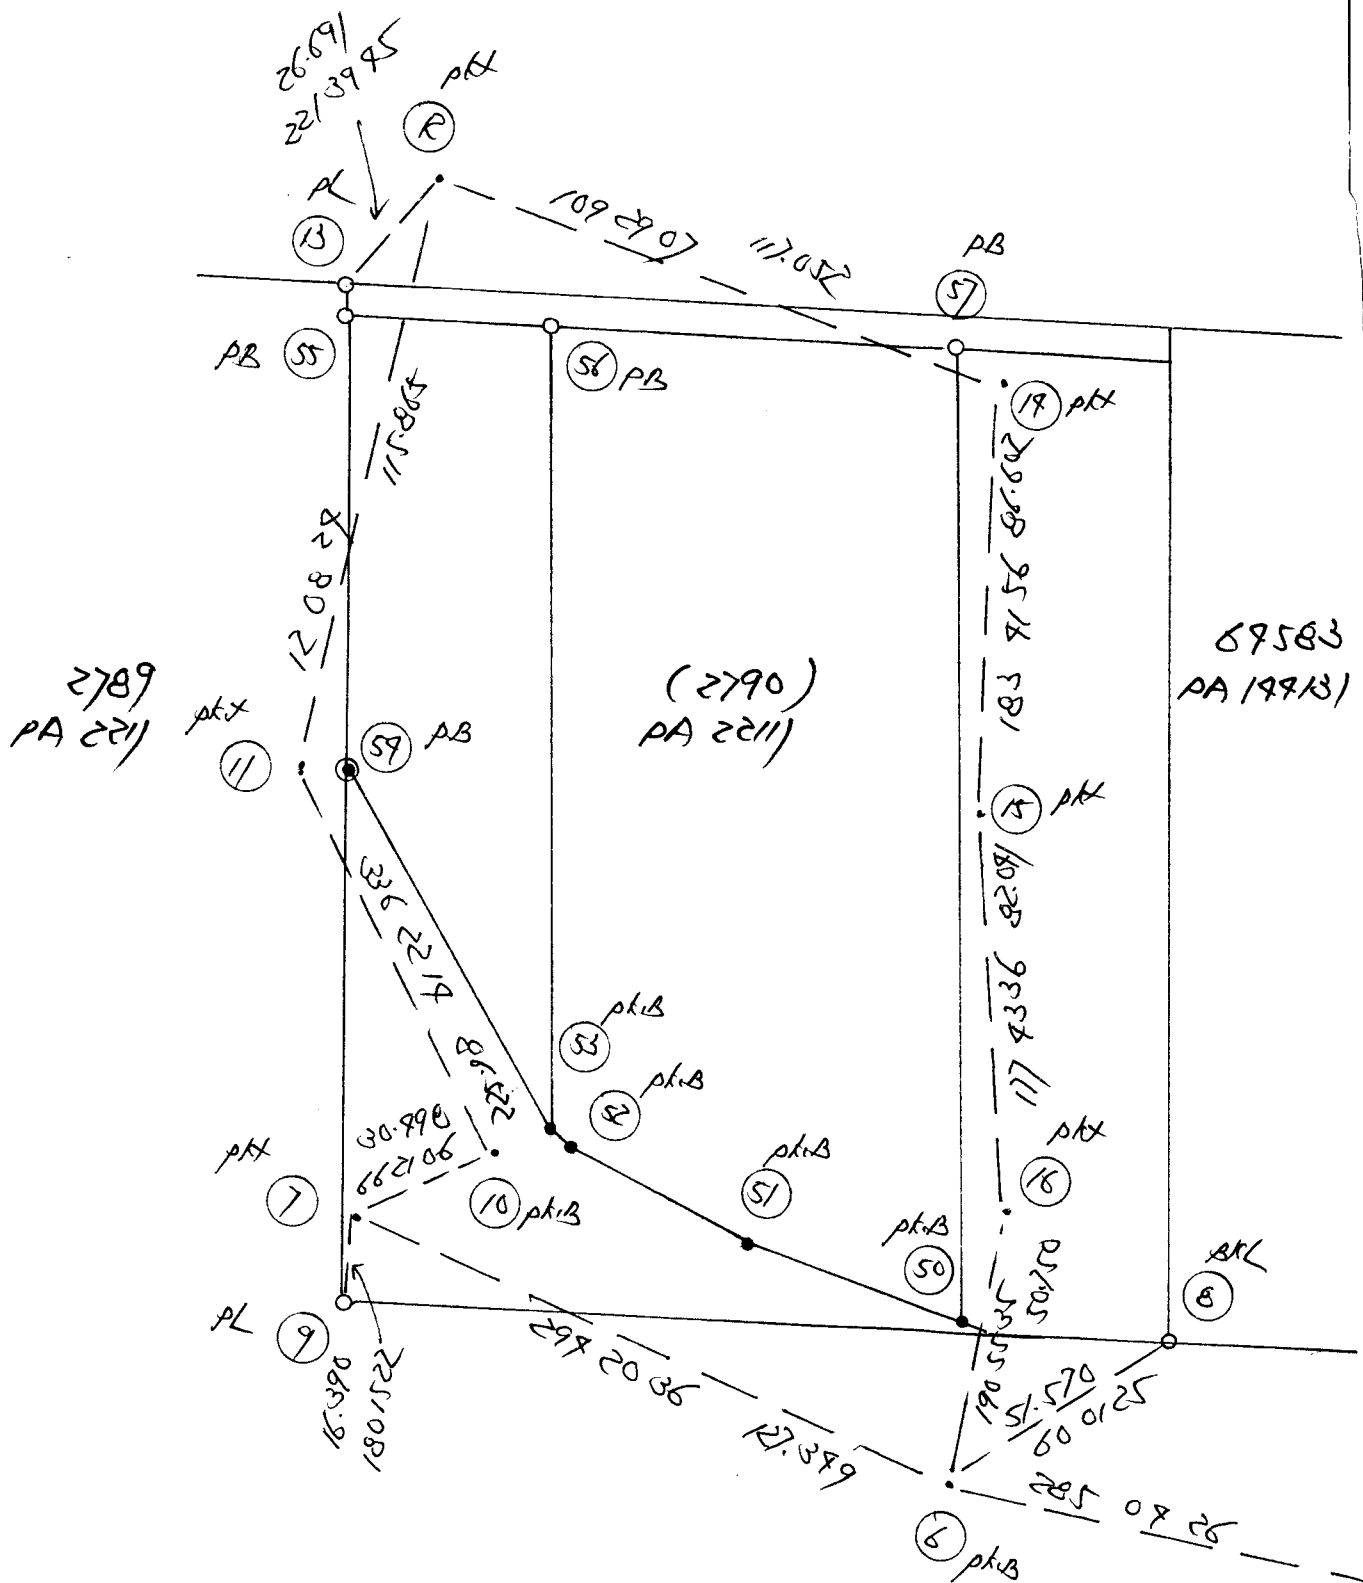

DAERAH DETALING.
 MUHAM SYNGAI BUKAH
 89A
 TANPA SKALA

8-13 322 4536 285.795 ~
 322 4538 285.790 PO
 -21 70.005

8-9 273 7077 161.103 ~
 273 7106 161.099 PO
 -16 70.007

