

TRJ81855 ³ Tropika Kemenuh

No. fail

Rajah di muka

Tinggi	BEARING SUDUT			Dari Stn	GARISAN		Ke Stn	Sudut Pagar (°)	Jarak	Sudut	Jarak Antara Pangang	Jarak Muktamat
	Bearing Kem	Bearing Kumpul	Pusat		Bearing Muktamat							
	Datum	Daripada	255 1726	2	255 1726	1	4		255.353			255.353
					pkx Az Ak. pkx							
					Dgn 114							
1	255 1726	75 1726	352 3998	2	352 3998	3	4		79.829			79.829
2												
3	352 3998	172 3998										
					pkx							
1	Seperti Di Atas		562 999	2	562 999	7	4		62.852			62.852
2												
7	562 999	236 2999										
2	172 3998	352 3998	187 5891	3	187 5891	5	4		73.280			73.280
3												
5	187 5891	7 5891										
					pkx (787 12007)							
3	7 5891	187 5891	209 8595	5	209 8595	6	4		97.791			97.791
5												
6	209 8595	27 8595										
					pkx.							
6-7	30 1052	210 1052		6	30 1052	17	4		98.599		BAL	98.599
6-18	182 0219			6	182 0219	18	4		30.906		BAL	30.906
											(787 12008)	
5	27 8595	209 8595	129 3087	6	129 3087	7	4		73.709			73.709
6												
7	129 3087	309 3087										
					pkx							

No. Fail

Rajah di muka

Stesen	BEARING / SUDUT			Dari Stn	GARISAN		Ke Stn	Sudut Pukak (°)	Jarak	Sudut	Jarak Antara Tiang	Jarak Muktamad
	Penyalang Kiri	Penyalang Kanan	Purata		Bearing Muktamad							
6	309308	29308	63712	7	63712	8	4	59.892			59.892	
7	8	63712	283712									
	pk											
7	283712	63712	138392	8	138392	9	4	67.532			67.532	
8	9	138392	318392									
	pk											
8	318392	138392	105905	9	105905	10	4	69.991			69.991	
9	10	105905	81905905									
	pk											
9	1905905	105905	267559	10	267559	11	4	55.220			55.220	
10	11	267559	2067559									
	pk											
9-12	1533015			9	1533015	12	4	3.287	BAL		3.287	
11-13	2017357			11	2017357	13	4	39.350	BAL		39.350	
11-17	63237			11	63237	17	4	8.969	BAL		8.969	
10	2067559	267559	3732830	11	3732830	15	4	73.133			73.133	
11	15	3732830	1632830									
	pk											
11	1632830	3732830	267397	15	267397	7	4	56.950			56.950	
15	7	267397	87397									
1	15	87397	267397	2362779	2	267397						
7	2	2362779	562779									
					Bering							
					Tertutup							

Site Liket m/s 1 R3.

Sila Lihat m/s 1 R3.

No. 100

Kategori muka

DASAR

Berkas M. 1000


Jarak
antara
tulang

Jarak Maksimal

18-19 572220 217.195 ✓
 572251 217.223 PO
 —————
 -31' -0.028

18-13 762795 183.009 ✓
 762519 183.022 PO
 —————
 88' -0.013

1994, 1995, 1996,26

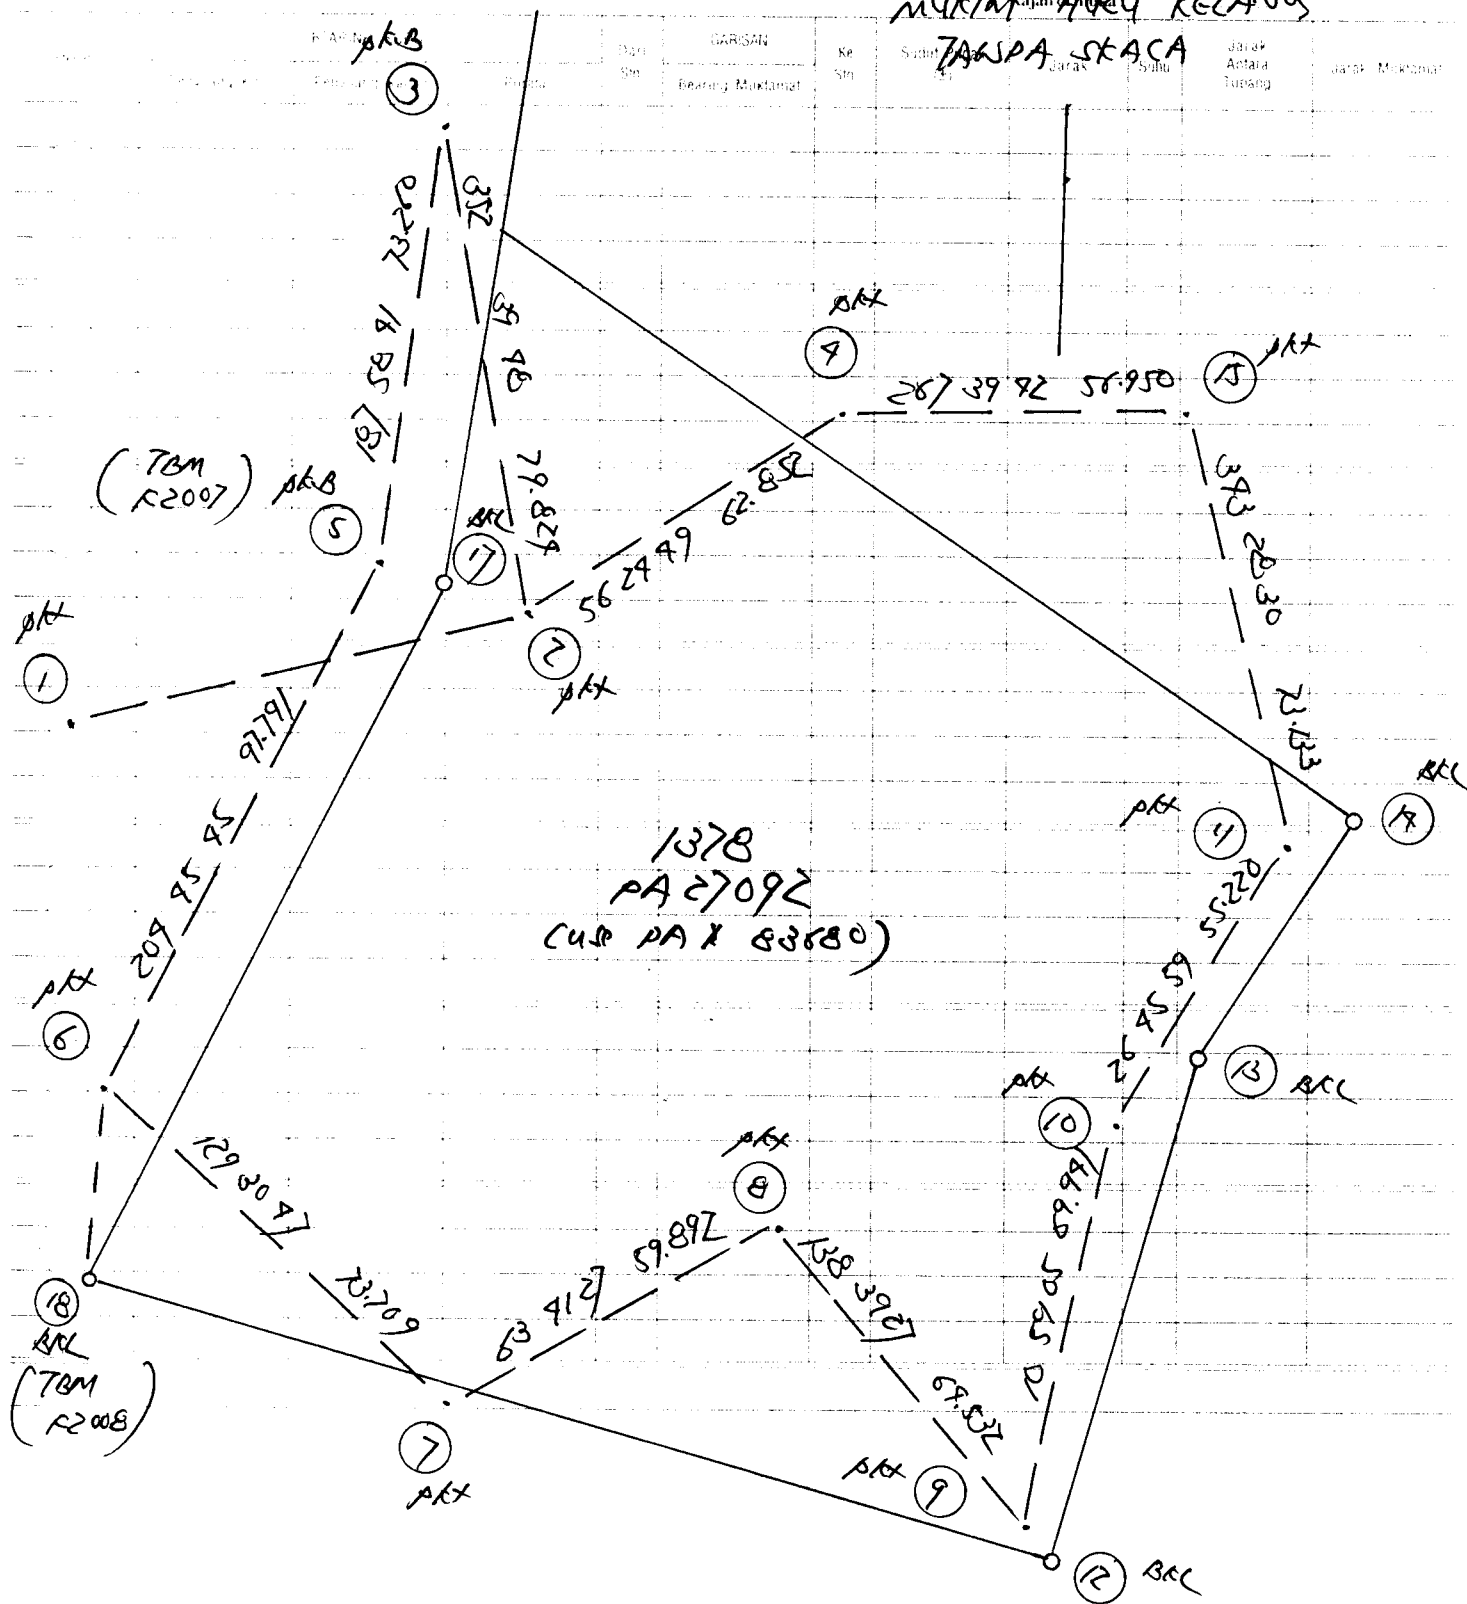

Tarikh *Tropika Kemuning* Aras

Dibuat untuk

Daripada *TRJ 80953*

Ke

Pandangan Belakang	Pandangan Antara	Pandangan Hadapan	Naik	Turun	Aras Yang Dilaras	Jarak	Catitan
3368	(11.05)				100.899	52	1819 m/s 27
0.193	(10.63)	3.858	(1200)		100.104		
0.323	(11.03)	3.990	(13.09)		96.307		
0.588	(11.78)	2.791	(19.6)		93.829	<i>TRM 12807</i>	
0.598	(11.86)	3.976	(11.89)		90.897	<i>905</i>	
		1.673	(15.89)		89.822	<i>TRM 12008 Atas Rk.</i>	
5.016		15.588					

*All the heights based on
TRJ 80952 Kemuning heights.*