

TR580365 Sierra Mar. Lyobas.

No. Fail

Rajah di muka

[illegible]

Rajah di muka


[illegible]

Rajah di muka

[illegible]

No. Fail

Rajah di muka

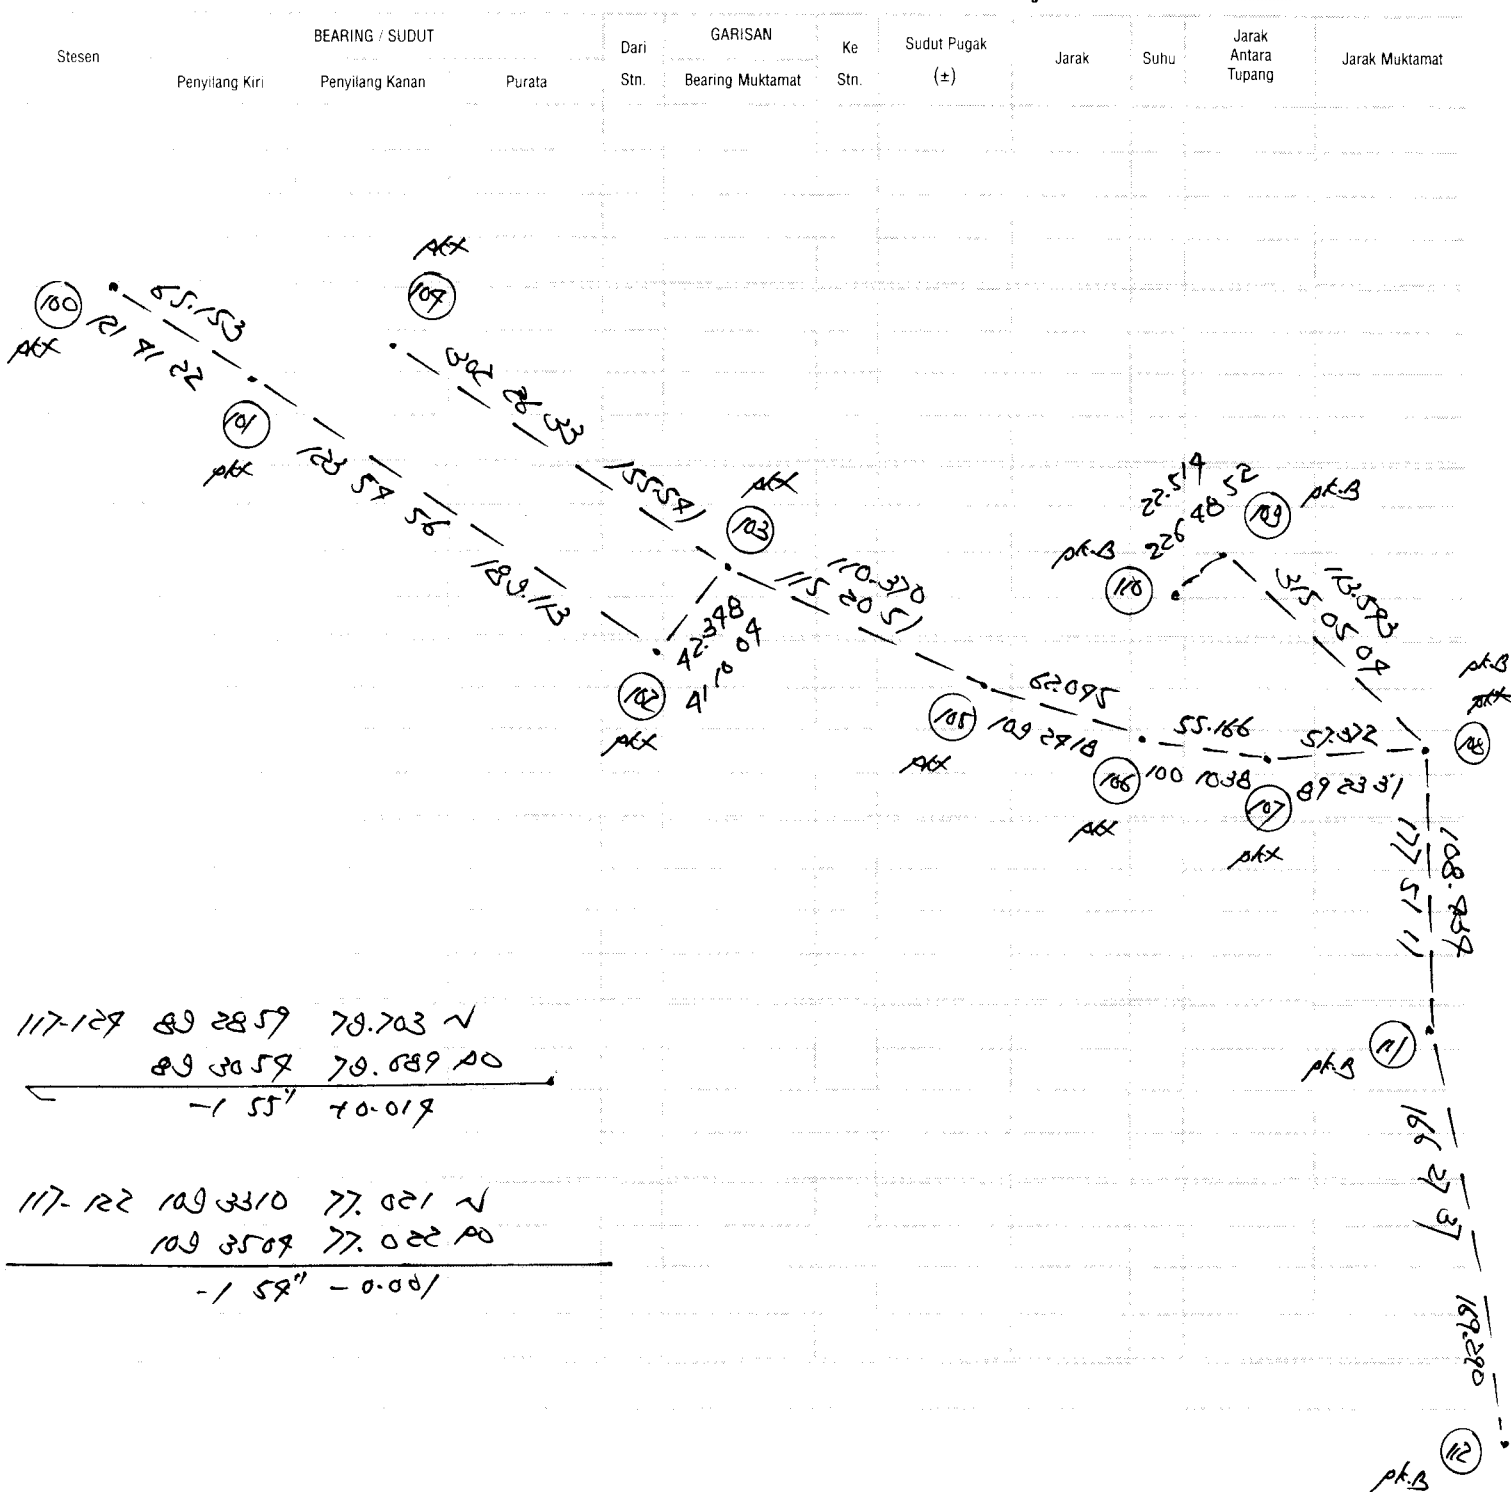

No. Fail

Rajah di muka

Stesen	BEARING / SUDUT			Dari Stn.	GARISAN Bearing Mukamat	Ke Stn.	Sudut Pugak (±)	Jarak	Suhu	Jarak Antara Tupang	Jarak Mukamat
	Penyilang Kiri	Penyilang Kanan	Purata								

DAERAH DETAILING.
MUKIM SUNGAI BUKOH
76-D
ZANPA STACA

