

Lim Cheng Chye

H/P: 012-215 0775

PEMBINAAN ANAK ARBUMI SDN BHD
(200010-P)

Contractor For:

- Earthwork
- Demolition Work
- Hire of Hydraulic Excavator
- Hire of Hydraulic Breaker

No. 2-29-B

Jalan Desa 1/1

Desa Aman Puri

52100 Kepong, Kuala Lumpur

Tel: 03-6277 5650, 6273 5330

Fax: 03-6277 6260

Rajah di muka

[illegible]

Rajah di muka


[illegible]

No. Fail

Rajah di muka

[illegible]

MUKIM PETAKUNG.
DAERAH PETAKUNG.
TANPA SKALA

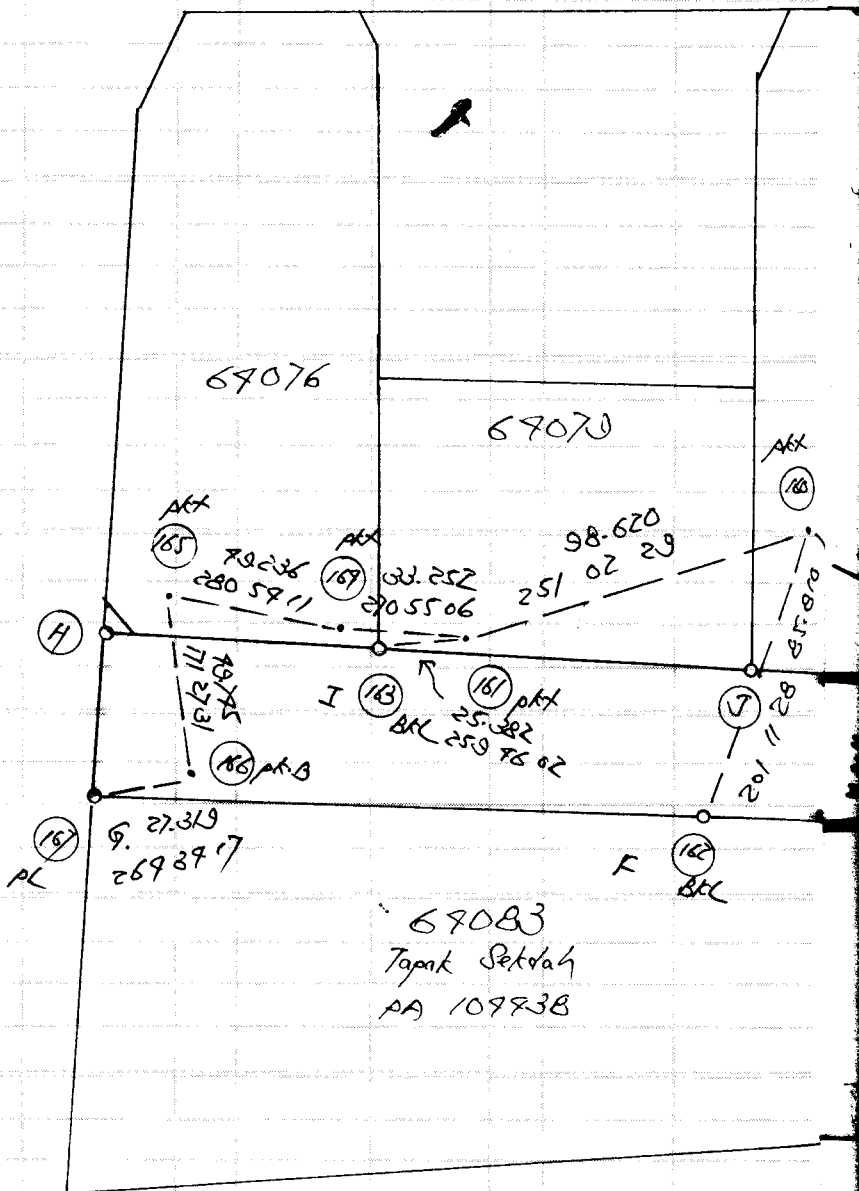

150-A	5 06 36	22.062	4WD
150-B	332 52 31	28.291	pk-B
150-O	1 93 17	63.157	4WD
150-N	396 56 99	68.601	pk-B
157-C	250 07 05	36.669	4WD
157-M	303 52 20	79.796	4WD
158-D	196 53 16	29.923	4WD
158-K	338 12 29	17.698	4WD
160-J	203 72 21	73.975	4WD
165-H	236 04 50	20.907	4WD

Tarikh 2025 Durrant. Aras

Dibuat untuk 77

Daripada TRS 80373

Ke

Pandangan Belakang	Pandangan Antara	Pandangan Hadapan	Naik	Turun	Aras Yang Dilaras	Jarak	Catitan
0.30/ (0.79)		0.682	(2.29)		17.985	400V	RM : 20509
2.003 (6.57)		1.258	(4.13)				574 F/1 sh/ma. TR58098
2.119 (6.99)		1.886	(6.19)				
1.372 (4.51)		1.929	(4.69)		18.020	F11 (784 F1298)	m/s 19.
5.790 -		5.855				RC: 18.020	