


[illegible]

No. Fail

Rajah di muka

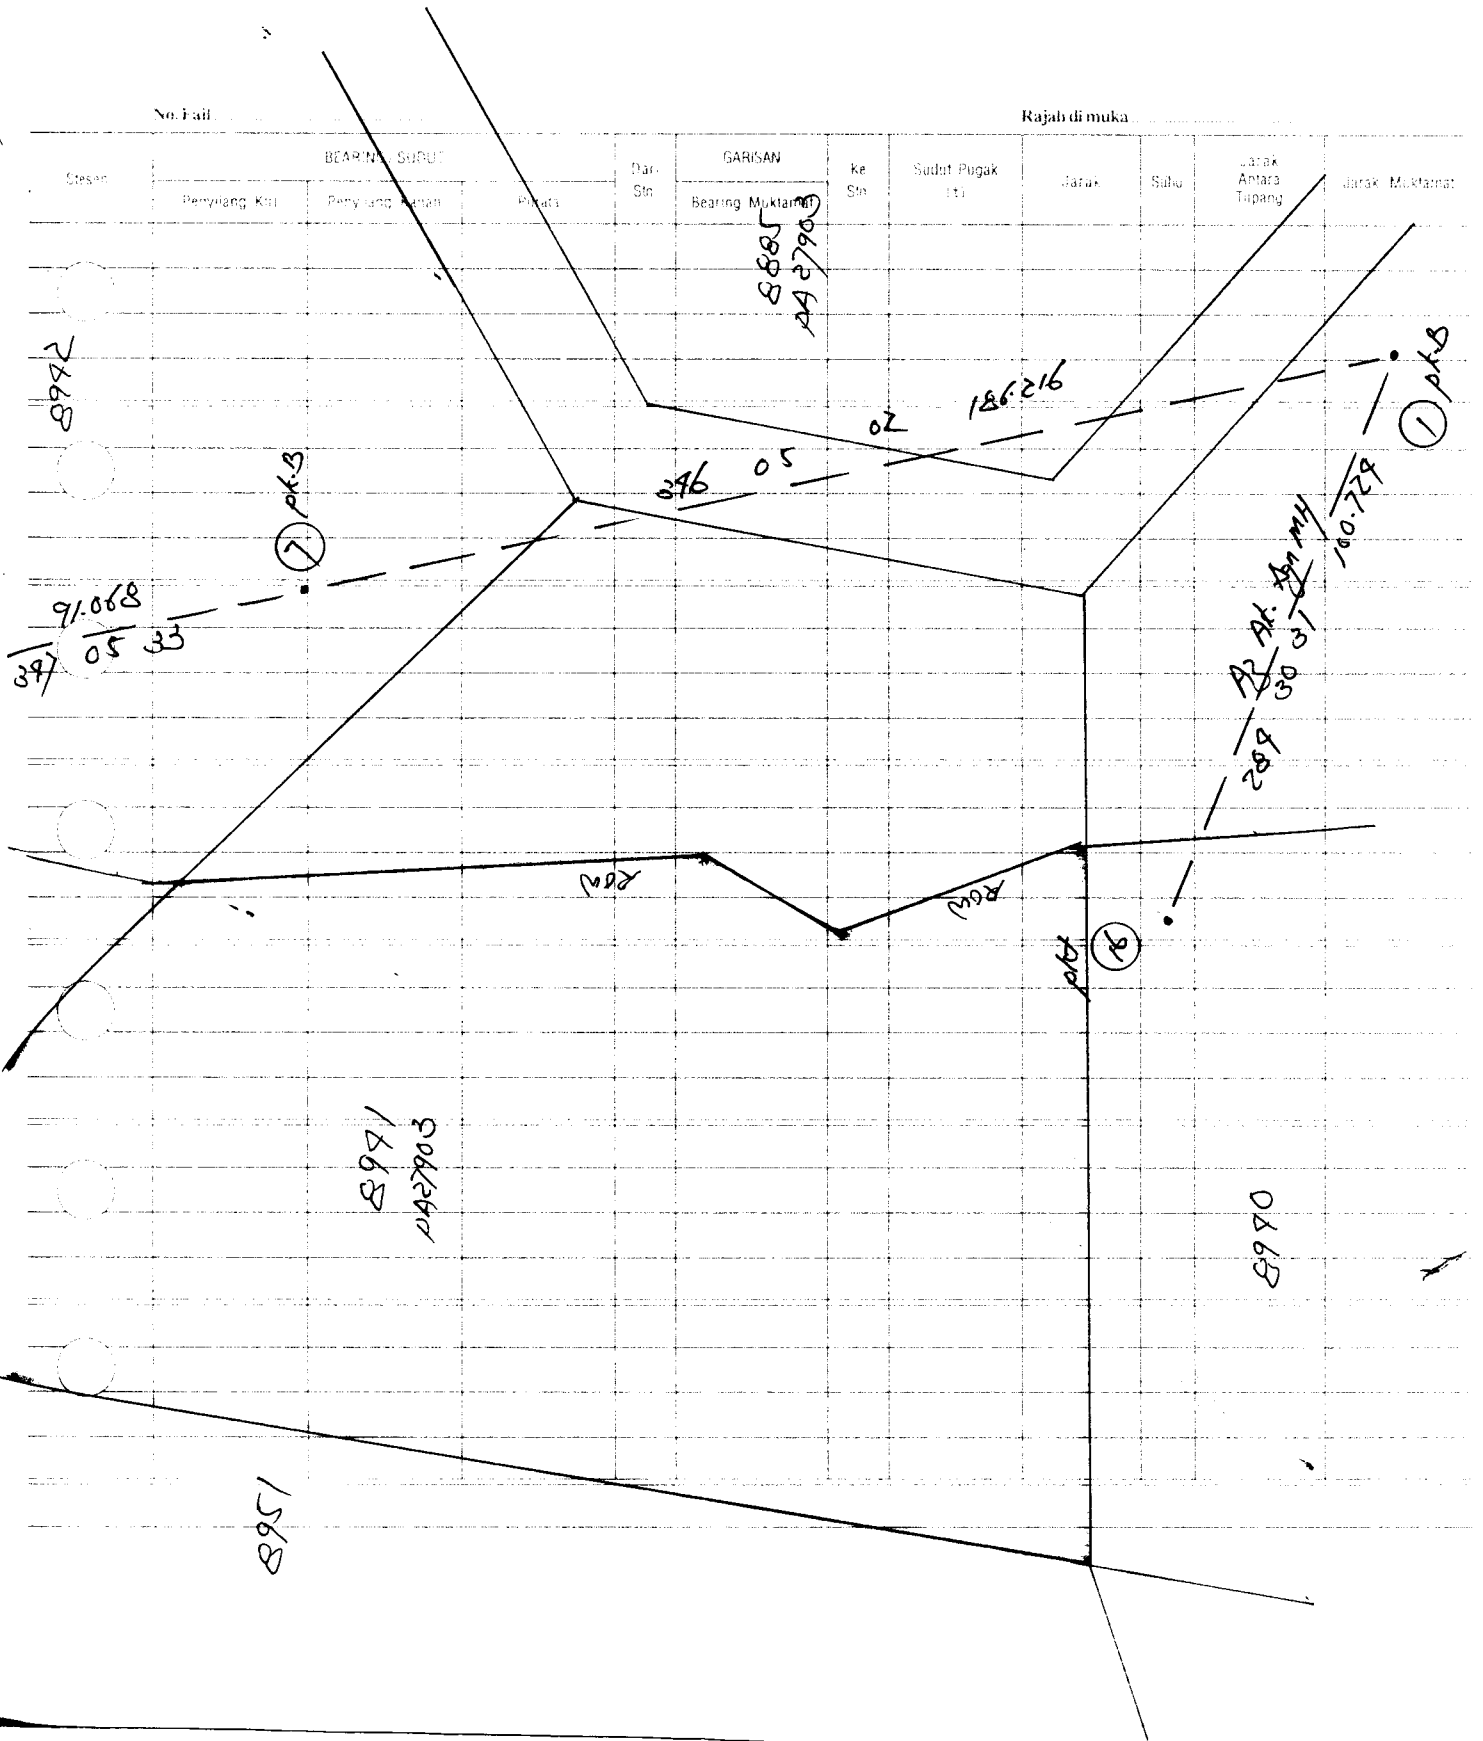

CERAPAN MATAHARI BAGI AZIMUT

12

Penilik _____ Hari _____ Tarikh _____ Bulan _____ Tahun _____
 Stesen _____ T.R. _____ B.K. _____ Ms. _____ Tiodolair (jenis) _____ I Bah. Aras Ufuk - a _____

Penilik: JRS80503 Putra Jaya P16 Tarikh: 10/06/2008

Stn. 16 Koordinat: S27902 T 911 Selangor

T.R. 1 B.K.FB111 Ms.16

Tiodolit Laica Satu bah. aras ufuk:

Waktu	Sasaran	Ufuk	Gelembong	Puguk		
	T.R.	99 20 16				
8 36	M.H.	61 37 52		69 56 23	Waktu purata	8 36 30
8 36	M.H.	61 03 40		69 52 12	Beza dari U.T. -	8 00 00
8 37	M.H.	241 02 51		290 14 25	U.T.	0 36 30
8 37	M.H.	241 36 04		290 19 03	Deklinasi	23 01 36
	T.R.	279 20 16				
	T.R.	99 20 16				
8 38	M.H.	61 35 38		69 34 24	Waktu purata	8 38 30
8 38	M.H.	61 01 24		69 29 23	Beza dari U.T. -	8 00 00
8 39	M.H.	241 00 34		290 36 15	U.T.	0 38 30
8 39	M.H.	241 33 51		290 39 15	Deklinasi	23 01 36
	T.R.	279 20 16				

	Set 1	Set 2
Sudut pugak	20 11 13	20 32 56
Pembetulan	- 0 02 15	- 0 02 13
Altitud	20 08 58	20 30 43
Jarak kutub	66 58 24	66 58 24
Latitud	2 55 18	2 55 18
Azimut M.H. yang dikira	66 31 01	66 28 44
Purata ke M.H.	61 20 07	61 17 52
Selisih:	5 10 54	5 10 52
Purata ke T.R.	99 20 16	99 20 16
Azimuth T.R. sebenar	104 31 10	104 31 08
Pembetulan aras	+ 0 00 00	+ 0 00 00
Tirusan	- 0 00 38	- 0 00 38
Bering grid T.R.	104 30 32	104 30 30

Purata bering grid T.R. 104 30 31

Tarikh Aras

Dibuat untuk

Daripada

Ke

Pandangan Belakang	Pandangan Antara	Pandangan Hadapan	Naik	Turun	Aras Yang Dilaras	Jarak	Catitan
0.203					33.589	72M F1760	
0.17	(10.98)	3.808	(12.99)				
2.527	(18.29)	2.715	(18.91)				
2.787	(19.14)	0.195	(10.98)				
3.692	(11.95)	0.127	(10.92)				
3.821	(12.58)	0.057	(10.19)				
3.540 13.127		0.205	(10.67)		39.659	F2	
3		7.057					
3.510	(14.51)				39.659	F2	
3.669	(12.09)	0.125	(10.91)		43.099		
3.872	(12.70)	0.155	(10.51)		46.558	F1	
3.285 2.872	(10.34) (9.42)	0.253	(10.83)		50.117		
3.820	(12.53)	0.398	(1.13)		53.667	F1	
18.197		0.038	(10.13)		56.899	F8	
		0.969					
2.792	(19.16)				46.558	F1	
3.601	(11.81)	0.303	(10.99)				
3.608	(11.84)	0.358	(11.18)				
3.180	(10.93)	0.374	(11.23)				
13.181		1.891	(16.20)		56.863	72M F1761	naik di Atas daing.
		2.926					