

JRS 80515 Sri May.

28/6/08

Satum Daripack	820900	2	815727	1	H	H	H	71.960
PA	M- 8'33"	pkB		BCL				
				pk-B				71.82

1 820900262090097517 2 9777773 32.926
2 M-633

3 94517 274 517

BKL

1. Segreti Di Atas 258903 2 2583370 7 4 30.621 30.621
2 M- 633

7 2587013 78 7013

BKL

1 Septi Di Atas 992723 2 992050 5 4 10.633 10.633
2 M- 633

5492728229723

BKL

1. Sports Di Atlas 721157 2 720529 6 14 17.999 17.979
2 11-6/33

6 72 1157 252 1157

BKL

2 2820900 820900 1620010 1 1615337 7 4 17891 17891
M- 833

7 1820010 3720010

~~BAE~~ Sp. L

2 281 572 / 81 572 / 117 5800 / 117 5800 8 4 30.893 70.759 30.893
30.897 - 0.765

2 11/5800 29/5800

pkf (sp/scr)

1	29/5800	11/5800	653518	8	653518	9	4	93.190	726.887	93.190
8								93.193	-26.887	
9	653518	2953518								
	pkf (cp 1003)									
8	2953518	653518	90750	9	90750	10	4	38.601	+5.179	38.601
9										
10	90750	1890750								
	pkf (cp 1110)									
8	Sepati Si Atas	1120910	9	1120910	11	4	26.819	+1.869	26.819	
9								26.818	-1.819	
11	1120910	2920910								
	pkf (cp 11102)									
9	2920910	1120910	1053636	11	1053636	12	4	30.778	+1.223	30.778
11										
12	1053636	2853636								
	pkf (cp 1122)									
11	2853636	1053636	83937	12	83937	13	4	78.136	+7.070	78.136
12										
13	83937	1883937								
	pkf (cp 1151)									
11	Sepati Si Atas	889297	12	889297	19	4	39.256	+7.807	39.256	
12									-7.836	
19	889297	2889297								
	pkf (cp 1195)									
12	2889297	889297	1732997	19	1732997	15	4	73.156		73.156
19										
15	1732997	3532997								
	PL									

[illegible]

17 960909 2760909 2075006 18 2075006 10 4 28.950 28.950
 18
 10 23 2075006 275006

18 275006 2075006 1890750 10 1890750 9 Sila Rujak m/s 32 R 2
 10
 9 1890750 90750

Bering 10-9 Diacara 1890750

Sepatutnya Diacara 1890750

Tikarain Nil

Ambakutan Nil

10 90750 1890750 3095690 9 3095690 23 4 28.823 28.823
 9
 23 3095690 1295690
 pkt

29 1295690 3095690 3189329 23 3189329 29 4 31.755 31.755
 23
 29 3189329 1389329
 pkt


23 1389329 3189329 3329692 29 3329692 25 4 27.708 27.708
 29
 25 3329692 1529692
 pkt


29 1529692 3329692 75038 25 75038 28 4 28.877 28.877
 25
 26 75038 1875038
 pkt

DAERAH GUMBAR.
MUKIM HUKU KELANG.
78.0

7-20	62 5091	252.192	N
	62 5098	252.180	PO
	-7"	+0.02	

7-15	95 2397	206.081	N
	95 2959	206.105	PO
	-1 12"	-0.029	

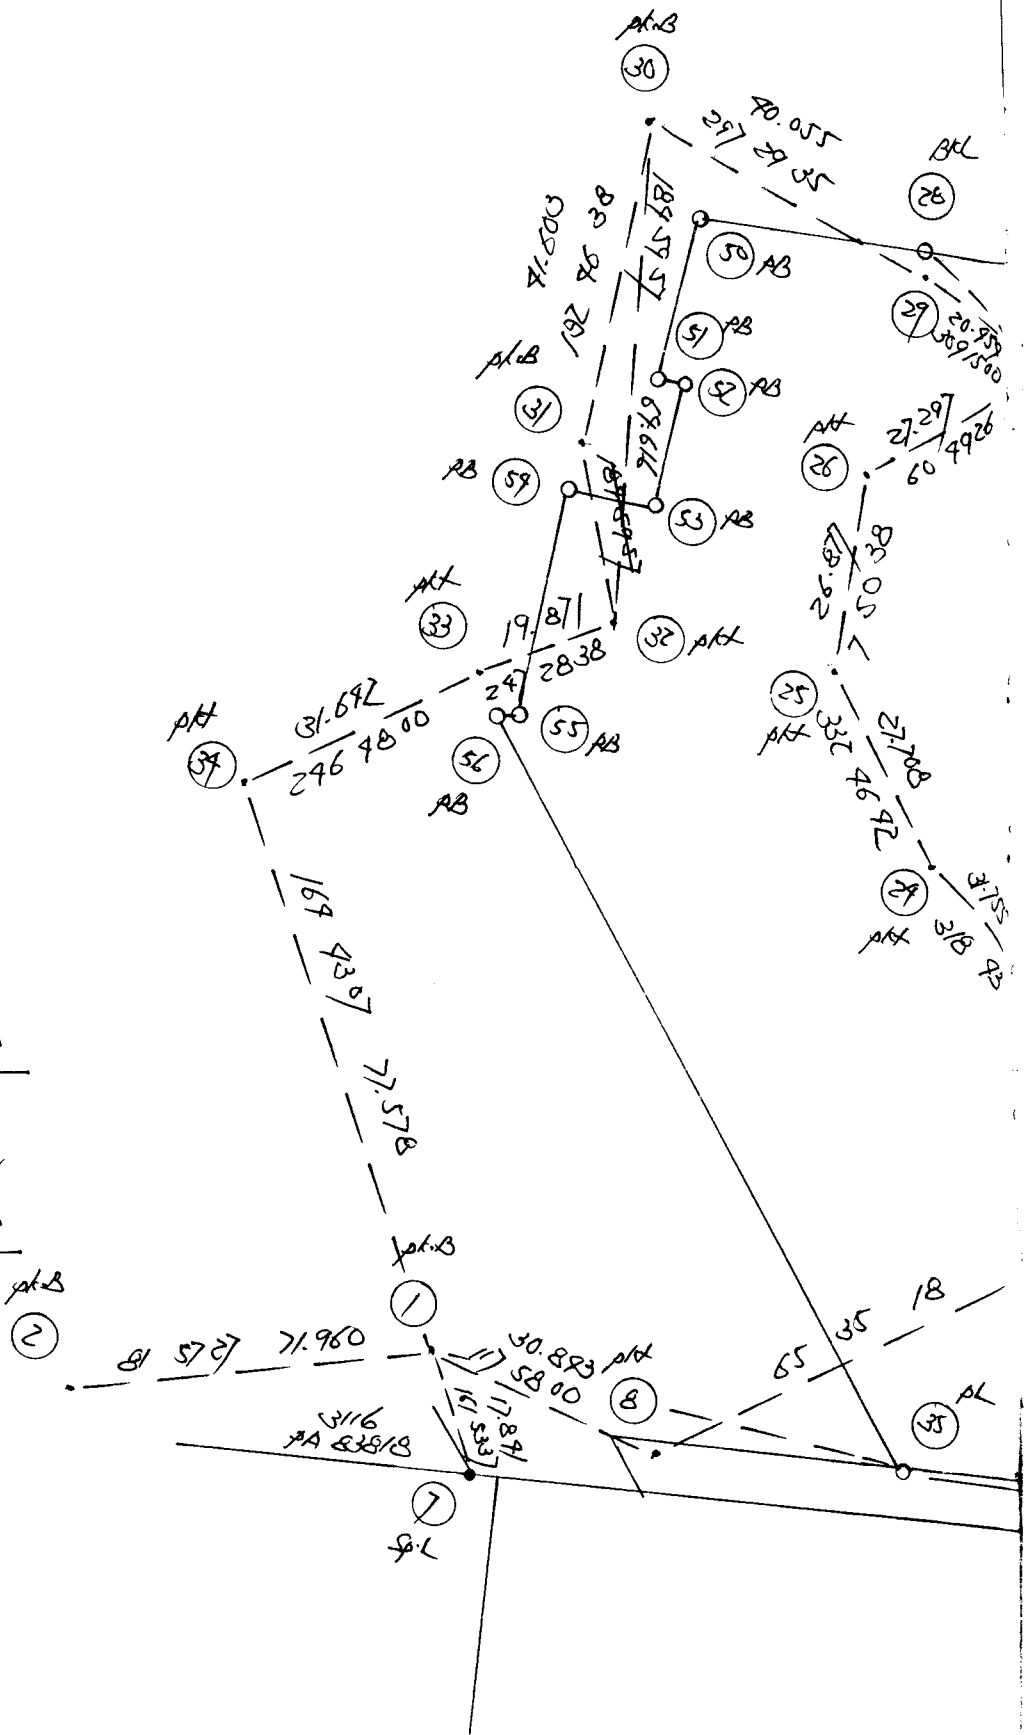

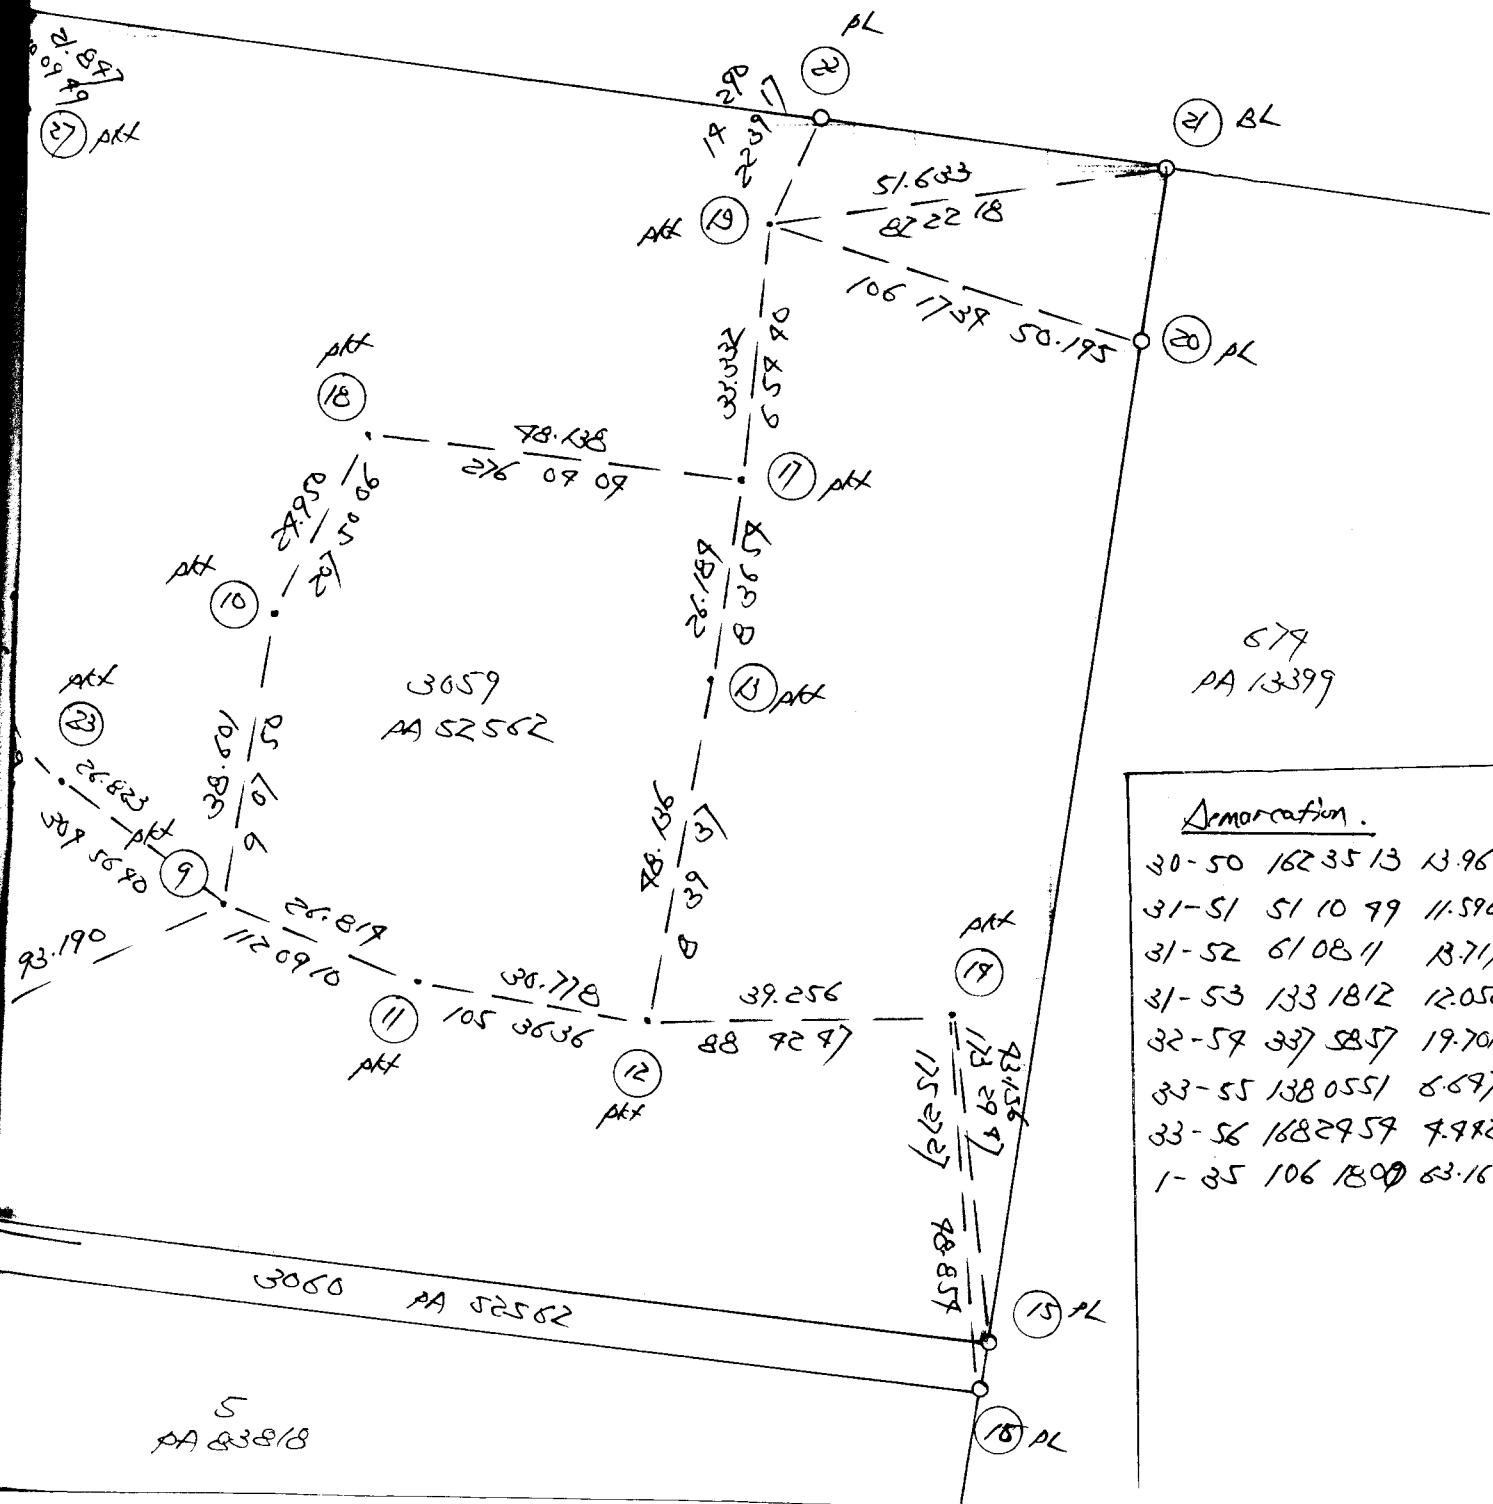

25	18/5038	7 50 38	60 9326	28	60 9326	27	4	27.297	27.297
26	27	60 9326	280 9926						
		pk							
26	280 9326	60 9926	310 0999	27	310 0999	28	4	21.897	21.897
27	28	310 0999	130 0999						
		BIL							
26	Sports Di Atlas	309/1500	27	309/1500	29	4	20.959	20.959	
27	29	309/1500	129/1500						
		pk							
27	129/1500	309/1500	297/2935	29	70.055	30	4	70.055	70.055
29			297/2935						
30	297/2935	117/2935							
		pk.B							
29	117/2935	297/2935	132 9638	30	132 9638	31	4	71.603	71.603
30	31	132 9638	12 9638						
		pk.B							
29	Sports Di Atlas	189 5957	30	189 5957	32	4	69.616	69.616	
30	32	189 5957	4 5957						
		pk							
30	4 5957	189 5957	297/2838	32	297/2838	33	4	19.871	19.871
32	33	297/2838	67 2838						
		pk							

32 672838 2972838 2967800 33 2967800 37 4 31.692 31.692
 33
 37 2967800 667800
 p.k.B
 33 667800 2967800 1697907 37 169⁷³7907 / 4 77.578 77.578
 37
 / 1697307 3797307
 37 3797307 1697307 2615727 / 215727 2 Sika Rijnk mk 31 R1
 2 2615727 815727 ^{Bering} Tontutup.
 37 Sepats & Atas 1061800 / 1061800 35 4 63.169 63.169
 /
 35 1061800 2861800
 PL

Penilik: JRS80515 Sri Ukay Tarikh: 28/06/2008

Stn. 1 Koordinat: U581 T6593 Selangor

T.R. 2 B.K.112 Ms.31


Waktu	Sasaran	Ufuk	Gelembong	Puguk		
	T.R.	262 04 00				
9 43	M.H.	64 16 45		55 47 27	Waktu purata	9 43 30
9 43	M.H.	63 35 57		55 38 49	Beza dari U.T. -	8 00 00
9 44	M.H.	243 33 08		304 30 08	U.T.	1 43 30
9 44	M.H.	244 09 45		304 35 28	Deklinasi	23 16 06
	T.R.	82 04 00				

	T.R.	262 04 00				
9 45	M.H.	64 08 07		55 15 37	Waktu purata	9 45 30
9 45	M.H.	63 28 26		55 12 11	Beza dari U.T. -	8 00 00
9 46	M.H.	243 25 58		304 55 25	U.T.	1 45 30
9 46	M.H.	244 03 05		305 00 09	Deklinasi	23 16 06
	T.R.	82 04 00				

	Set 1	Set 2
Sudut pugak	34 24 50	34 51 56
Pembetulan	- 0 01 10	- 0 01 09
Altitud	34 23 40	34 50 47
Jarak kutub	66 43 54	66 43 54
Latitud	3 10 46	3 10 46
Azimut M.H. yang dikira	63 48 14	63 40 40
Purata ke M.H.	63 53 54	63 46 24
Selisih:	- 0 05 40	- 0 05 44
Purata ke T.R.	262 04 00	262 04 00
Azimuth T.R. sebenar	261 58 20	261 58 16
Pembetulan aras	+ 0 00 00	+ 0 00 00
Tirusan	- 0 00 51	- 0 00 51
Bering grid T.R.	261 57 29	261 57 25

Purata bering grid T.R. 261 57 27

Tarikh *JRS 805/5* Aras
Sri ukay
 Daripada

Dibuat untuk 63
 Ke

Pandangan Belakang	Pandangan Antara	Pandangan Hadapan	Naik	Turun	Aras Yang Dilaras
1.003	(13.29)				59.660
	1.979	(9.85)			59.189
0.783	(2.57)	2.161	(7.09)		58.502
		1.666	(5.78)		57.619
1.786		3.827			
1.666					57.619
2.268	(7.99)	1.169	(3.87)		
0.184	(0.60)	0.528	(1.73)		
0.961	(1.51)	2.978	(9.11)		
0.136	(0.45)	3.200	(10.50)		
0.221	(0.73)	2.902	(9.52)		78.966
		2.812	(9.23)		
7.936		18.549			

Jarak	Catitan
78M F1/91	nail on top of culvert (Ayer Sunay)
F1	<i>Sri ukay.</i>
CP	
F2	
F2	
78M F1/91	nail on top of con drain, D. bawak
	<i>S/8 River, sebelah rumah Adai</i>
	<i>Sri ukay.</i>
T	

Tarikh Aras

Daripada

Dibuat untuk

Ke

Pandangan Belakang	Pandangan Antara	Pandangan Hadapan	Naik	Turun	Aras Yang Dilaras
1.037	(3.39)		(5.07)		78.966
1.515	(7.97)	1.576			
1.577	(5.11)	1.513	(7.98)		
1.600	(5.25)	1.519	(7.98)		
1.887	(6.19)	1.301	(7.22)		
1.769	(7.82)	0.959	(3.15)		
1.393	(7.71)	1.371	(7.50)		
1.650	(5.71)	1.352	(7.77)		50.17
		1.333	(7.37)		
1205'		10.87			

Jarak	Catitan
78M 1/4/12	
78	PO0016 84 Antena Berapa. 2809 m/s 16
	RC: 50.17
	BM 10096 Melawat Masjid.