

JRS 8057) Putra Perdana.

							18/10/08	
	Datim Danipada	75900	50	75900	51	4	79.730	79.730
	FB 10mg.		pkt.L		pkt.L			
51	75900	1895900	1892210	50	1892210	57	4	191.236
50								191.236
57	1892210	92210						
	pkt.L							
51	Seperti Di Atas	592302	50	592302	100	4	116.979	116.979
50								
100	592302	2392302						
	pkt.							
50	2392302	592302	1770522	100	1770522	101	4	180.000
100								180.000
101	1770522	3570522						
	pkt.							
100	3570522	1770522	2833330	101	2833330	102	4	97.919
101								97.919
102	2833330	833330						
	pkt.							
101	833330	2833330	2793335	102	2793335	103	4	131.176
102								131.176
103	2793335	973335						
	pkt.B (K50)							
101	Seperti Di Atas	2875299	102	2875299	57	4	90.957	90.957
102								
57	2875299	875299						

102 6/5299 24/5299 92210 57 92210 50 Sit Like m/w R.2

57

50 92210 1892210

102 973335 2773335 1887012 103 1887012 107 4 33.813

33.813


103

107 1887012 89012

pt B (Atlas Sump) FS)

Block Aging.

51-A	166 0998	22.659	HWP	102-Y	1 55 57	25.092	HWP
51-B	63 3599	10.525	HWP	102-Z	59 17 11	40.916	HWP
51-C	21 01 01	37.667	HWP				
100-D	306 5825	36.506	BAL	101-Z1	62 15 93	23.368	HWP
100-E	323 1809	28.089	HWP	101-Z2	109 13 93	19.507	HWP
100-F	35 9892	29.576	BAL	101-Z3	115 29 35	18.551	HWP
100-G	63 9959	57.563	HWP	14-Z9	239 08 00	18.783	HWP
100-H	99 3623	97.995	HWP				
100-I	87 9997	19.259	HWP	102-Z5	197 23 29	6.298	HWP
100-J	289 2293	19.782	BAL	102-Z6	219 26 92	5.553	HWP
100-K	296 3999	37.128	HWP				
100-L	259 5351	62.313	HWP				
57-M	29 0015	21.118	HWP				
57-N	29 9528	21.696	HWP				
57-O	15 39 02	99.911	HWP				
102-P	282 3193	92.972	HWP				
102-Q	279 5932	92.860	HWP				
102-R	309 9933	98.093	HWP				
102-S	333 9156	28.310	HWP				
102-T	298 0258	18.902	HWP				
102-U	295 2306	18.985	HWP				
102-V	281 2025	26.115	HWP				
102-W	251 1817	29.150	HWP				
102-X	255 2025	96.377	HWP				

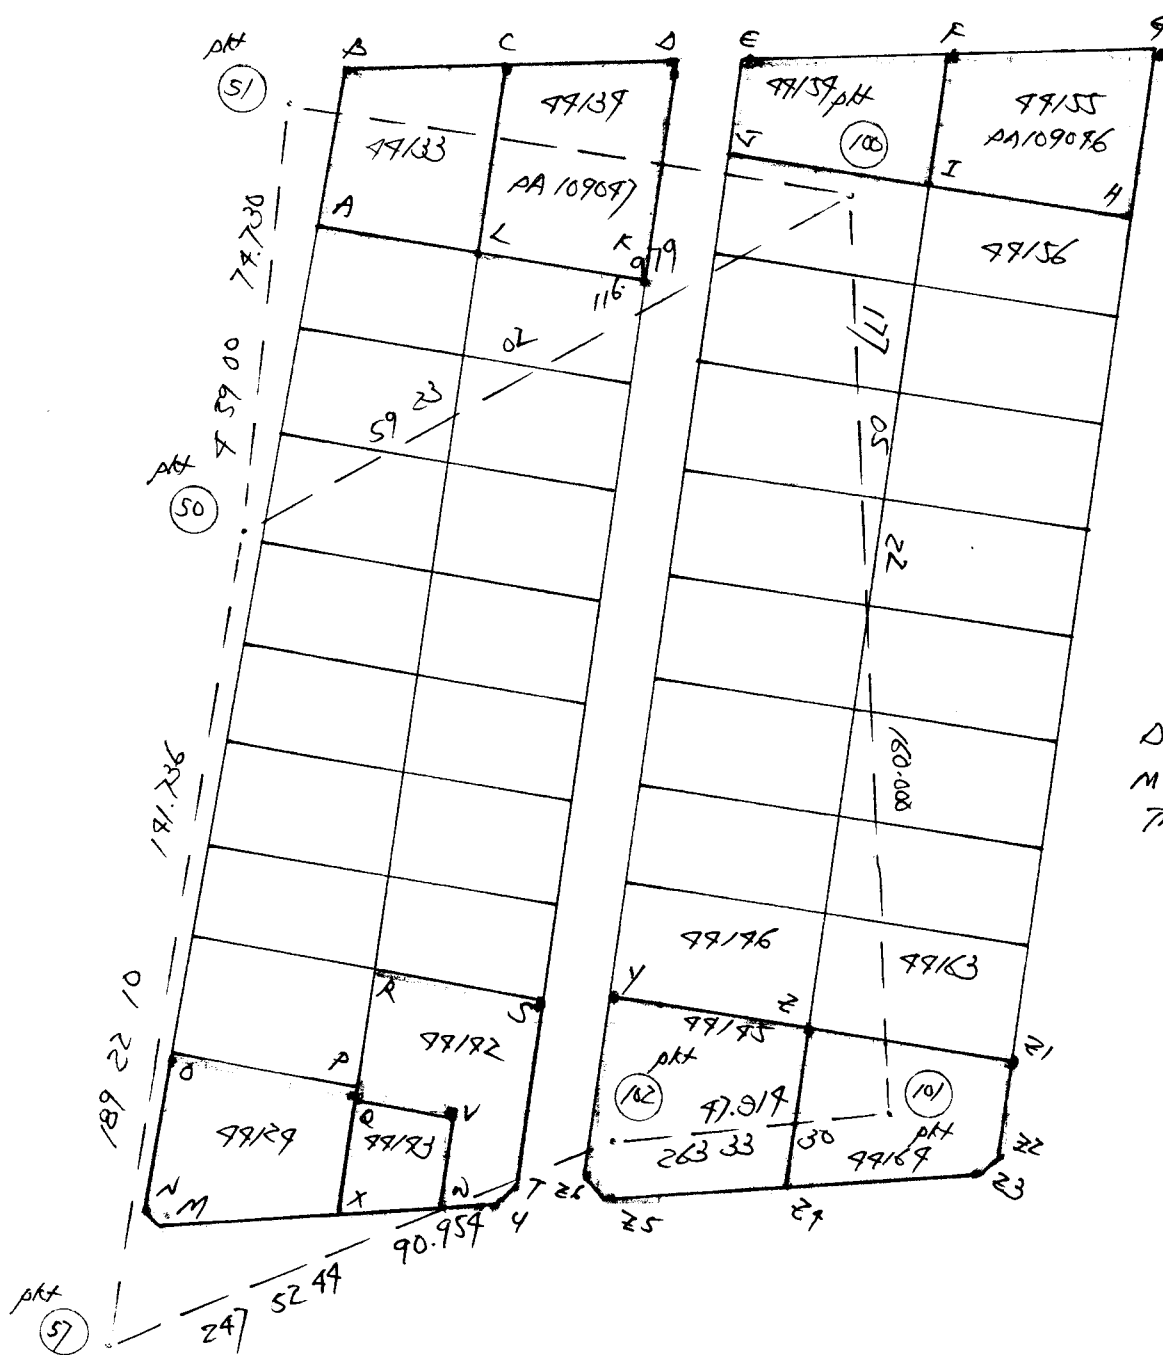

DAERAH JEPANG.
MYKIM JENSK/K
TANPA SKACA