

No. Fail

JRS 80613 414

Rajah di muka

[illegible]

Rajah di muka


Stesen	BEARING / SUDUT			Dari	GARISAN	Ke	Sudut Pukak	Jarak	Suhu	Jarak Antara Tumpang	Jarak Mukamat
	Penyilang Kiri	Penyilang Kanan	Purata	Stn.	Bearing Mukamat	Stn.	(±)				

E-10 190519 127.387 N
 190515 127.355 PD

 19" 0.008 -

2-11 17 50 89 157.588 N
17 50 87 157.588 PD

72" N.1/

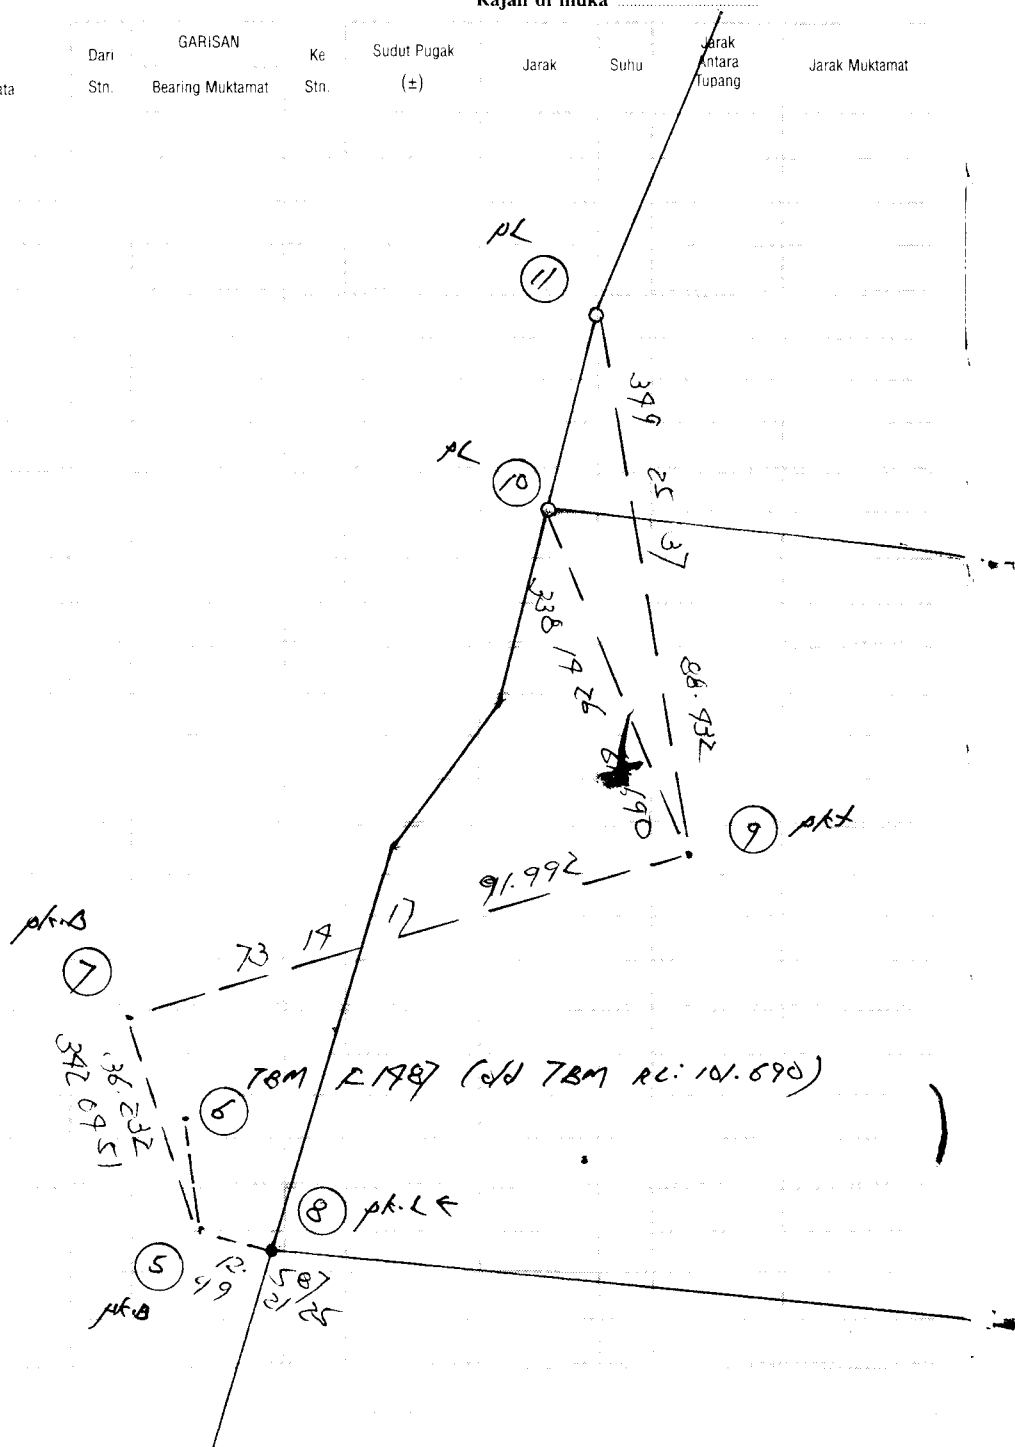

No. Fail

Rajah di muka

Stesen	BEARING / SUDUT		Dari Stn.	GARISAN Bearing Muktamat	Ke Stn.	Sudut Pukak (±)	Jarak	Suhu	Jarak Antara Tupang	Jarak Muktamat
	Penyilang Kiri	Penyilang Kanan								

DAERAH GOMBAK
MUKIM SETAPAK.

70A

41A

TANPA SKALA

1528
PA (55633)

1529
PA 7055

1530

Tarikh

14/01/2019

Aras

Dibuat untuk

42

Daripada

JRS 80683

Ke

SKEM BUSINESS CENTRE

Pandangan Belakang	Pandangan Antara	Pandangan Hadapan	Naik	Turun	Araas Yang Diaras	Jarak	Catitan
1.208	(3.96)				101.690	78m x 148	(sd 78m - on top of Bus stop).
2.866	(8.79)	1.207 (3.96)			101.691	RS	RC: 101.69 BM 80685 (old 78m)
		0.683 (2.11)			103.719		
1.118	(3.67)				101.690	78m x 148	
		1.063 (3.49)			101.745	17	