

Rajah di muka

Stesen	BEARING / SUDUT	Dari	GARISAN	Ke	Sudut Pukak	Jarak	Suhu	Jarak Antara	Jarak Mukamat
	Penyilang Kiri	Penyilang Kanan	Purata	Stn.	Bearing Mukamat	Stn.	(±)	Tupang	
	Dataran Daripada	177 00 00	2	171 09 08	1	4	277.957	1/4/07	277.957
		M-2 55 52	pkf		BKL				
2	1 177 00 00	357 00 00	187 21 20	2	189 25 28	3	4	313.733	313.733
		M-2 55 52							
3	187 21 20	7 21 20							
		BKL							
2	1 Seperti Di Atas	72 27 38	2	69 31 76	7	4	195.076		195.076
		M-2 55 52					195.076		
7	72 27 38	252 27 38							
		pkf							
2	1 Seperti Di Atas	255 78 25	2	252 50 33	5	4	166.618		166.618
		M-2 55 52							
5	255 78 25	75 76 25							
		Buku Ajar							
2	1 Seperti Di Atas	237 72 13	2	231 76 21	6	4	202.732		202.732
		M-2 55 52							
6	237 72 13	57 72 13							
		Buku Ajar							
2	1 Seperti Di Atas	209 06 07	2	206 10 12	7	4	190.307		190.307
		M-2 55 52							
7	209 06 07	29 06 07							
		Buku Ajar							
2	1 Seperti Di Atas	206 32 06	2	203 36 17	8	4	137.397		137.397
		M-2 55 52					70.033		137.361
8	206 32 06	26 32 06							
		BKL							

No. Fail


Rajah di muka

[illegible]

137761
36
203
BKL
(8)

No. Fail

Rajah di muka

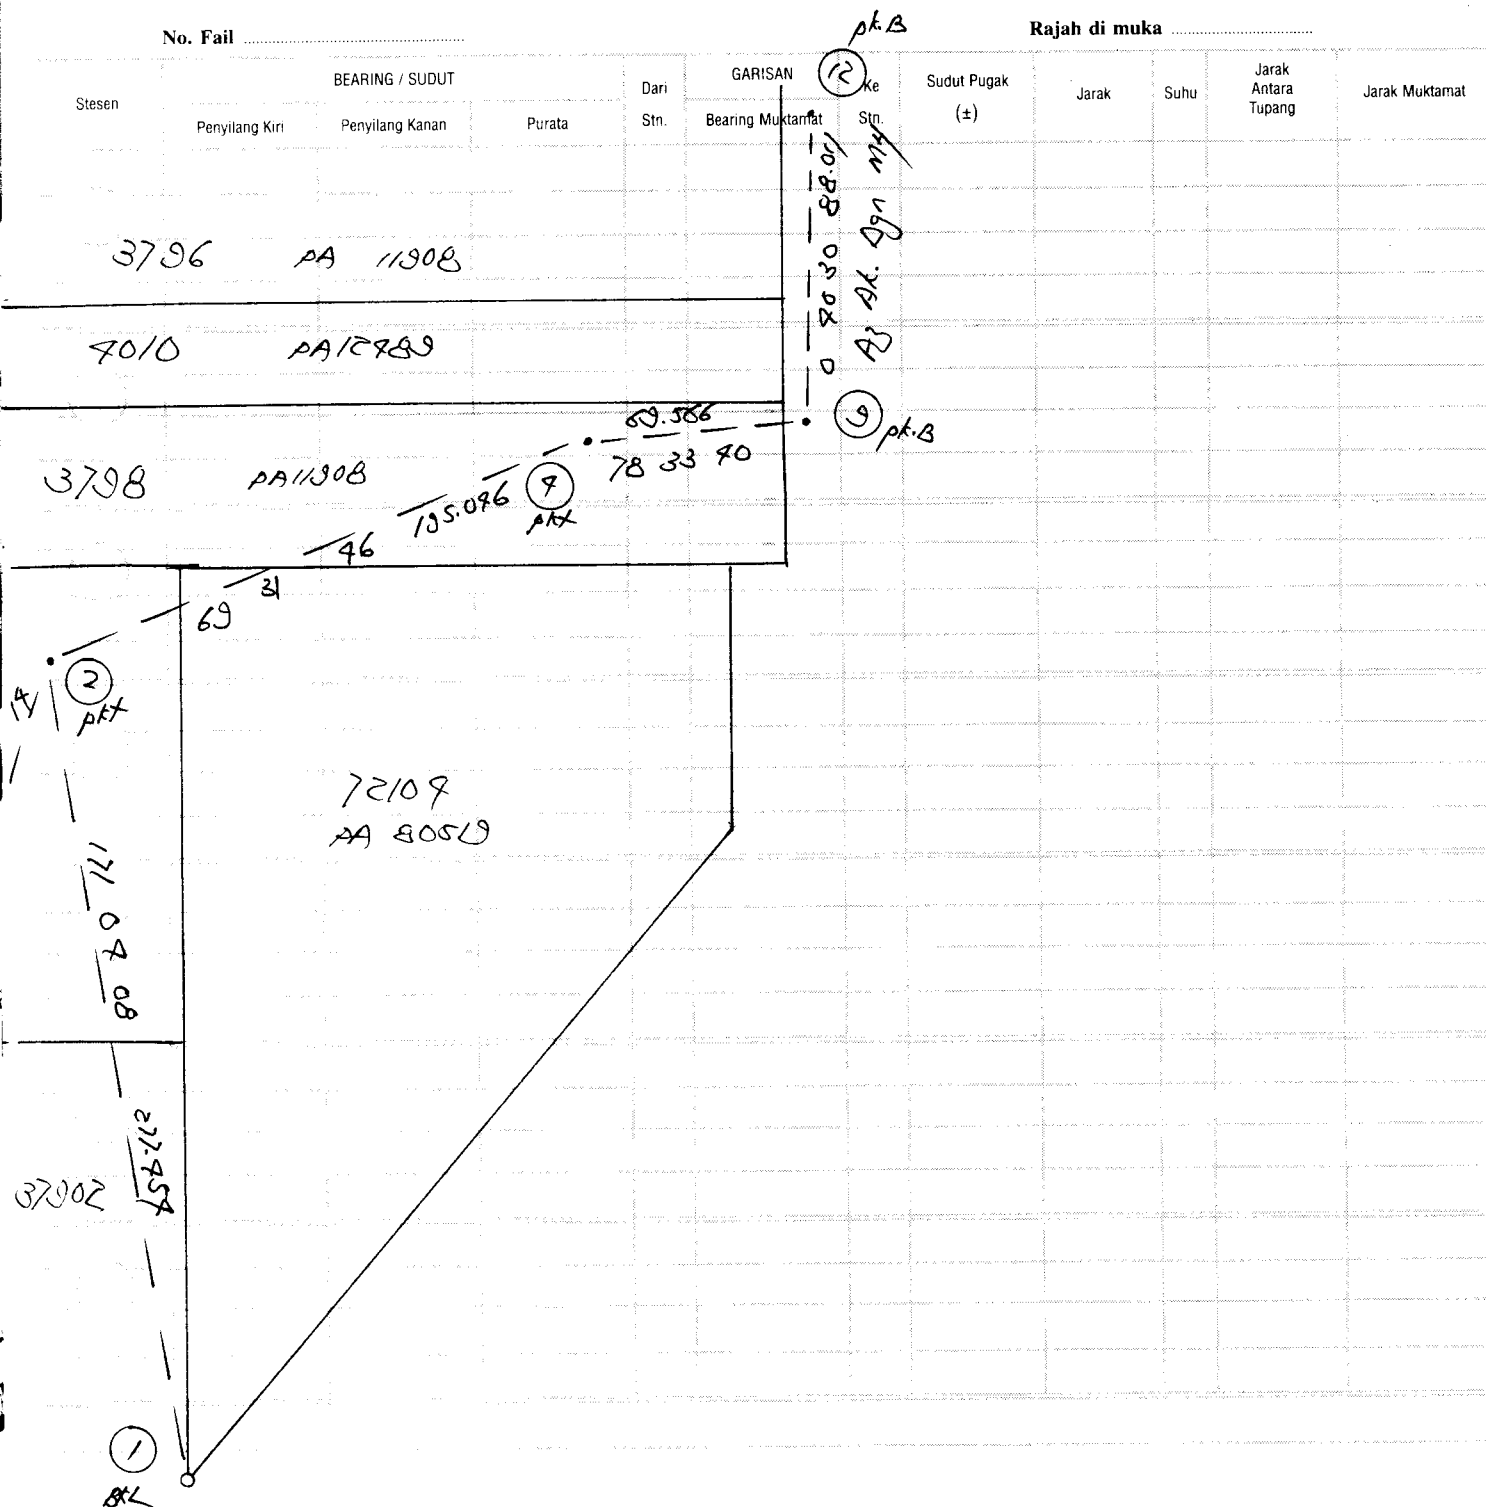

CERAPAN MATAHARI BAGI AZIMUT

 Penilik KOO CHEE YONG. Hari Tarikh 1/11/07 Bulan Tahun

 Stesen 82 T.R. 129 B.K. Ms. Tiodolait (Jenis) I Bah. Aras Ufuk - a

Formula:

$$\text{Kosain AZIMUT} = \frac{\text{Kos P} - \text{Sain } \phi \text{ Sain } \alpha}{\text{Kos } \phi \text{ Kos } \alpha}$$

$$\text{Pembetulan Aras} = \frac{\alpha}{8} (\pm R - \pm L) \text{ tenjen } \alpha$$

Waktu		Ufuk			Gelem-bong		Pugak			Tilikan ①	Bila waktu jam tangan tidak dalam lingkungan 3 menit daripada waktu pawai Hitung waktu umum.			W.U. - 12 ^J + W.T.K. - G. Bujur - E		
J	m	P.Ki	T.R		Ki	Ka					J	m		12 ^J	00 ^m	
				183 00 00												
			⊕	110 26 47			62 13 20									
			⊖	109 51 18			62 09 13									
		P.Ka	⊖	289 52 50			297 57 42									
			⊕	290 30 39			298 02 27									
Purata ①		T.R														
J	m															
900							27 59 28									
		Purata Ke matahari		110 10 29			1 31									
		Purata Ke TR					27 52 53									
J	m	P.Ki	T.R													
			⊕	111 05 09			59 33 39									
			⊖	110 29 21			59 28 37									
		P.Ka	⊖	290 30 33			300 36 26									
			⊕	291 09 17			300 41 25									
Purata ②		T.R														
J	m															
94							30 33 55									
		Purata Ke matahari		110 48 35			1 21									
		Purata Ke TR					30 32 38									
Kordinat Origin U/S	55961	m	Kordinat Origin T/B	27759	m	Purata Bg. Gerid T.R.	180 40 30									
Stesen U/S	19238	m	Stesen T/B	20379	m	Ditilik oleh	1/11/07									
Jumlah/Sel.	75699	m	Jumlah/Sel.	1385	m	Dihitung oleh										
Jumlah/Sel. × 0.03256 ±	0 41 05		Sel. G. Bujur - $\frac{\text{Jum.}}{\text{Sel.}} \times 0.03246 \pm$	45		Tarikh										
G. Lintang Origin U	3 40 49		Sel. G. Bujur × Sain G. Lintang -													
G. Lintang Stesen U	2 59 49		T (-) / B (+) Tirisan -	2												

 P.Ki - Penyilang Kiri
 P.Ka - Penyilang Kanan

 T.R. - Tanda Rujuk
 Sel - Selisih

 W.U. - Waktu Umum
 W.T.K. - Waktu Tempatan Ketara


Tarikh *27/11/2017* *KESAS.* Aras

Dibuat untuk *9/12/17 49*

Daripada *54/162* *579*

Ke *1161* *1003*

Pandangan Belakang	Pandangan Antara	Pandangan Hadapan	Naik	Turun	Aras Yang Dilaras	Jarak	Catitan
0.625 (205)	1.312 (431)				6.859	78m H21	RC: 6.859m - 8m 80653 (RC: 8.53)
1.088 (335)	0.555 (1.63)				6.112	78m H295	
1.278 (318)	0.555 (1.63)				6.363	1.9 11299	
1.492 (492)	1.492 (492)				6.779	78m 11296 11299	my 11299
1.709	2.007				6.561	1.9	
1.383 (7.59)	1.386 (7.59)				6.689	78m H296	STH typ. site off
1.288 (7.59)	1.386 (7.59)				6.686	9m 1298	
1.582 (5.19)	1.501 (7.60)				6.573	9m 1165	
1.758 (7.78)	1.768 (7.82)				6.687	9m 1003	
1.584 (5.20)	1.584 (5.20)				6.581	1.9	
5.839	5.839						

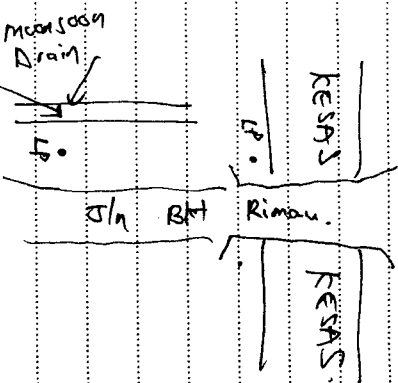

78m H295 1161 mcm 1003