
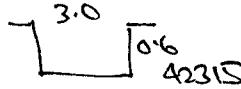
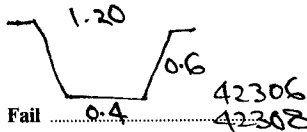
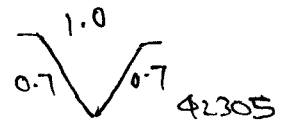
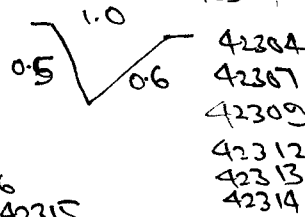
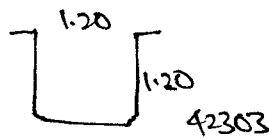
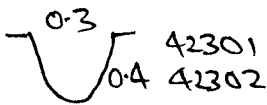
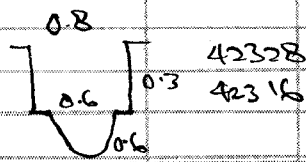
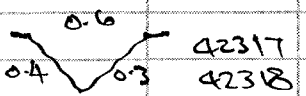
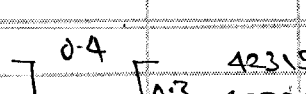
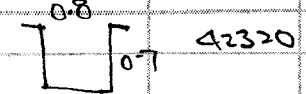
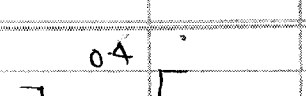


21

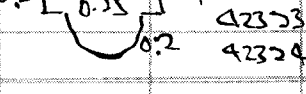

No. Fail 0.4

Rajah di muka

| Stesen | BEARING / SUDUT                                                                     |                 |          | Dari Stn. | GARISAN         |      | Ke Stn. | Sudut Pukak (±) | Jarak  | Suhu | Jarak Antara Tupang | Jarak Mukamat |
|--------|-------------------------------------------------------------------------------------|-----------------|----------|-----------|-----------------|------|---------|-----------------|--------|------|---------------------|---------------|
|        | Penyilang Kiri                                                                      | Penyilang Kanan | Purata   |           | Bearing Mukamat |      |         |                 |        |      |                     |               |
| 2      | 165 00 00                                                                           | 345 00 00       | 66 56 05 | 1         | 66 25 00        | 16   | H       | 89.030          | 73.959 |      | 89.030              |               |
| 1      |                                                                                     |                 | M-31 05  | 1595      |                 | 1655 |         |                 |        |      |                     |               |
| 16     | 66 56 05                                                                            | 246 56 05       |          |           |                 |      |         |                 |        |      |                     |               |
| RT     |                                                                                     |                 | 66 25 00 |           |                 |      |         |                 |        |      | RI. 102.530         |               |
|        |    |                 |          |           |                 |      |         |                 |        |      |                     |               |
|        |  |                 |          |           |                 |      |         |                 |        |      |                     |               |
42201 } ED = 1.0 m  
42202  
42203