
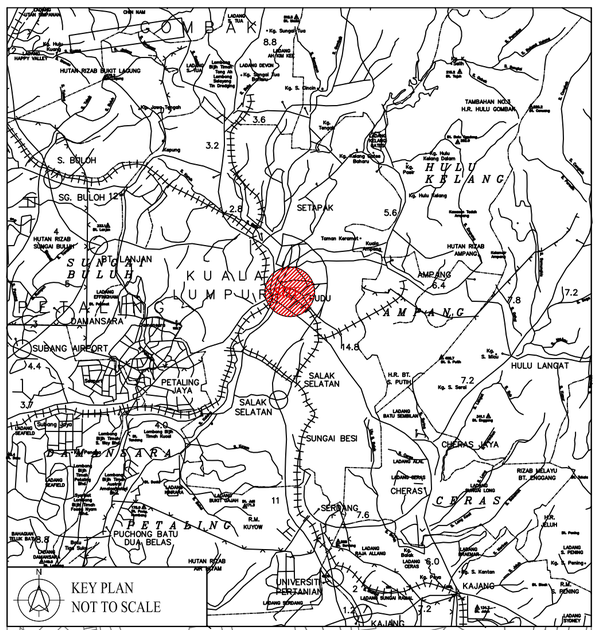


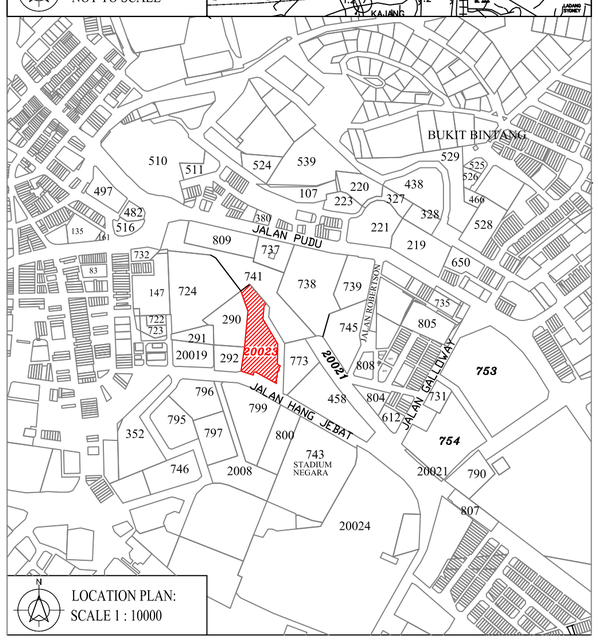

ENCROACHMENT AREA	
AREA A	382.387 m2
AREA B	138.853 m2
AREA C	385.467 m2

PROPOSED FENCING 131meter

724
PA100339

290
PA20819

292
PA20819

20023
PA1110377
12187m

741
PA108275

773
PA106684

799
PA113056

458
PA27695

N

SCALE 1 : 1000

A
382.387 m2

B
138.853 m2

C
385.467 m2

Dewan
Tandas
Building
Laundry Extension
Co-Living Hostel
Annex
Vocational Training Opportunity Centre (VTOC)
Office & Boutique Hostel
Microhouse
Shelter
RC
P/E
MRT
WT
Proposed Fence
Cable Line (Estimate)
Cable Direction
Jalan Hang Jebat

TAJUK PELAN :

UKURAN BUTIRAN DAN TOPOGRAFI
DI ATAS LOT 20023
SEKSYEN 56
BANDAR KUALA LUMPUR
WILAYAH PERSEKUTUAN KUALA LUMPUR

NOTA :

1. SEMUA UKURAN ADALAH DALAM UNIT METER.
2. SEMUA BERING, JARAK DAN KELUASAN YANG DITUNJUKKAN ADALAH BERDASARKAN KEPADA PA 1110377
3. ARAS LARAS ADALAH BERDASARKAN BM W5008 (RL:32.376m). 'Di bulatan berhampiran Jabatan Kebudayan dan Kesenian'

PETUNJUK :

WPL	WATER PIPELINE	EB	ELECTRIC BOX		CHAIN LINK FENCE
EP	ELECTRIC POST	SB	SIGN BOARD		WOODEN FENCE
LP	LAMP POST	ST	MANHOLE SEPTIC TANK		FENCE WALL
RS	ROAD SIGN	IWK	MANHOLE IWK		FOOTPATH
TP	TELEPHONE POLE	MHT	MANHOLE TELEKOM		ROOF
HY	HYDRANT	MAXIS	MANHOLE MAXIS		GATE
JBAV	JBA VALVE	MGAS	MANHOLE GAS		GUARD HOUSE
JBA	JBA MARKER	JBA	MANHOLE JBA		REFUSE CHAMBER
Gas	GAS MARKER	TNB	MANHOLE TNB		PENCAWANG ELEKTRIK
TNB	TNB MARKER		TREE		

DIUKUR OLEH : FOO 01 AUG 2023
DILUKIS OLEH : YEAP 03 AUG 2023
DISEMAK OLEH : FOO

JURUKUR TANAH BERLESEN:

NO. PELAN : FOO / KL / 419 / A / TP1