

SEL 382 Bkt Armai

19/7/07

Datum	Junipade	306 8013	2	306 8013	1	4	32.236		32.236
DA	112277				BL				
2-3	17 17 73		2	17 17 73	3	4	20.610	pt.L	20.610
2-7	172 2711		2	172 2711	7	4	87.908	BL	87.908
1	306 8013	128 8013	73 3920	2	73 3920	5	4	108.750	108.750
2					A3 Ak.				
5	73 3920	223 3920			891 MH				
	pt.B								
2	223 3920	73 3920	272 2928	5	272 2928	6	4	83.539	83.539
5									
6	272 2928	62 2928							
	pt.B								
2	Sports & Aka	170 0603	5	170 0603	7	4	98.525		98.525
5									
7	170 0603	350 0603							
	ptt								
5-8	329 2917		5	329 2917	8	4	51.196	BL	51.196
5-9	120 5208		5	120 5208	9	4	23.998	PL	23.998
5	350 0603	170 0603	167 5900	7	167 5900	10	4	88.151	88.151
7									
10	167 5900	387 5900							
	ptt								

7 37/5900 16/5900 23 79 7/ 10 23 79 7/ 11 4 7.05/ 7.05/
 10
 11 23 79 7/ 203 79 7/
 BKL
 7 Seperti Di Atas 2625809 10 2625809 12 4 71.903 71.903
 10
 12 2625809 825809
 10 825809 2625809 2852800 12 2852800 7 4 27.780 27.780
 12
 7 2852800 1052800
 12 1052800 2852800 352271/ 7 352271/ 2 4 51/4 Ghit m/s 33 22.
 7
 2 352271/ 172271/

Bring
 Tertutup


Bring 7.2 Di baca 352 271/
 Sepatutnya Di baca 352 271/

 Tilaiian Nil/
 Pembetulan Nil/

7-9	28 93 21	175.059 N
	28 93 21	175.053 P0
	Ni/	+0.00/

7-11	86 32 03	96.569 N
	86 32 15	96.528 P0
	-12"	+0.036

DAERAH UKU LANGAT
MUKIM CHERAS
95-C
TANPA SKALA

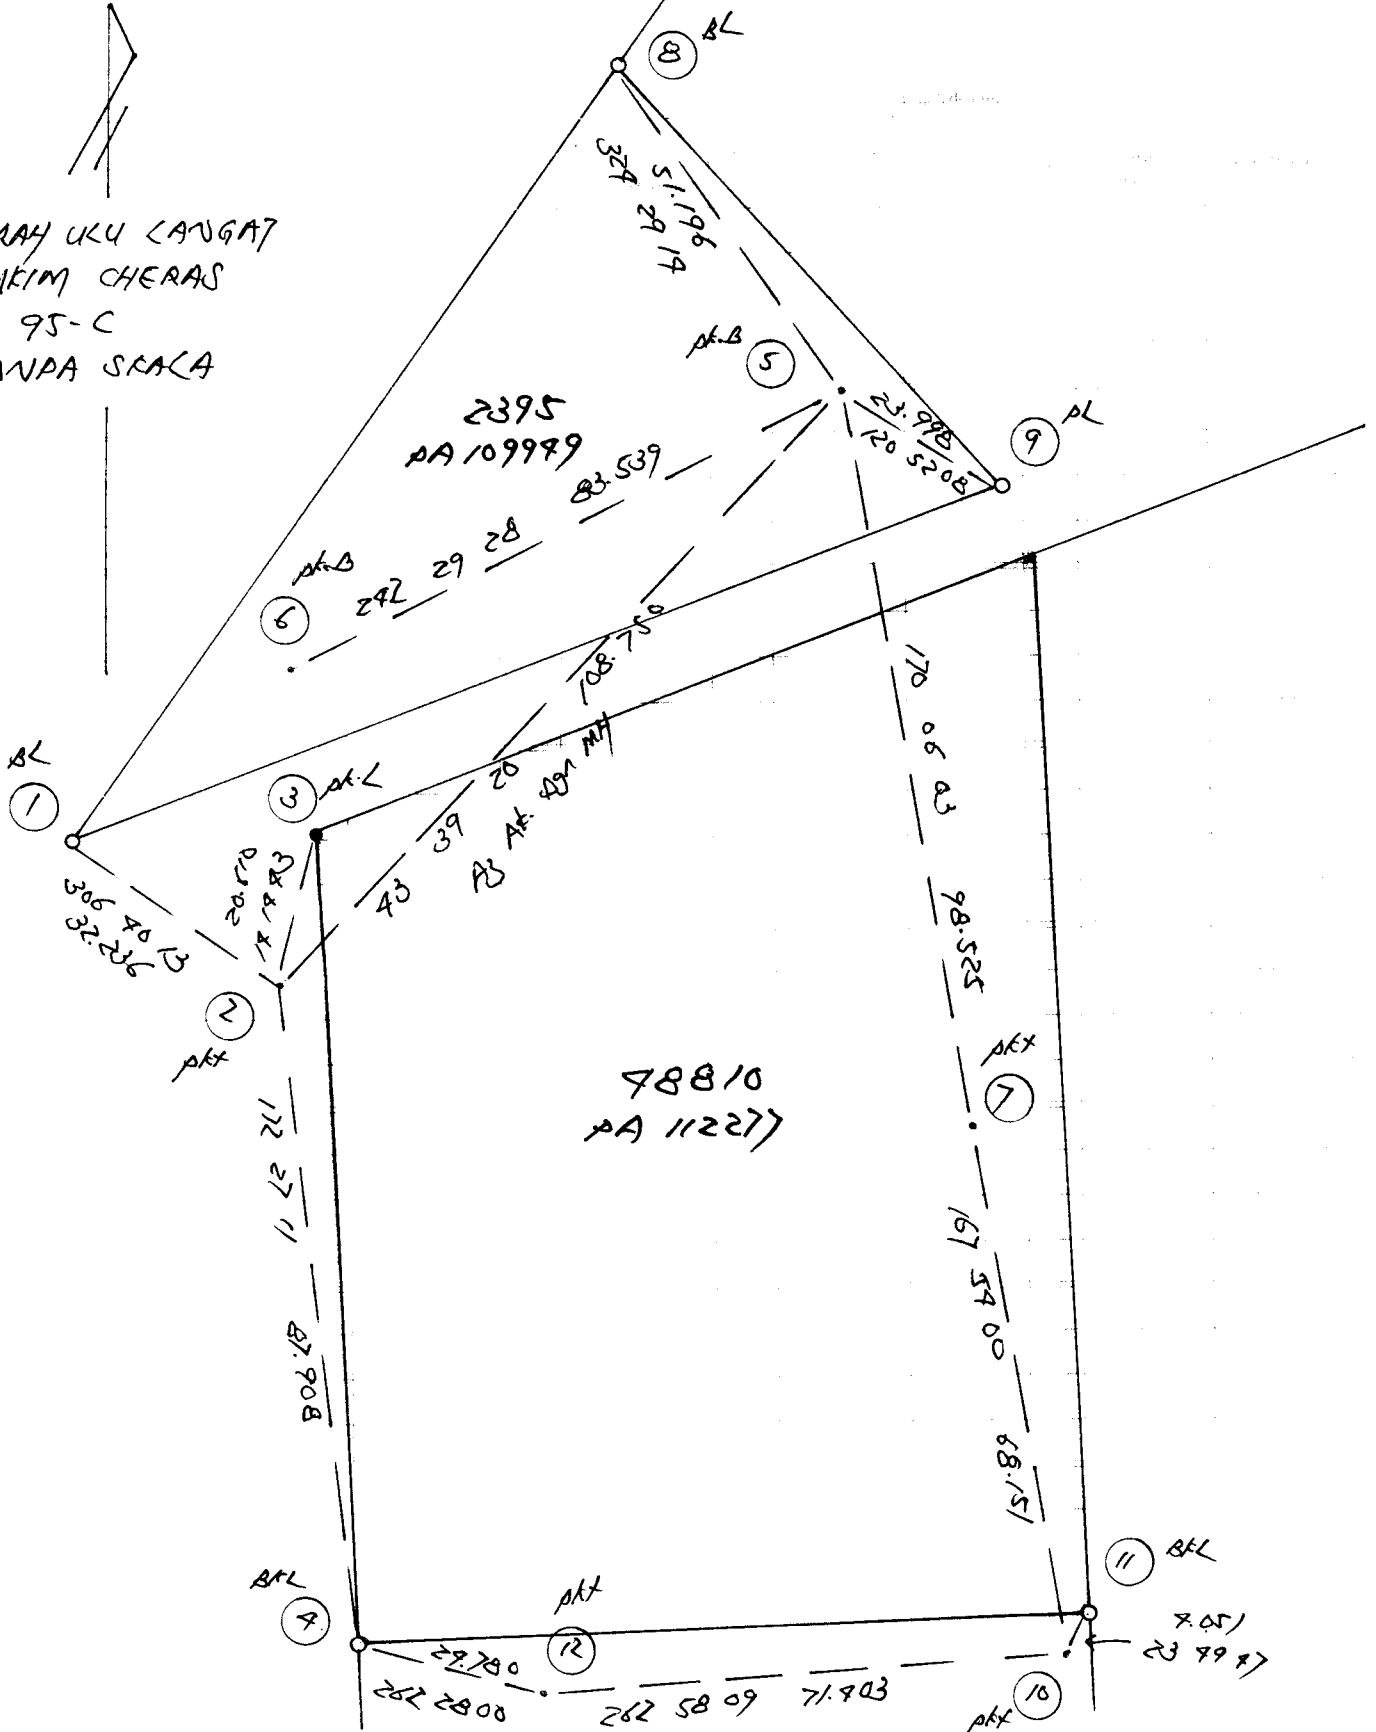

Penilik: SEL362 Bkt Permai Tarikh: 13/07/2009

Stn. 2 Koordinat: S12666 T11521 Selangor

T.R. 6 B.K. Ms.

Tiodolit Satu bah. aras ufuk:

Waktu	Sasaran	Ufuk	Gelembong	Puguk		
	T.R.	40 31 33				
8 55	M.H.	64 41 13		66 55 50	Waktu purata	8 55 30
8 55	M.H.	64 06 12		66 49 01	Beza dari U.T. -	8 00 00
8 56	M.H.	244 04 50		293 19 45	U.T.	0 55 30
8 56	M.H.	244 38 14		293 25 11	Deklinasi	21 49 55
	T.R.	220 31 33				

	T.R.	40 31 33				
8 57	M.H.	64 37 43		66 25 16	Waktu purata	8 57 30
8 57	M.H.	64 02 32		66 19 39	Beza dari U.T. -	8 00 00
8 58	M.H.	244 01 15		293 48 50	U.T.	0 57 30
8 58	M.H.	244 35 04		293 53 18	Deklinasi	21 49 54
	T.R.	220 31 33				

	Set 1	Set 2
Sudut pugak	23 15 01	23 44 18
Pembetulan	- 0 01 55	- 0 01 53
Altitud	23 13 06	23 42 25
Jarak kutub	68 10 05	68 10 06
Isotrud	3 03 35	3 03 35
Azimuth M.H. yang dikira	67 31 24	67 27 51
Purata ke M.H.	64 22 37	64 19 09
Selisih:	3 08 47	3 08 42
Purata ke T.R.	40 31 33	40 31 33
Azimuth T.R. sebenar	43 40 20	43 40 15
Pembetulan aras	+ 0 00 00	+ 0 00 00
Tirusan	- 0 00 58	- 0 00 58
Bering grid T.R.	43 39 22	43 39 17

Purata bering grid T.R. 43 39 20

Tarikh

14

Daripada

Ke

Dibuat untuk

Set 362 Bkt Permai

Long

Aras

Pandangan Belakang	Pandangan Antara	Pandangan Hadapan	Naik	Turun	Aras Yang Dilaras	Jarak	Catitan
2.109	(6.92)	(5.52)			72.983	78M PL	78M 2 RC: 72.983m
2.964	1.682	(5.52)			72.910	78M 90 ft ki	
2.853	(9.72)	0.263	(0.66)		74.329	78M F5	plan 174/06/sec/03/01
	2.398	(1.71)			74.985	90	
3.864	(12.65)	0.796	(2.61)		76.997	97 F6	78M F1598 road on top of drain.
	2.371	(1.78)			77.990	F2	
		0.758	(2.99)		79.603		
8.937		1.67					