

SEL 376 SS2 Ivan - Re-fraverse.

Datum Daripada		2	121 7825	1	4	35.827		35.827
			Aj Ak.					
			Ag 11/4					
1	121 7825	30/7825	273 59 78	2	273	50	4	112.157
2	93	223	93	273	59 78			112.157
50	273 59 78	223 59 78						
		pt.B						
1	Septi Di Atas	268 59/7	2	268 59/7	51	4	179.167	179.167
2								
51	268 59/7	88 59/7						
		pt.B						
2	88 59/7	268 59/7	3 25/7	51	3 25/7	52	4	63.173
51								63.173
52	3 25/7	183 25/7						
		pt.B						
51-53	108 7822		51	108 7822	53	4	13.933	13.933
52-59	376 5851		52	376 5851	59	4	17.365	17.365
52-55	336 2826		52	336 2826	55	4	9.139	9.139
51	183 25/7	3 25/7	92 1137	52	92 1137	56	4	68.290
52								68.290
56	92 1137	272 1137						
		pt.B						
56-57	78 0852		56	78 0852	57	4	6.159	6.159
56-58	0 39 08		56	0 39 08	58	4	8.768	8.768
56-59	0 55 05		56	0 55 05	59	4	28.769	28.769
56-60	306 3752		56	306 3752	60	4	15.060	15.060
56-61	206 9021		56	206 9021	61	4	8.859	8.859
56-62	119 5825		56	119 5825	62	4	16.532	16.532

52 272 1137 92 1137 92 1057 56 92 1057 63 4 197.066 197.066

56

63 92 1057 272 1057
pt.B

63-64 2553752 75 3752

63 2553752 69 * 4

15.526

pt.L ←

15.526

63-65 281 5117

63 281 5117 65 4

21.990

pt.L ←

21.990

63-66 357 2003

63 357 2003 66 4

8.073

pt.L ←

8.073

56 272 1057 92 1057 90 1655 63 90 1655 67 4 57.201

63

57.201

67 90 1655 270 1655
pt.B

67-68 281 5650

67 281 5650 68 4

7.105

pt.L ←

7.105

67-69 378 5798

67 378 5798 69 4

7.597

pt.L ←

7.597

63 270 1655 90 1655 70 1703 67 70 1703 70 4 77.007

67

77.007

70 70 1703 220 1703
pt.B

63 ~~Santi Di Atlas~~ 191 5317 67 191 5317 71 4 15.517

67 70

70

15.517

71 191 5317 11 5317
pt.B

67 220 1703 70 1703 133 0512 70 133 0512 72 4 86.598

71 70

86.598

72 133 0512 313 0512
pt.B

70 313 0512 133 0512 199 1605 72 199 1605 73 4 71.303 71.303
 72
 73 199 1605 19 1605
 pt.B
 72 19 1605 199 1605 289 2137 73 289 2137 50 4 136.972 136.972
 73
 50 289 2137 89 2137
 73 89 2137 289 2137 301 1710 50 301 1710 74 4 15.961 15.961
 50
 74 301 1710 121 1710
 pt.L &
 73 Seperti Di Atas 273 5998 50 273 5998 2 Sika Liket m/s 21 R2
 50
 2 273 5998 93 5998
 Bring
 Ter-tutup

Bring 50-2 Dibaca 273 5998
 Sepertinya Dibaca 273 5998



99


[illegible]

67-59 269 52 02 293.889 N
 289 59 53 293.883 10

 713 097 40.006

69-71 75 26 13 96.538 N
 75 26 16 96.595 10

 72577 -0.007

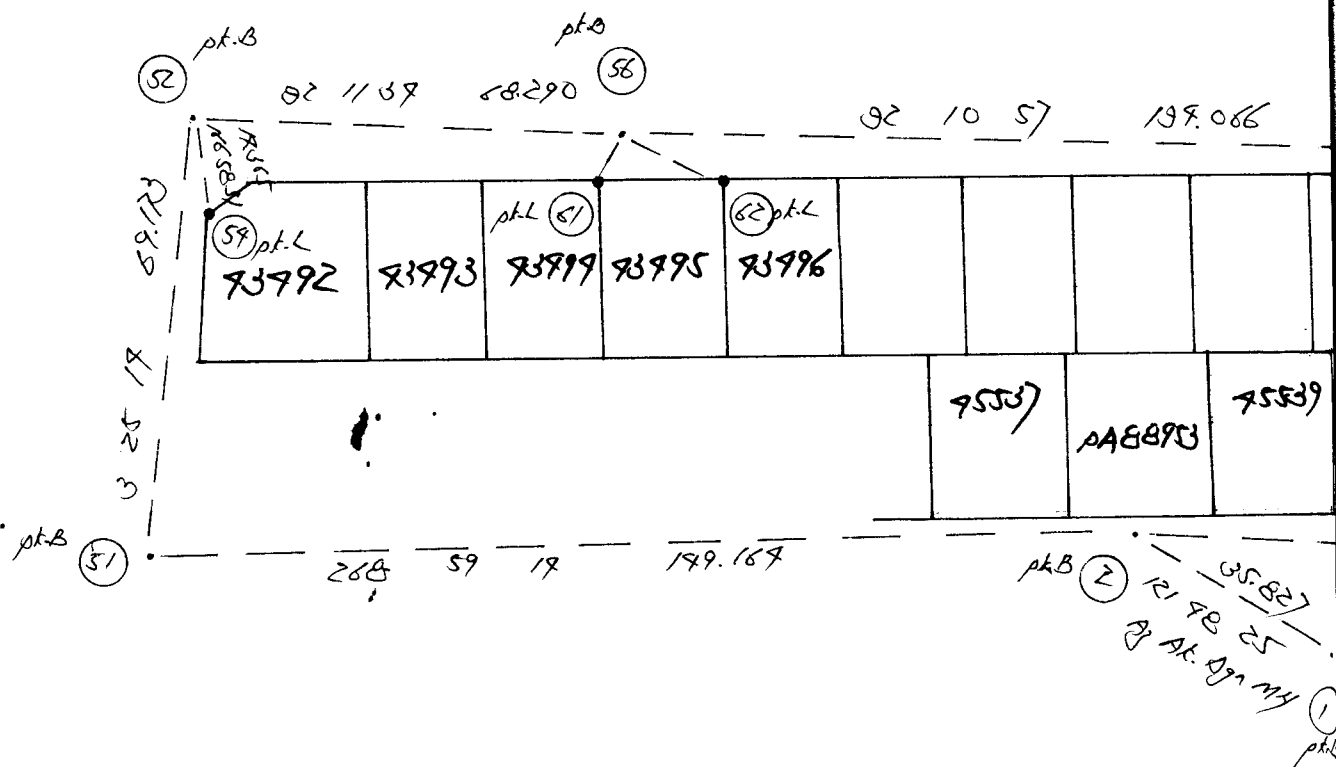

DAERAH DETAKUNG.
 BANJAR DETAKUNG JAYA
 85 C
 TANPA PRACA.

