

[illegible]

Stesen	BEARING / SUDUT			Dari Stn.	GARISAN	Ke Stn.	Sudut Pukak (±)	Jarak	Suhu	Jarak Antara Tupang	Jarak Muklumat
	Penyilang Kiri	Penyilang Kanan	Purata		Bearing Muklumat						
22	132 33 37	132 33 37	132 33 37	22	132 31 28	23	111 92	26.975			26.975
23	132 33 37	132 33 37	132 33 37	23	119 19 20	29	4	61.383			61.383
29	179 16 28	179 16 28	179 16 28	29	225 42 56	25	91 95	63.805			63.805
25	225 45 03	225 45 03	225 45 03	25	318 42 13	26	92 29	13.000			13.000
26	318 42 13	318 42 13	318 42 13	26	323 22 42	27	81 03	10.109			10.109
27	323 22 42	323 22 42	323 22 42	27	300 46 19	28	85 50	78.305			78.305
28	300 46 19	300 46 19	300 46 19	28	317 15 26	29	90 20	13.558			13.558
29	317 15 26	317 15 26	317 15 26	29							

Rajah di muka

[illegible]

Rajah di muka 1

Stesen	BEARING / SUDUT			Dari Stn.	GARISAN	Ke Stn.	Sudut Pukak (±)	Jarak	Suhu	Jarak Antara Tumpang	Jarak Mukamat
	Penyilang Kiri	Penyilang Kanan	Purata		Bearing Mukamat						
279	279	279	279	6	301 08 16	33	98 29	53.919	13/12/05		53.919
6	33	301 08 10	121 08 00					53.919			
6	121 08 10	301 08 10	303 30 09	33	303 30 13	39	78 28	30.227			30.227
33	39	303 30 09	123 30 09					30.228			
33	123 30 09	303 30 09	325 03 40	39	325 03 51	35	83 02	32.710			32.710
39	35	325 03 40	195 30 90					32.708			
39	195 03 90	325 03 40	309 42 57	35	309 43 11	36	98 10	89.113			89.113
35	36	309 42 57	129 42 57					89.111			
35	129 42 57	309 42 57	11 31 50	36	11 32 07	37	97 16	28.796			28.796
36	37	11 31 50	191 31 50					28.796			
35	36	S. D. A.	301 39 50	36	301 35 07	38	99 40	73.633			73.633
36	38	301 39 50	121 39 50								
36	191 31 50	11 31 50	97 10 57	37	97 40 17	39	103 53	71.313			71.313
37	39	97 10 57	227 10 57					71.311			

[illegible]

[illegible]

[illegible]

CERAPAN MATAHARI BAGI AZIMUT

 Penilik Foo Che Yong Hari 27/10/05 Tarikh Bulan Tahun

 Stesen 31 T.R. 1 B.K. Ms. Tiodolait (jenis) I Bah. Aras Ufuk - a

Formula:

$$\text{Kosain AZIMUT} = \frac{\text{Kos } P - \text{Sain } \phi \text{ Sain } \alpha}{\text{Kos } \phi \text{ Kos } \alpha}$$

$$\text{Pembetulan Aras} = \frac{a}{8} (\pm R - \pm L) \text{ tenjen } \alpha$$

Waktu		Ufuk			Gelem-bong		Pugak			Titikan ①	Bila waktu jam tangan tidak dalam lingkungan 3 menit daripada waktu piawai Hitung waktu umum.			W.U. = 12 ^h + W.T.K. - G. Bujur - E		
J	m	P.Ki	T.R	300	00	00	Ki	Ka						12 ^h	00 ^m	
8 ⁰⁷		⊕		106	51	16		75	75	16						
		⊖		106	19	50		75	20	09						
		P.Ka	⊖	286	21	47		287	49	15						
8 ¹⁶		⊕		286	57	07		285	00	02						
Purata ①		T.R		120	00	00										
J	m															
								17	37	13	Purata Tinjau					
								3	1		Biasan & Bedalihat Tinjau Dilaras					
J	m	P.Ki	T.R													
8 ¹⁷		⊕		106	58	42		77	47	13						
		⊖		106	26	55		77	32	40						
		P.Ka	⊖	286	29	05		285	42	17						
8 ¹⁷		⊕		287	07	28		285	55	27						
Purata ②		T.R														
J	m															
								15	37	26	Purata Tinjau					
								3	01		Biasan & Bedalihat Tinjau Dilaras					
								15	31	25						
Kordinat Origin U/S	55961			m			Kordinat Origin 1/B	27759			m			Purata Bg. Gerid T.R.		
Stesen U/S	7852			m			Stesen T/B	5665			m			Ditilik oleh		
Jumlah/Sel.	1/5 51309			m			Jumlah/Sel.	T/B 27727			m			Dihitung oleh		
Jumlah/Sel. x 0.03256 ±	27			51			Sel. G. Bujur = $\frac{\text{Jum. Sel.}}{\text{Sel.}}$ x 0.03246 ±	14'50"						Tarikh		
G. Lintang Origin U	3			48			Sel. G. Bujur x Sain G. Lintang -									
G. Lintang Stesen U	3			12			T (-) / B (+) Tiruan	- 50'								

 P.Ki - Penyilang Kiri
 P.Ka - Penyilang Kanan

 T.R. - Tanda Rujuk
 Sel - Selisih

 W.U. - Waktu Umum
 W.T.K. - Waktu Tempatan Ketara

No. Fail

Stesen

Penyilang Kiri

BEARING / SUDUT

Penyilang Kanan

Purata

Dari

Stn.

GARISAN

Bearing Mukamat

Ke

Stn.

Sudut Pukak

50(±)

PA 12561

Rajah di muka

Jarak

Suhu


Jarak

Antara

Tupang


Jarak Mukamat

DAERAH GOMBAK
 BANDAR HULU KELANG.
 SEKSYEN Z
 TANPA SKALA

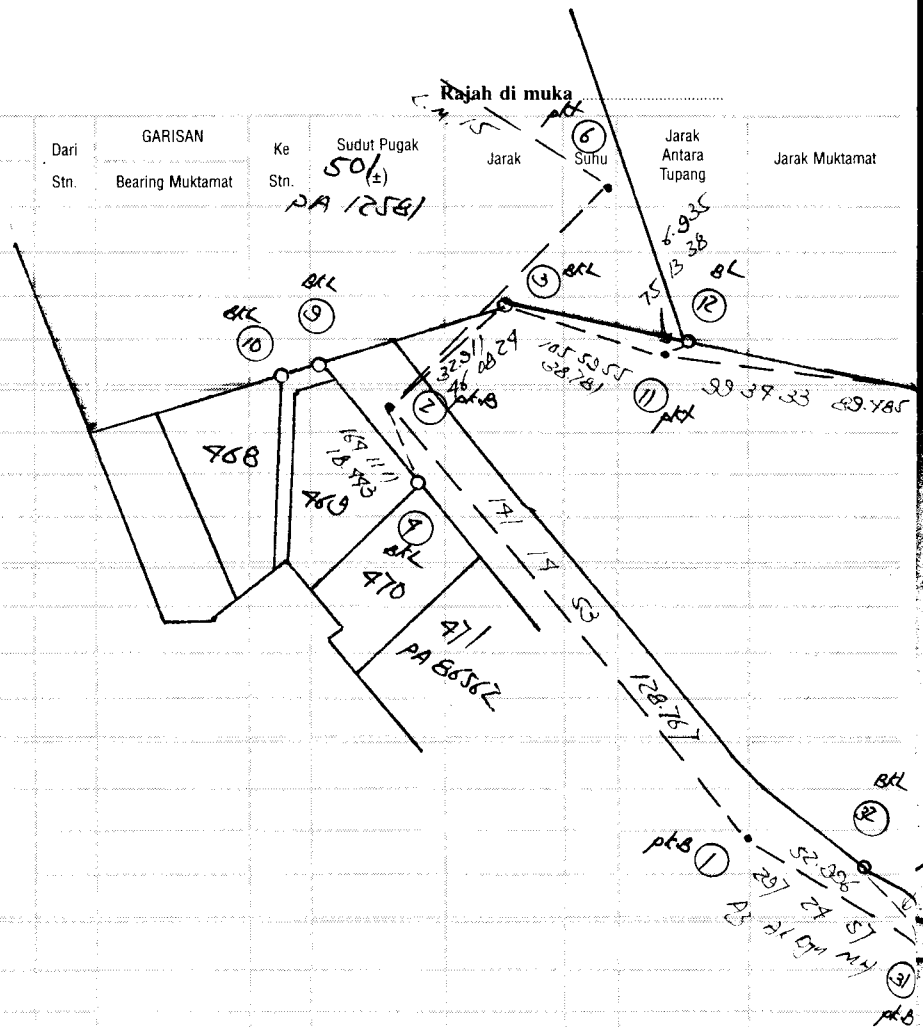


No. Fail

Rajah di muka

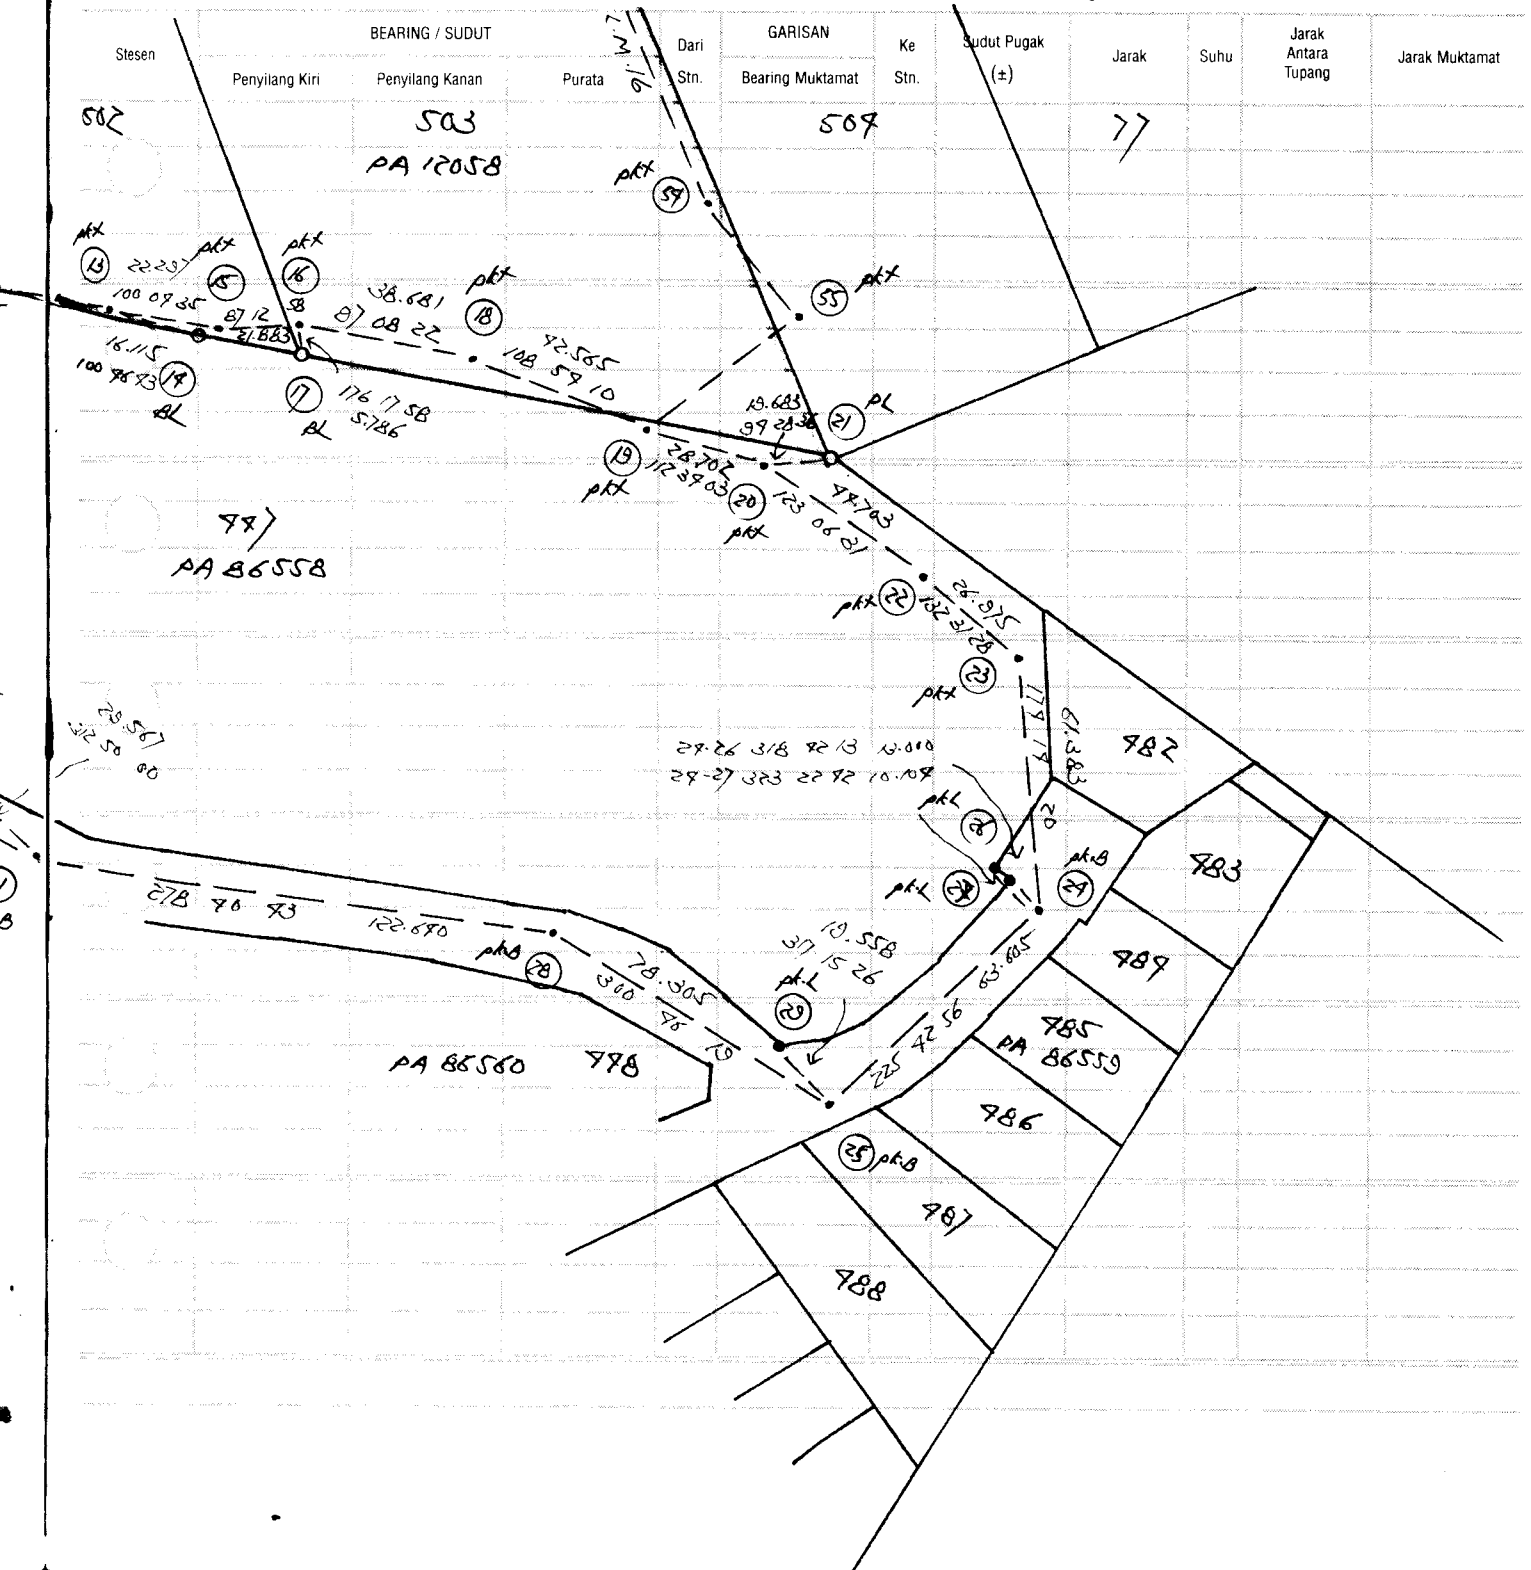

No. Fail

Rajah di muka

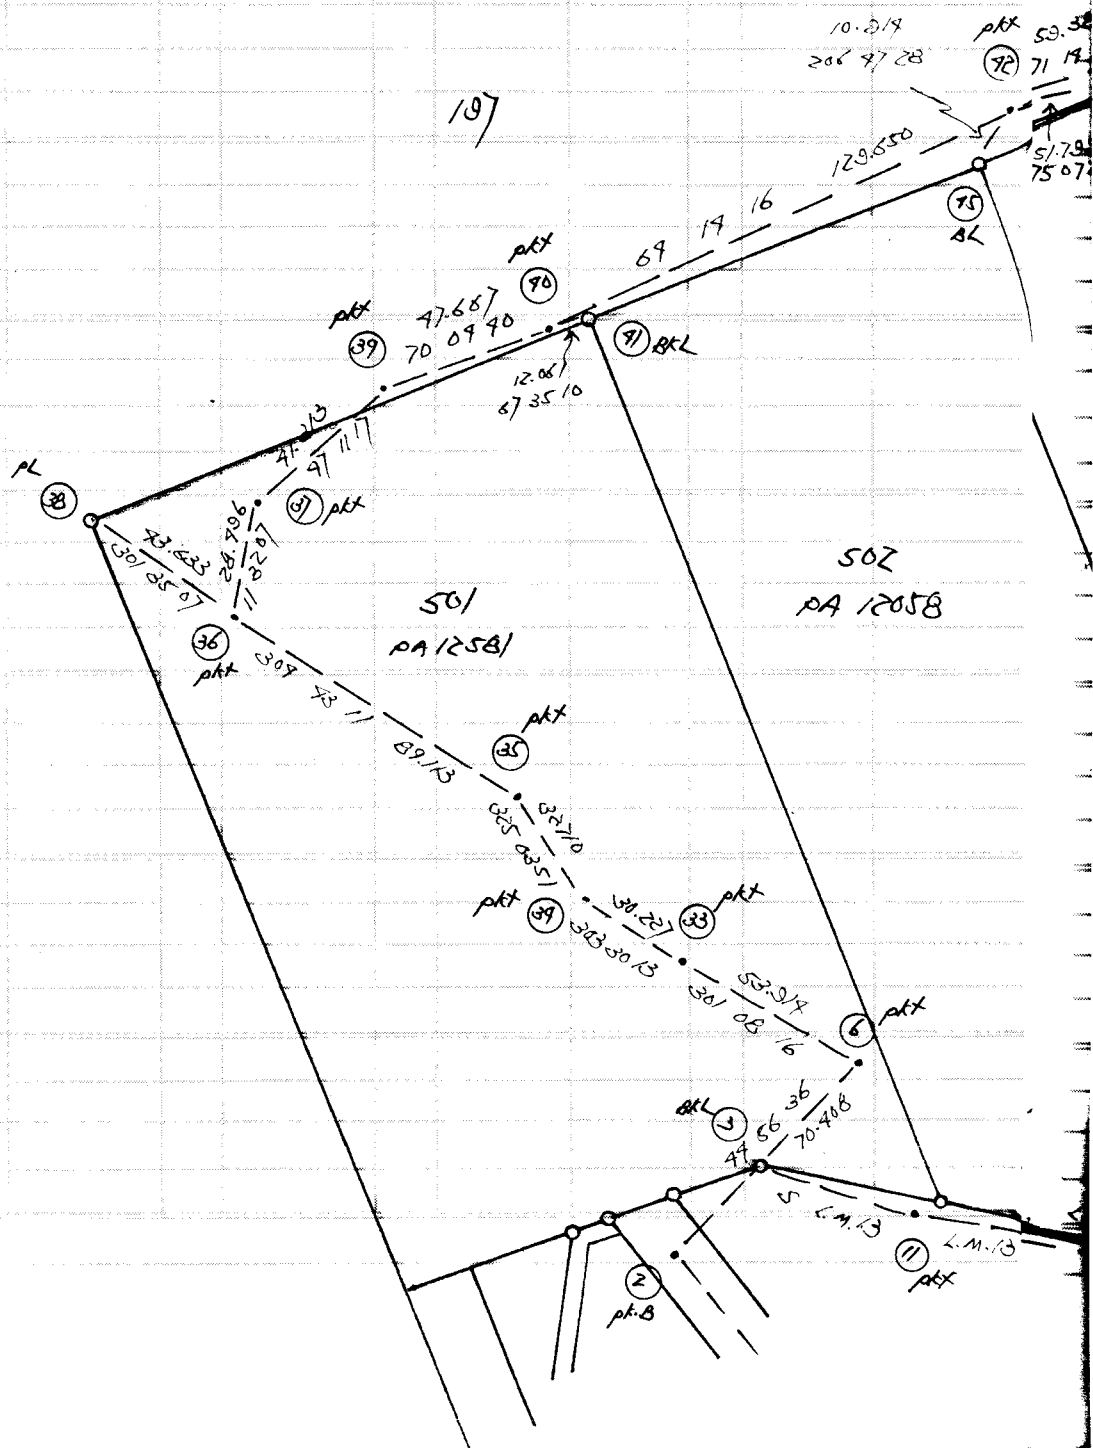[illegible]

No. Fail

Rajah di muka

