

WP113 kg Batu Muda

Rajah Minda

26/4/09

Datun Danipada PA 1830/55

2  
pk.B

1830/55

1  
BKL

4

70.270

70.270

2-3 1852752

2 1852752

3

4

8.393

BKL

8.393

2-4 1225917

2 1225917

4

4

16.787

BKL

16.787

2-5 1625822

2 1625822

5

4

72.701

BKL

72.701

1 1830/55 30/55 2777957

2

2777957

6

4

55.612

55.612

2

Aj Ak.

6 2777957 09 7957

Aj MY

pk.B

2 09 7957 2777957 2 7559

6

2 7559

7

4

55.317

55.317

6

7 27559 1827559

pk.B

2 Sprit. Di Atas 1775153

6

1775153

8

4

128.006

128.006

6

8 1775153 3575153

pk.

6 3575153 1775153 1773397

8

1773397

9

4

106.620

106.620

8

9 1773397 2773397

pk.

8 3573397 1773397 271690

9

271690

10

4

32.792

32.792


9

10 271690 371690

BKL

WILAYAH PERSEKUTUAN  
MUKIM BATU  
0959  
TANPA SKALA

|      |           |           |
|------|-----------|-----------|
| 1-10 | 197 52 05 | 222.625 N |
|      | 197 50 47 | 222.60300 |
|      | 11 18"    | 70.022    |
| 3-10 | 193 18 47 | 253.852 N |
|      | 193 17 26 | 253.82800 |
|      | 71 21"    | 70.029    |

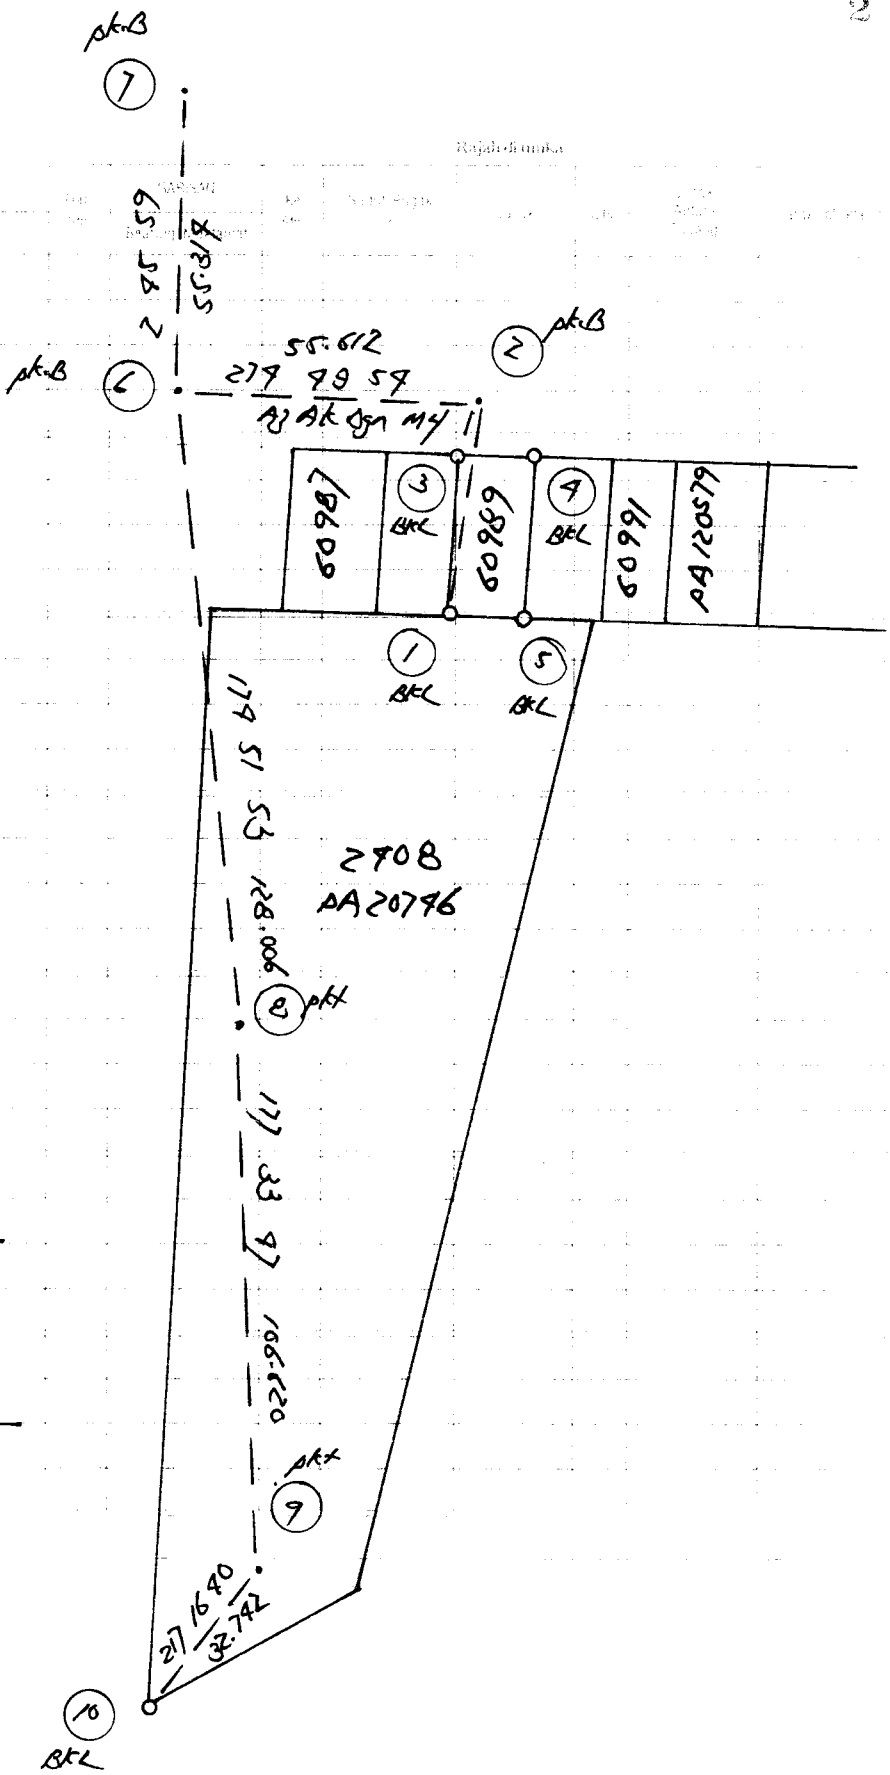

Tarikh

20/13

Aras

Dibuat untuk

10

Daripada

Wajah Kg Batu Muda

Ke

| Pandangan Belakang | Pandangan Antara | Pandangan Hadapan | Naik | Turun | Aras Yang Dilaras |
|--------------------|------------------|-------------------|------|-------|-------------------|
|--------------------|------------------|-------------------|------|-------|-------------------|

1. 938 (972) 1. 950 (976) 43.702

1. 606 (5.27) 1. 950 (976)

1. 829 (6.00) 1. 660 (5.95)

1. 699 (5.90) 1. 357 (9.45)

1. 776 (5.83) 1. 730 (5.68)

1. 867 (6.13) 1. 820 (5.97)

1. 567 (5.18) 1. 608 (5.28)

1. 2000 (11.227) 1. 906 (9.61) 49.398

1. 906 (6.61) 1. 360 (9.96)

2. 019 (5.2) 1. 520 (9.99)

1. 588 (5.90) 1. 530 (5.02)

1. 799 (6.08) 1. 301 (9.27)

1. 859 (9.92) 1. 566 (5.18)

1. 500 (9.70) 1. 797 (5.90)


1. 933 (6.28) 1. 669 (5.86)

1. 913 (5.09) (9.99)

1. 3.507 12.292 45.663

CR12 m/s 15 Catilang 20/07

TBM F/1946 RC: 43.702 sek. man kub Batu muda

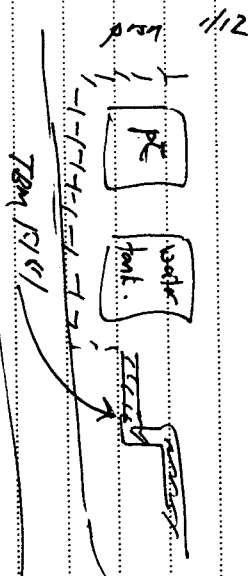

Pusat kegiatan masyarakat  
Jemas.  
Kg Sri Batu.

TBM F/1611

TBM F/1612

