

No. Fail

Rajah di muka

Stesen	BEARING / SUDUT			Dari Stn.	GARISAN Bearing Mukamat	Ke Stn.	Sudut Pukak (±)	Jarak	Suhu	Jarak Antara Tupang	Jarak Mukamat
	Penyilang Kiri	Penyilang Kanan	Purata								

DAERAH UKU LAMPAH
BANDAR CHERAS
SEKSYEN 1
TAHAP SKACA

2836

3/56
PA 30693

7-10 290 42 15 116.283 N
 290 41 51 116.289 PO
 +29" +0.001

7-11 238 36 18 55.719 N
 238 35 36 55.708 PO
 +42" +0.006

23/05


352
PA 52092

10 364 270 37 59
 55.001

No. Fail

Rajah di muka

Stesen	BEARING / SUDUT			Dari	GARISAN	Ke	Sudut Pukak	Jarak	Suhu	Jarak Antara Tupang	Jarak Mukamat
	Penyilang Kiri	Penyilang Kanan	Purata	Stn.	Bearing Mukamat	Stn.	($\pm$)				

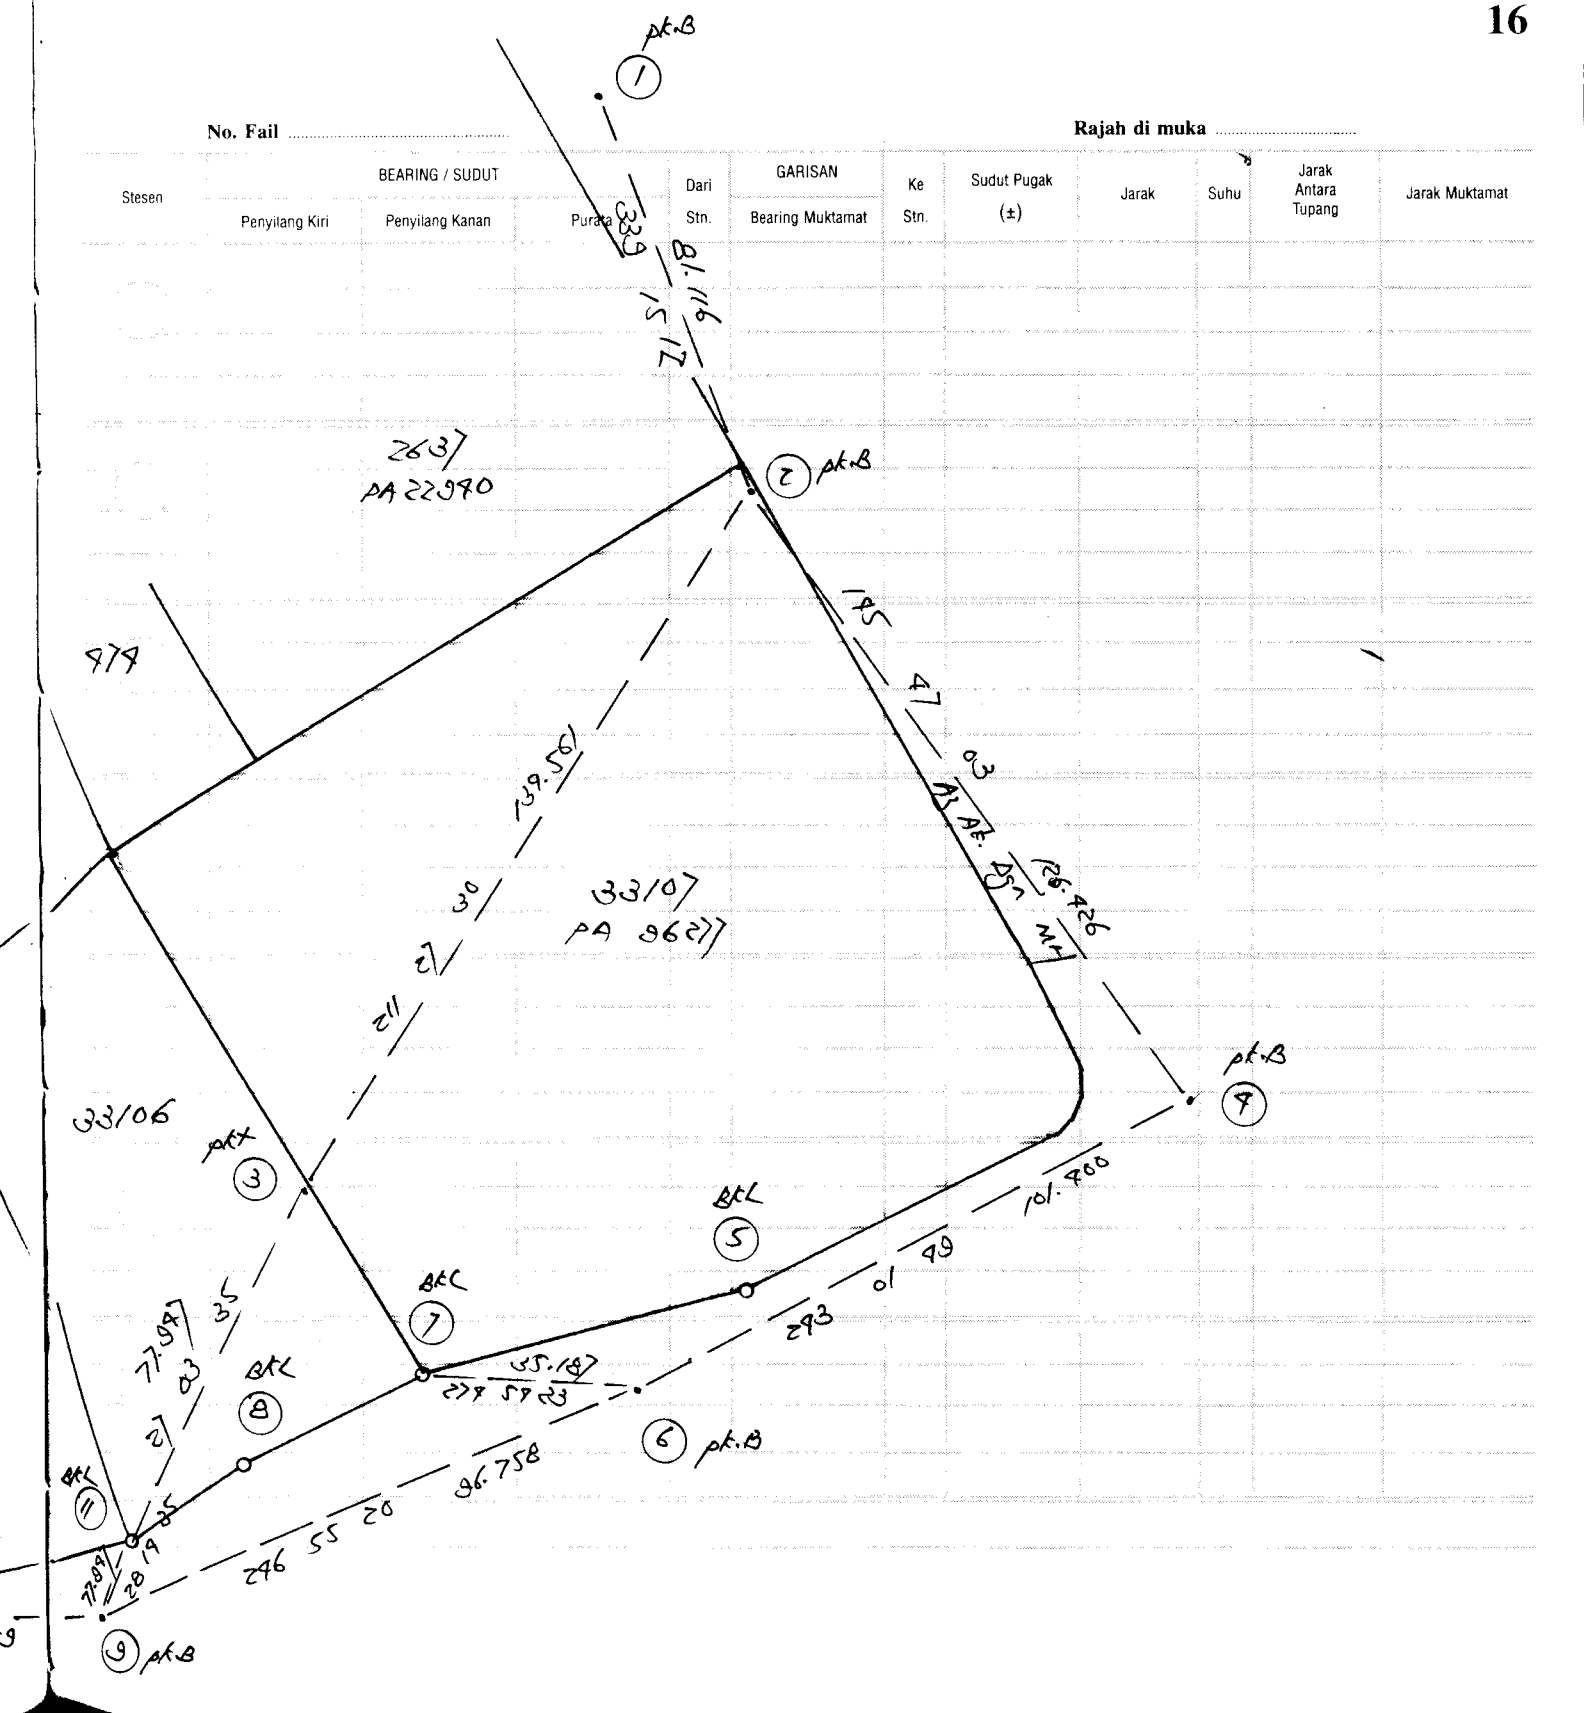

CERAPAN MATAHARI BAGI AZIMUT

 Penilik Roo Chae Yng. Hari Sabtu Tarikh 18/2/06 Bulan Februari Tahun 2006

 Stesen Z T.R. 7 B.K. Ms. Tiodolait (Jenis) I Bah. Aras Ufuk - 2

Formula:

$$\text{Kosain AZIMUT} = \frac{\text{Kos } P - \text{Sain } \phi \text{ Sain } \alpha}{\text{Kos } \phi \text{ Kos } \alpha}$$

$$\text{Pembetulan Aras} = \frac{2}{3} (\pm R - \pm L) \text{ tenjen } \alpha$$

Waktu		Ufuk			Gelem-bong		Pugak			Tilikan ①	Bila waktu jam tangan tidak dalam lingkungan 3 menit daripada waktu pawai Hitung waktu umum.			W.U. - 12 ^J + W.T.K. - G. Bujur - E			
J	m	P.Ki	T.R	15'	31'	50'	Ki	Ka						12 ^J	00 ^m		
			⊕	109	37	38		70	20	22							
			⊖	109	03	50		70	16	76							
		P.Ka	⊖	289	05	06		289	51	30							
			⊕	289	40	27		289	56	77							
Purata ①		T.R															
J	m																
851								19	77	77	Purata Tinjau						
		Purata Ke matahari		109	21	75		2	18		Biasan & Bedalihat						
		Purata Ke TR						19	75	29	Tinjau Dilaras						
J	m	P.Ki	T.R														
			⊕	109	71	75		09	52	47							
			⊖	109	07	58		09	75	59							
		P.Ka	⊖	289	09	30		290	22	32							
			⊕	289	75	27		290	31	09							
Purata ②		T.R															
J	m																
								20	18	76	Purata Tinjau						
		Purata Ke matahari		109	28	10		2	13		Biasan & Bedalihat						
		Purata Ke TR						20	16	33	Tinjau Dilaras						
Kordinat Origin U/S		55961			m		Kordinat Origin T/B		27759			m		Purata Bg. Gerid T.R.		175 77 03	
Stesen U/S		15860			m		Stesen T/B		0739			m		Ditilik oleh		18/2/06.	
Jumlah/Sel.		71621			m		Jumlah/Sel.		28798			m		Dihitung oleh		M-5°49'47"	
Jumlah/Sel. × 0.03256 ±		0 38 52					Sel. G. Bujur - $\frac{\text{Jum.}}{\text{Sel.}} \times 0.03246 \pm$		15'25"								
G. Lintang Origin U		3 70 79					Sel. G. Bujur × Sain G. Lintang -										
G. Lintang Stesen U		3 01 57					T (-) / B (+) Tirisan -		79"								

 P.Ki. - Penyilang Kiri
 P.Ka. - Penyilang Kanan

 T.R. - Tanda Rujuk
 Sel - Selisih

 W.U. - Waktu Umum
 W.T.K. - Waktu Tempatan Ketara

Tarikh 18/2/06

Aras

Dibuat untuk

67

Daripada

500000 Chuan Coorvare.

Ke

Pandangan Belakang	Pandangan Antara	Pandangan Hadapan	Naik	Turun	Aras Yang Dilaras	Jarak	Catitan
1.739 (15.69)					38.099		57m x 19 (m/551)
1.952 (14.77)	1.979 (13.69)						78m 5250/1
1.531 (15.02)	1.352 (14.49)						
1.538 (15.09)	1.083 (13.58)						
1.716 (15.63)	1.125 (13.69)						
1.363 (14.97)	1.245 (14.09)						
1.495 (14.79)	1.365 (14.48)						
1.208 (13.96)	1.587 (15.2)						
1.339 (14.38)	1.909 (14.62)						
1.310 (14.36)	1.300 (14.22)						
1.908 (14.62)	1.906 (14.61)						
1.315 (14.32)	1.411 (14.63)						
1.369 (14.42)	1.598 (15.08)						
0.906 (12.97)	1.485 (14.64)						78m x 1 nail on top of division
1.013 (13.33)	1.609 (15.26)						Divided side from Chuan's side
1.331 (14.36)	1.619 (15.3)						
2.061 (16.76)	1.031 (13.38)						
2.896 (19.39)	0.128 (10.82)						
	0.105 (10.35)				38.632		901
26.815		22.20					

Tarikh Aras

Dibuat untuk

Daripada

Ke

Pandangan Belakang	Pandangan Antara	Pandangan Hadapan	Naik	Turun	Aras Yang Dilaras	Jarak	Cahtian
3.236 (10.65)					38.632		
3.693 (11.95)		0.232	(10.76)				
0.383 (1.43)		1.790	(5.88)				
		1.263	(4.19)		42.569 A9		
7.222/		3.285/					
1.263 (4.19)					42.569 79		
0.839 (2.75)		2.295	(7.53)		41.537 79		
	0.625 (2.05)				41.751 7801A2		
0.066 (2.19)		2.508	(8.23)		39.868 78		
0.903 (2.97)		2.623	(8.6)		37.911 79		
1.793 (5.71)		1.783 (5.71)			37.071 79		
0.968 (3.14)		2.846 (9.37)			35.868 79		
1.122 (3.68)		2.966 (8.16)			39.868 79		
		0.905 (2.97)			39.663 79		
1.320 (4.33)					37.071 79		
1.377 (4.52)		1.868 (6.13)			36.523 79		
	0.182 (0.66)				37.718 571A2		
	0.174 (0.57)				37.726 7801A1		
		1.663 (5.75)			36.237 571A1		

total : 38.632