

25

No. Fail

WA038


Menam Manis (car park)

Rajah di muka

Stesen	BEARING / SUDUT			Dari Stn.	GARISAN Bearing Mukamat	Ke Stn	Sudut Pukak (±)	Jarak	Suhu	Jarak Antara Tupang	Jarak Mukamat
	Penyilang Kiri	Penyilang Kanan	Purata								
1	Jatun Langada	3353535	2	3353535	1	4	47.769	17/11/03		47.769	
2	PA 14-10262B			pt.B							
1	3353535 1553535	163 2257	2	163 2257	3	4	50.078			50.078	
2											
3	163 2257 343 2257	163 2257		pt.C							
1	Seperti Di Atas	223 2125	2	223 2125	7	4	115.808			115.808	
2											
4	223 2125 73 2125			pt.C							
1	Seperti Di Atas	236 5732	2	236 5732	5	4	115.726			115.726	
2				Aj Ab.							
5	236 5732 56 5732			Sgn MY							
				pt.B				115.723			
2	56 5732 236 5732		5		6	4	96.178			96.178	
5											
6	152 1330 332 1330										

No. Fail.

Rajah di muka

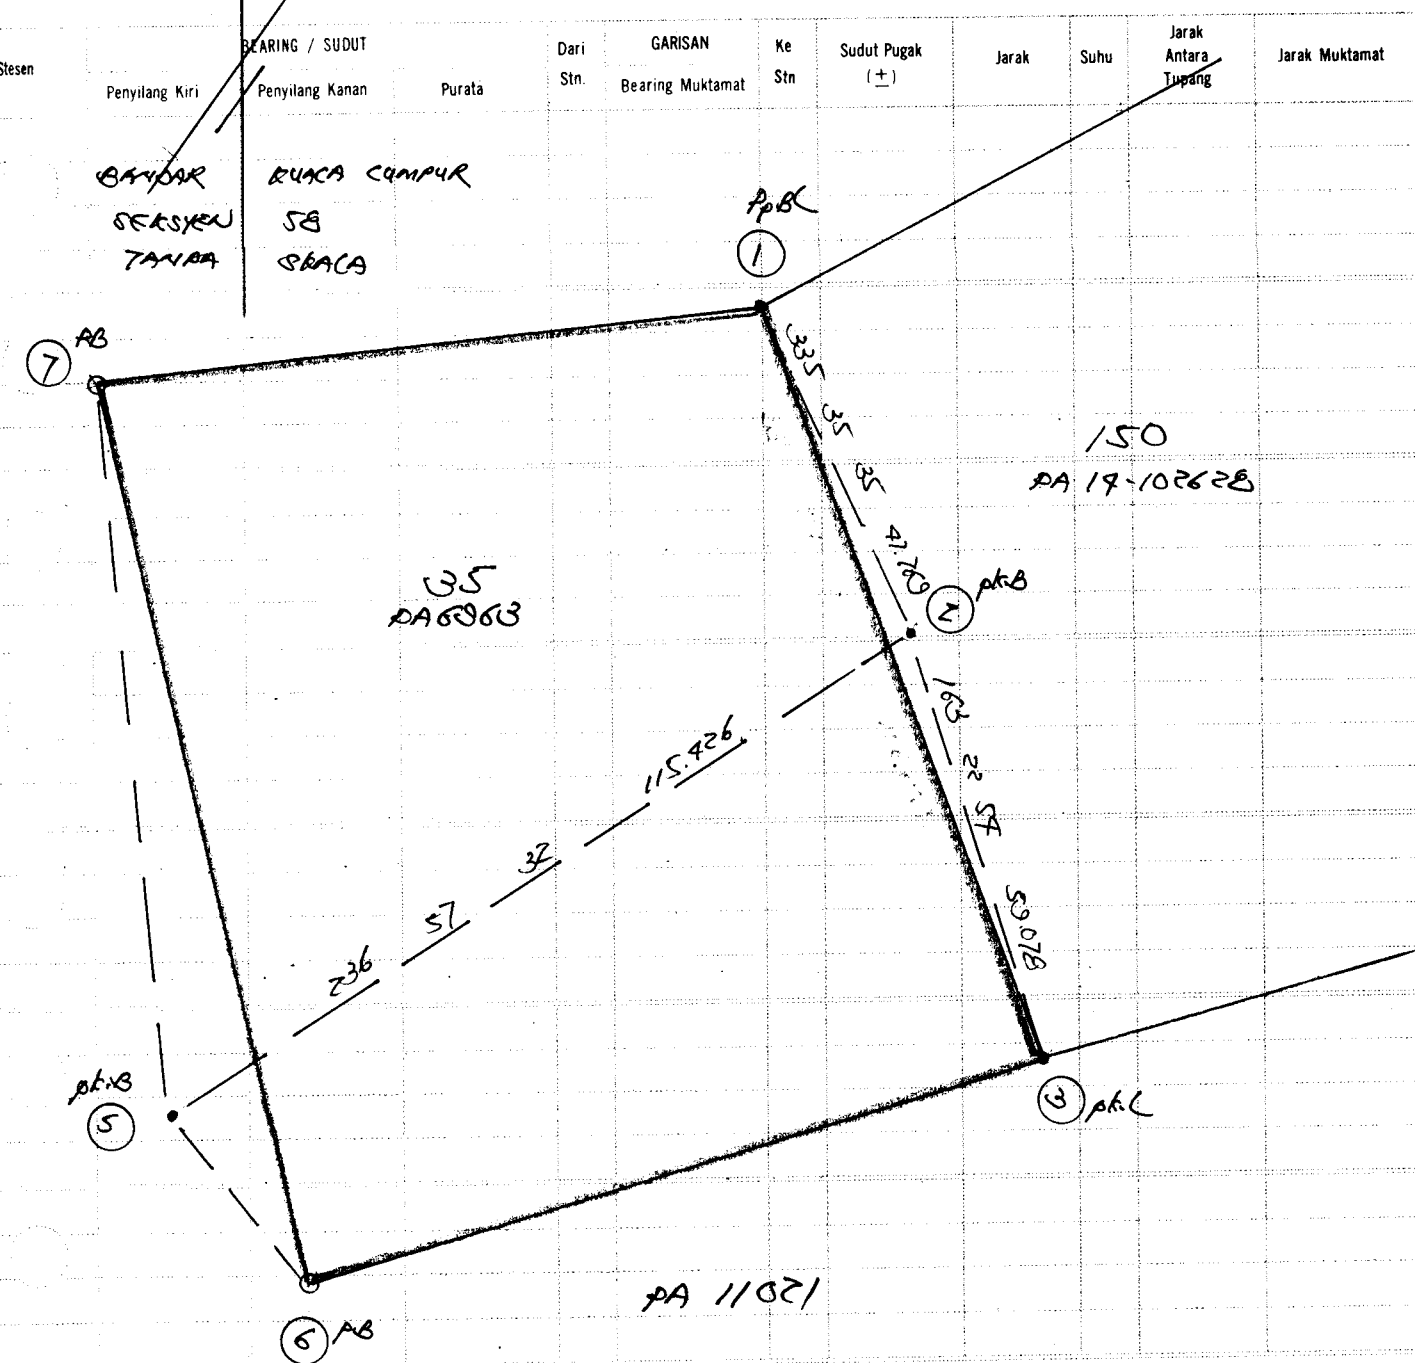

No. Fail *NP038 KCC The Pioneer Car Park.*

Rajah di muka

Stesen	BEARING / SUDUT			Dari Stn.	GARISAN Bearing Muktamad	Ke Stn.	Sudut Pukak (±)	Jarak	Suhu	Jarak Antara Tupang	Jarak N
	Penyilang Kiri	Penyilang Kanan	Purata								
	DATUM DARIPADA										
2	PC BEARING.										
	Datum Daripada			2	236 57 32	5	4	115.829			115.
	RB 26 m/s 25 R9										
								115.829	11/8/05		
5	236 57 32	56 57 32	228 01 07	2	228 01 07	100	4	85.337			85
2								85.333			
	100 228 01 07 RB 01 07										
	pk-B										
5	Sports Di Atas	173 37 28	2	173 37 28	101	4		80.956			80.
2								80.957			
	101 173 37 28 353 37 28										
	pk-B										
2	353 37 28	173 37 28	155 47 22	101	155 47 22	102	4	23.706			23.
101											
	102 155 47 22 335 47 22										
	ApBL										
2	Sports Di Atas	169 09 33	101	169 09 33	103	4		19.086			19.
101											
	103 169 09 33 379 09 33										
	ApBL										
2	Sports Di Atas	156 40 07	101	156 40 07	107	4		73.729			73.
101											
	107 156 40 07 336 40 07										
	BKL										

[illegible]

No. Fail

Rajah di muka

