

PK006 Giant Menjung


Rajah di muka

[illegible]

No. Fail

Rajah di muka

[illegible]

 

[illegible]

No. Fail

Rajah di muka

Stesen

BEARING / SUDUT

Dari
Stn.

GARISAN

Bearing Muktamat

Ke
Stn.Sudut Pukak
(±)

Jarak

Suhu

Jarak
Antara
Tupang

Jarak Muktamat

Penyilang Kiri

Penyilang Kanan

Purata

DAERAH MANKUNG.

MUKIM CUMUT


5417 779 $\frac{916}{24}$

TANDA SKALA

13-27	109 5117	1036.159 ~
	109 51 73	1036.651 PO
	-28"	-0.997

13-20	219 37 40	780.202 ~
	219 33 57	780.765 PO
	+52"	-0.203

20-27	167 91 36	377.389 ~
	167 95 00	377.920 PO
	-329"	-0.031

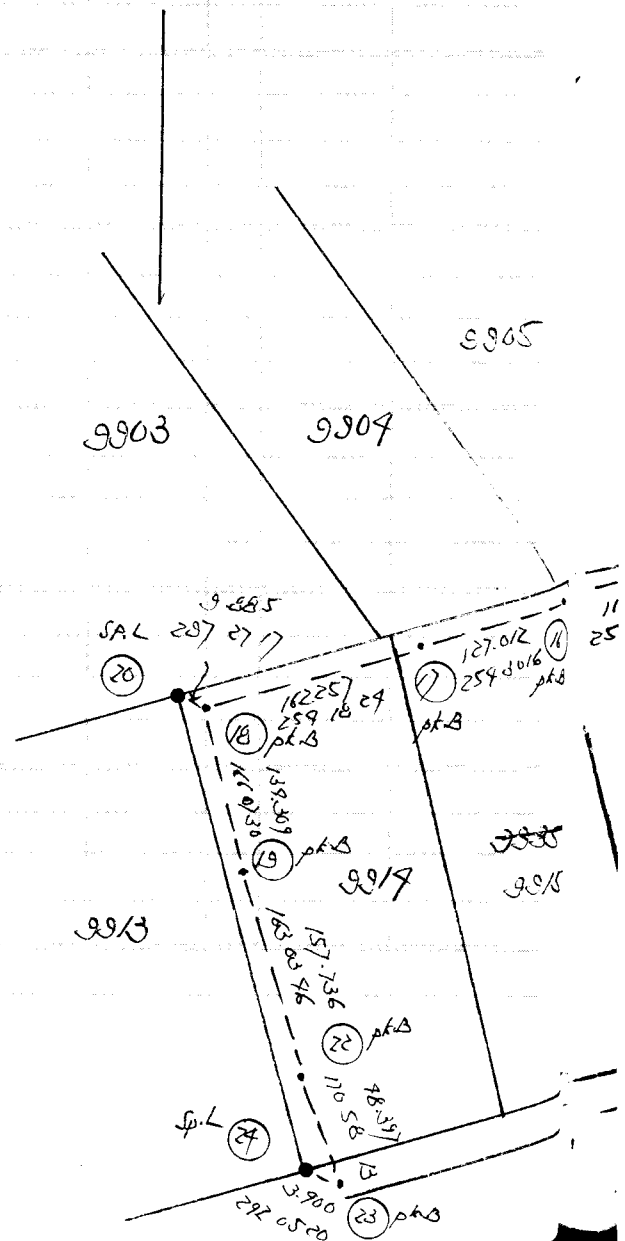

[illegible]

