

W0092

No. Fail

Sital Bakgia

Rajah di muka

Stesen	BEARING / SUDUT			Dari Stn.	GARISAN		Ke Stn.	Sudut Pukak (±)	Jarak	Suhu	Jarak Antara Tupang	Jarak Mukamat
	Penyilang Kiri	Penyilang Kanan	Purata		Bearing Mukamat							
	Sg. Jantun Saripack SA		97 12 29	2	pt.B		1	4	22.760	10/9/07		22.760
2	1	97 12 29 277 12 29	199 93 52	2			3	4	8.883			8.883
	3	199 93 52 229 93 52										
		AKL										
2	1	Sg. Ti Di Atas	210 06 33	2			7	4	19.032			19.032
	7	210 06 33 30 06 33										
		Sg. L										
2	1	Sg. Ti Di Atas	226 93 39	2			5	4	19.919			19.919
	5	226 93 39 76 93 39										
		Sg. L										
2	1	Sg. Ti Di Atas	236 15 46	2			6	4	35.589			35.589
	6	236 15 46 56 15 46										
		Sg. L										
2	1	Sg. Ti Di Atas	176 92 06	2			7	4	76.017			76.017
	7	176 92 06 356 92 06							76.018			
		pt.B										
2	356 92 06	176 92 06 159 90 13	7				8	4	61.320			61.320
7	8	159 90 13 339 90 13							61.323			
		pt.B										

[illegible]

Rajah di muka

Stesen	BEARING / SUDUT	Dari	GARISAN	Ke	Sudut Pukak	Jarak	Suhu	Jarak Antara Tumpang	Jarak Mukamat
	Penyilang Kiri	Penyilang Kanan	Purata	Stn.	Bearing Mukamat	Stn.	(±)		
8	2823325	1023325	2793012	9		16	H	13.798	13.798
9	16	3293012	1993012						
		pt.L ←							
8	Seperti Di Atas	3383150	9			17	H	11.798	11.798
9	17	3383150	1583150						
		pt.L ←							
8	Seperti Di Atas	1318339	9			18	H	6.799	6.799
9	18	1318339	1931839						
		pt.L							
8	Seperti Di Atas	1951220	9			19	H	29.512	29.512
9	19	1951220	151220						
		PL							
8	Seperti Di Atas	1881605	9			20	H	39.610	39.610
9	20	1881605	81605						
		Sp.L							
8	Seperti Di Atas	1903507	9			21	H	39.933	39.933
9	21	1903507	103507						
		BKL							
9	22	22031	981739	22031	15	22	H	39.780	39.780
15	22	22031	1822031						
		Sp.L							

No. Fail

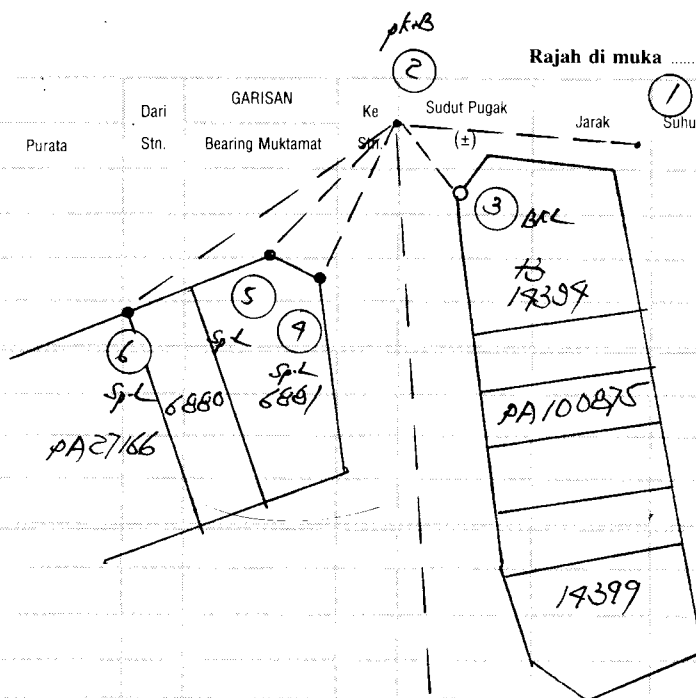
Rajah di muka

Stesen	BEARING / SUDUT			Dari Stn.	. GARISAN Bearing Muktamat	Ke Stn.	Sudut Pugak (±)	Jarak	Suhu	Jarak Antara Tupang	Jarak Muktamat
	Penyilang Kiri	Penyilang Kanan	Purata								
9 15	278 1739	98 1739	2 09 00	15		23	4	33.799			33.789
	23	2 09 00	18 2 09 00								
	Sp.L										
9 15	Seperti Di Atas	0 9 11 8	15			29	4	15.759			15.759
	29	0 9 11 8	18 0 9 11 8								
	Sp.L										
9 15	Seperti Di Atas	350 5130	15			25	4	3.380			3.380
	25	350 5130	170 5130								
	Sp.L										

No. Fail

Rajah di muka *pk.B*

Stesen	BEARING / SUDUT		Dari Stn.	GARISAN Bearing Mukamat	Ke Stn.	Sudut Pagak (±)	Jarak	Suhu /	Jarak Antara Tupang	Jarak Mukamat
	Penyilang Kiri	Penyilang Kanan								

*pk.B*

⑦

28068

28070

6992

PA 27167

pk.B

⑧

⑩

6993

PA 27167

⑫

⑬

pk.L

2560

PA 11132

No. Fail

Rajah di muka

Stesen	BEARING / SUDUT		Dari Stn.	GARISAN Bearing Muklumat	Ke Stn.	Sudut Pugak (±)	Jarak	Suhu	Jarak Antara Tupang	Jarak Muklumat
	Penyilang Kiri	Penyilang Kanan								

WILAYAH PERSEKUTUAN
MUKIM SETAPAK
0758
TANDA SKALA

