

Bkt Daman sara.

WP/02 T/A 1 Setia Bukit 8

Rajah di muka

[illegible]

Rajah di muka

[illegible]

No. Fail

Rajah di muka

Stesen	BEARING / SUDUT			Dari Stn.	GARISAN		Ke Stn.	Sudut Pugak (±)	Jarak	Suhu	Jarak Antara Tupang	Jarak Mukmatat
	Penyilang Kiri	Penyilang Kanan	Purata		Bearing Mukmatat							
13-16	309 97 90			13	309 97 90	16	4	17.918		pk L	17.918	
13-17	289 33 08			13	289 33 08	17	4	15.886		pk L	15.886	
13-18	219 33 28			13	219 33 28	18	4	17.913		pk L	17.913	
15-19	308 59 99			15	308 59 99	19	4	7.039		pk. L	7.039	
15-20	238 35 22			15	238 35 22	20	4	10.766		pk. L	10.766	
19-21	332 17 18			19	332 17 18	21	4	8.502		pk L	8.502	
19-22	302 19 51			19	302 19 51	22	4	79.373		pk L PL	79.373	
19-23	301 57 39			19	301 57 39	23	4	57.123		PL	57.123	
19-24	283 19 32			19	283 19 32	24	4	65.700		BKL	65.700	
19-25	270 06 03			19	270 06 03	25	4	79.912		pk. L	79.912	

No. Fail

Rajah di muka

Stesen

BEARING / SUDAN

Dari

GARISAN

Ke

Sudut Pugak
($\pm$)

Jarak

Suhu

Jarak
Antara
Tupang

Jarak Muktamat

Penyilang Kiri

Penyilang Kana

Purata

Stn.

Bearing Muktamat

Stn.

$$(\pm)$$









253

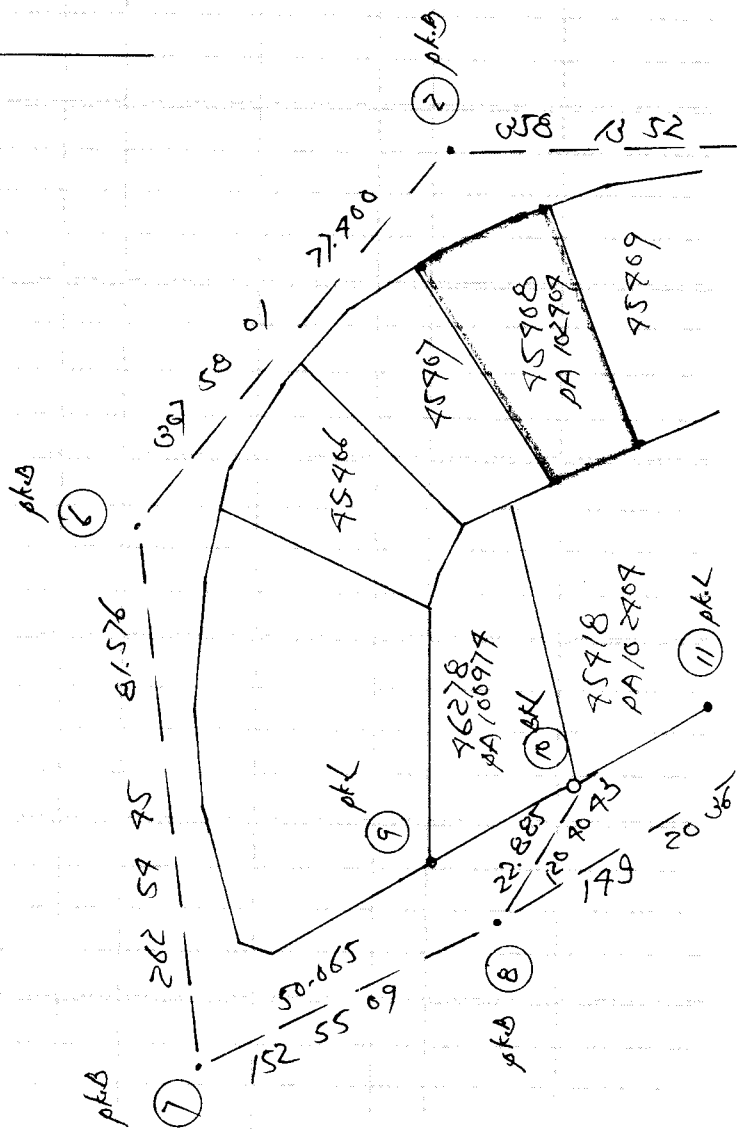

10-22 215 1115 109.732 N
215 1116 109.731 PL
+1" +0.00'

10-20 17/1357 239.320 ✓
17/1357 239.303 p0

3r 40.017

No. Fail

Rajah di muka

Stesen	BEARING / SUDUT		Dari Stn.	GARISAN Bearing Muktamat	Ke Stn.	Sudut Pugak (±)	Jarak	Suhu	Jarak Antara Tupang	Jarak Muktamat
	Penyilang Kiri	Penyilang Kanan								

